


M.S. No 67.  
249'-9" X 40'-8" X 19'-4".  
CLASSED AT LLOYDS + 100 A 1.

SCALE 1:100

MAT. STEEL.

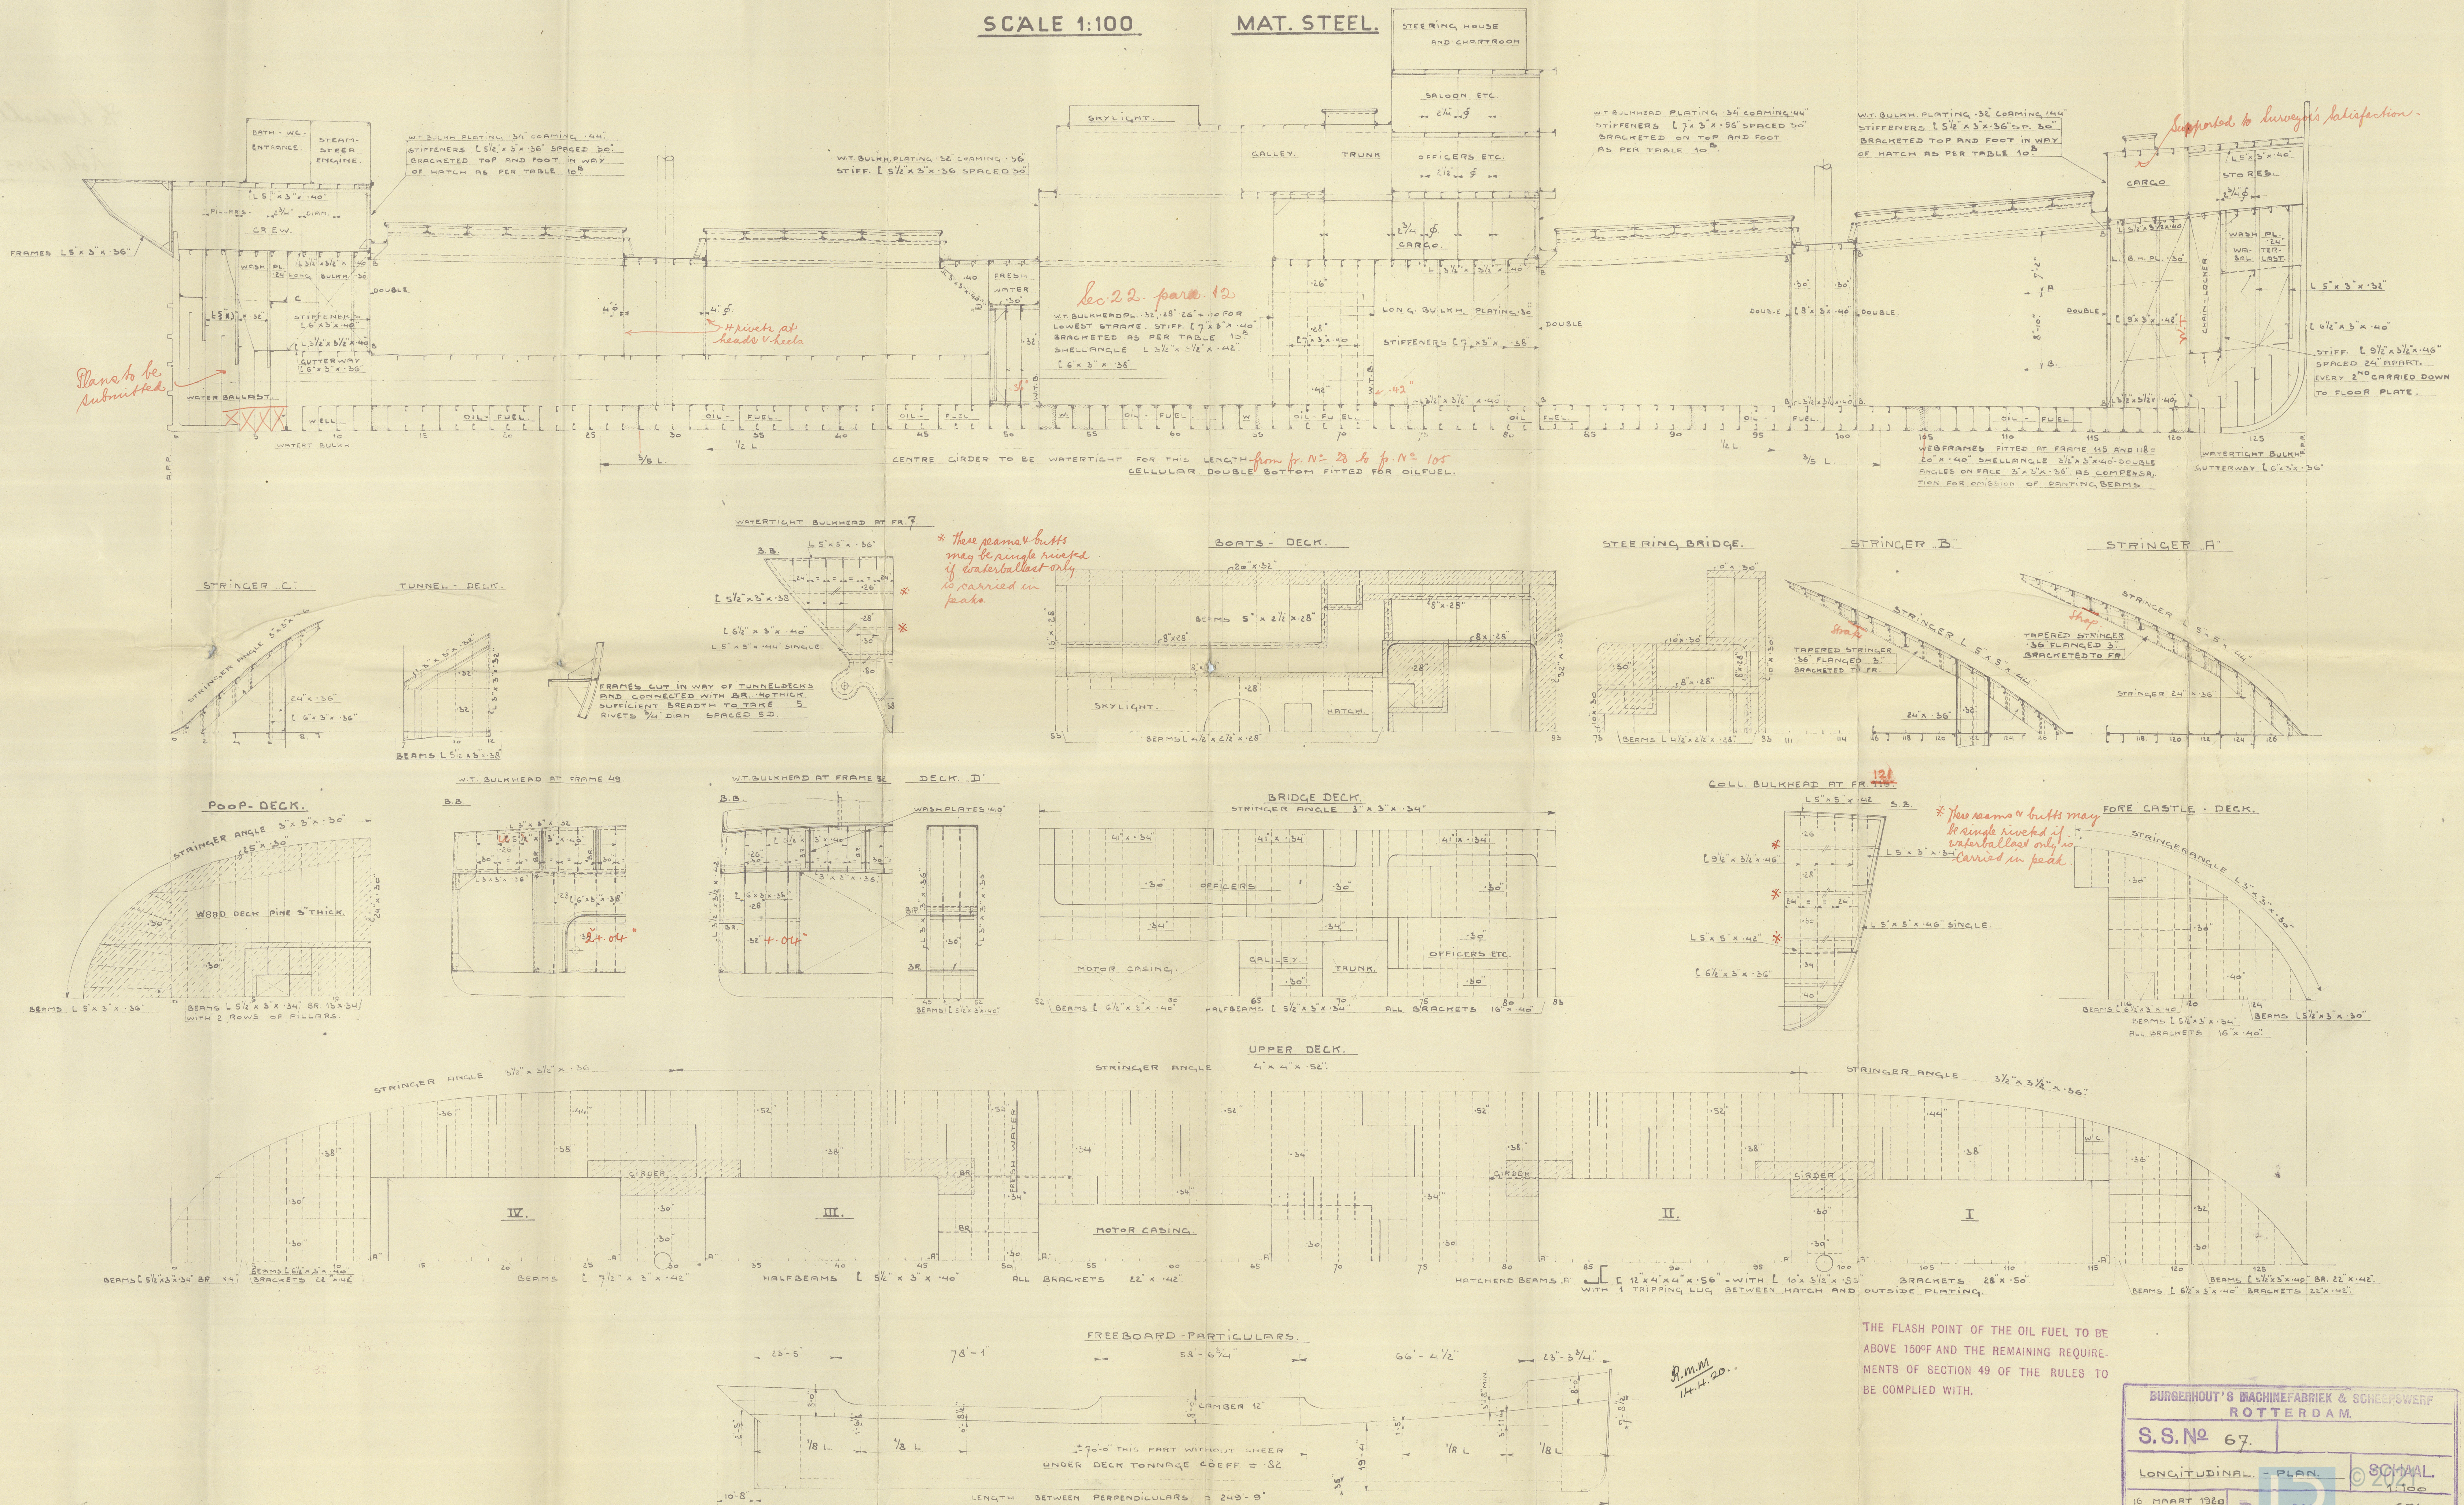



Burgabont

n<sup>o</sup> 67

Profite deserts

~~Gen Box 3157~~

S. Dordrecht

Roth. 12555



© 2021

Lloyd's Register  
Foundation

008804-008811-0221