


18 9 00
58 9 00
3 11 00


- PROFILE AND DECK PLAN -
- T.S.S. N° 358 -
- SCALE 1/8 INCH = 1 FOOT -
- DIMENSIONS 230' x 42' x 13'-6" MLD. -
- VESSEL FOR RIVER PURPOSES -

SEP 1900
PORT-GLASGOW

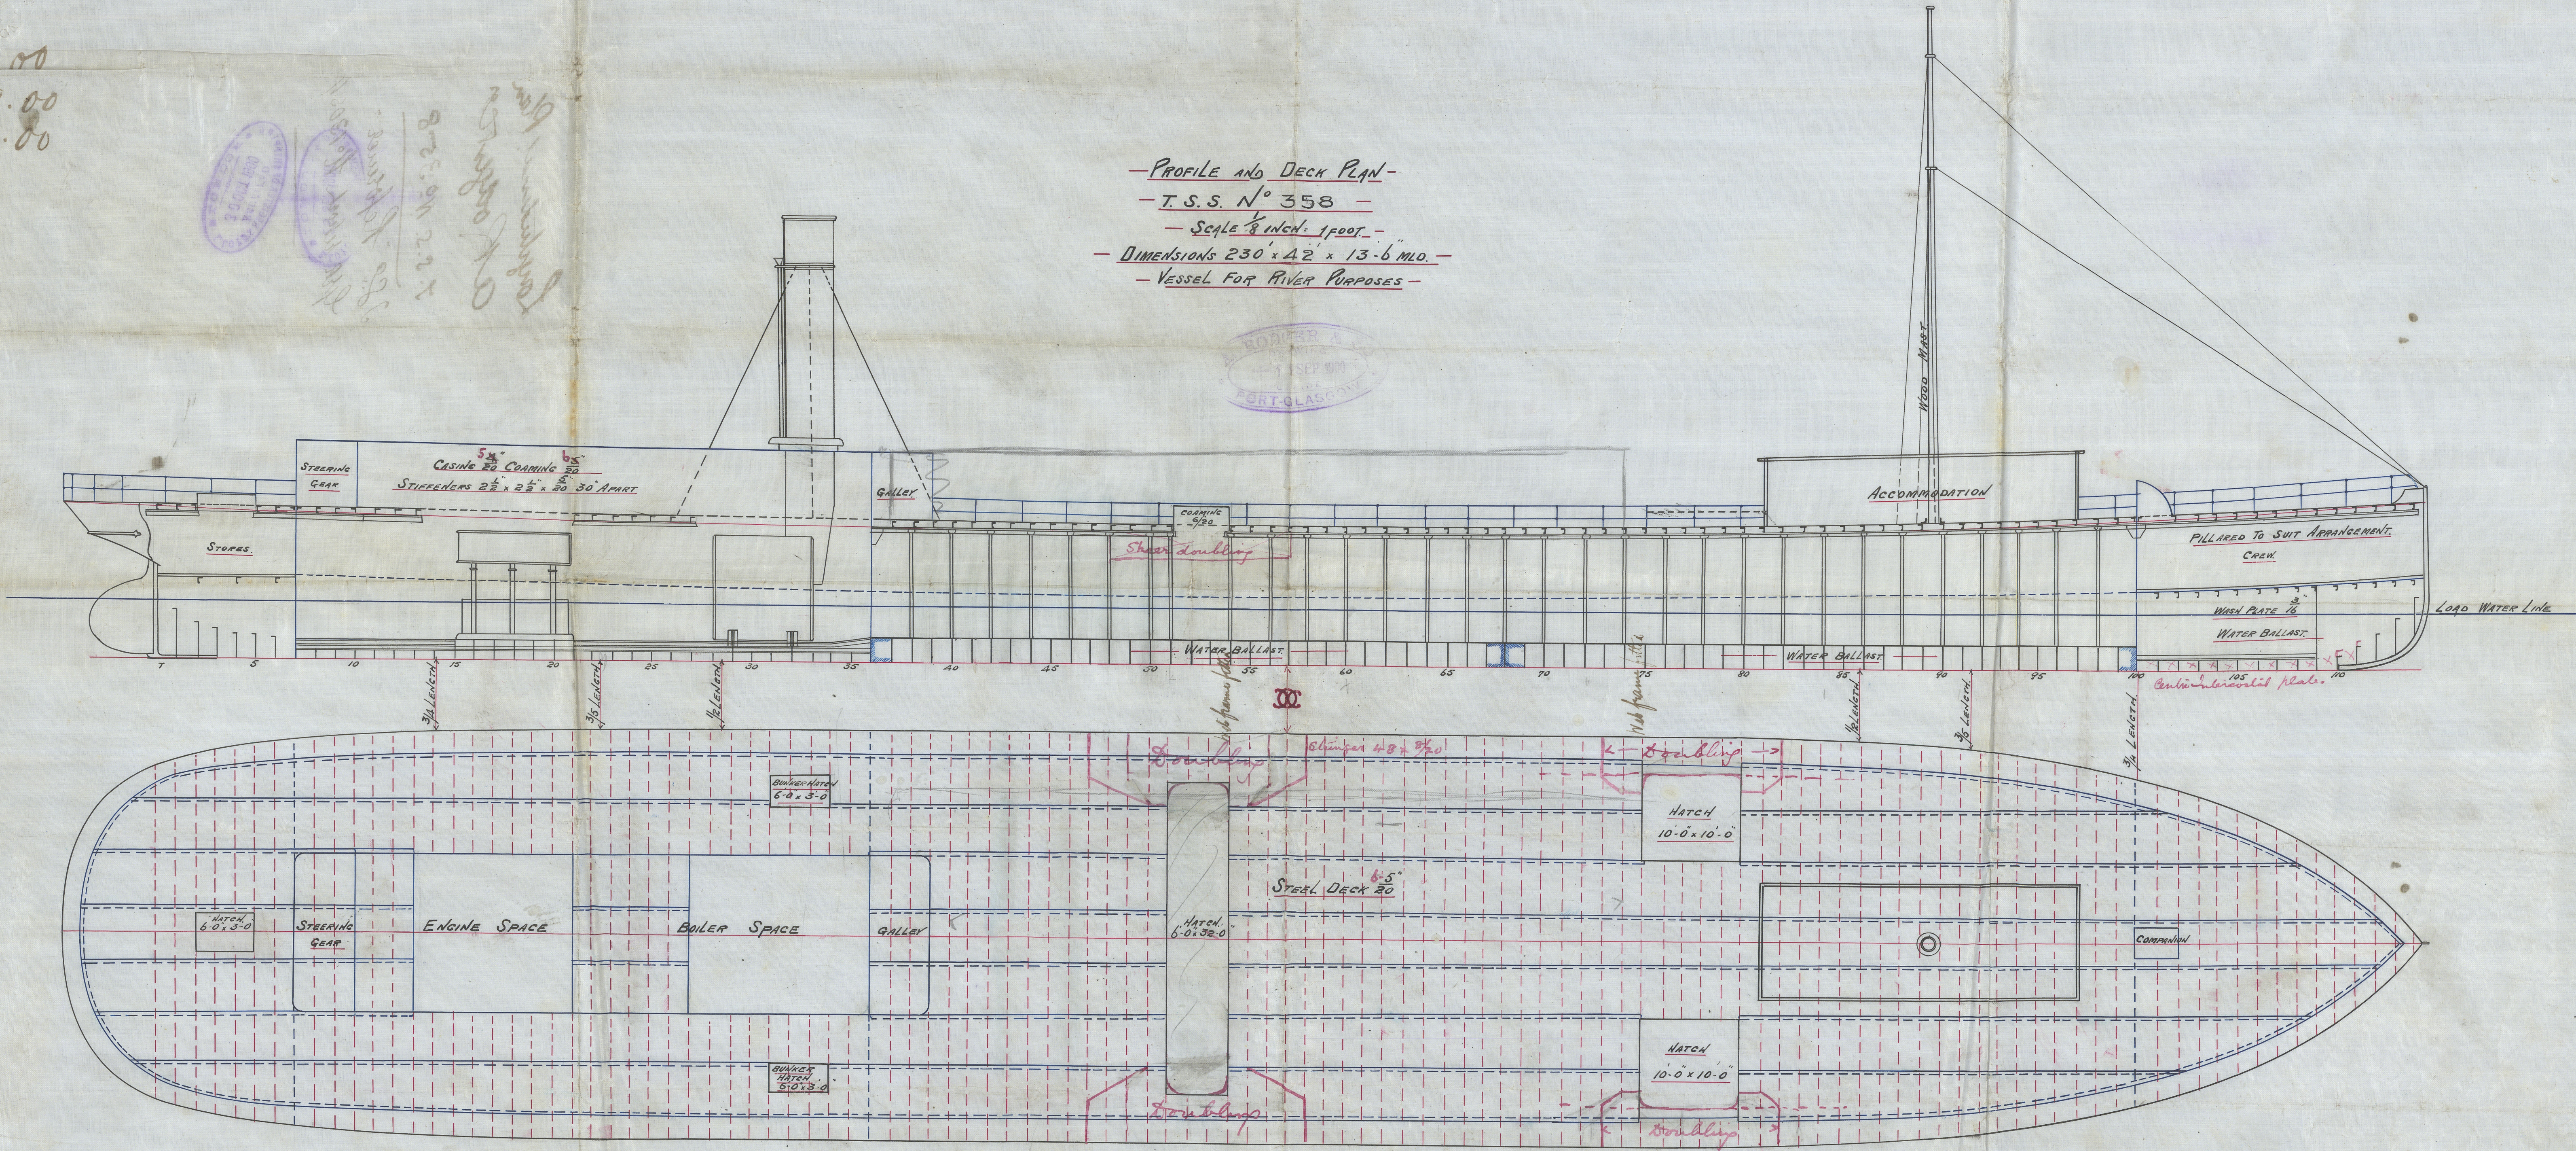



18 9 00
58 9 00
3 11 00

Longitudinal Plan
A. Rodger & Co

T. S. S. No 358

T. S. S. Reformer

Gr. Report No 13054

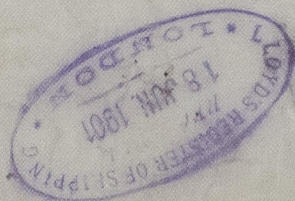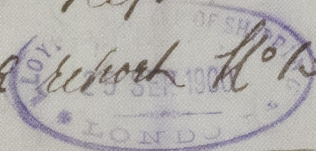

008804-008811-0240



© 2021

Lloyd's Register
Foundation