
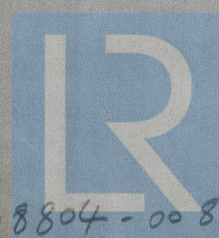
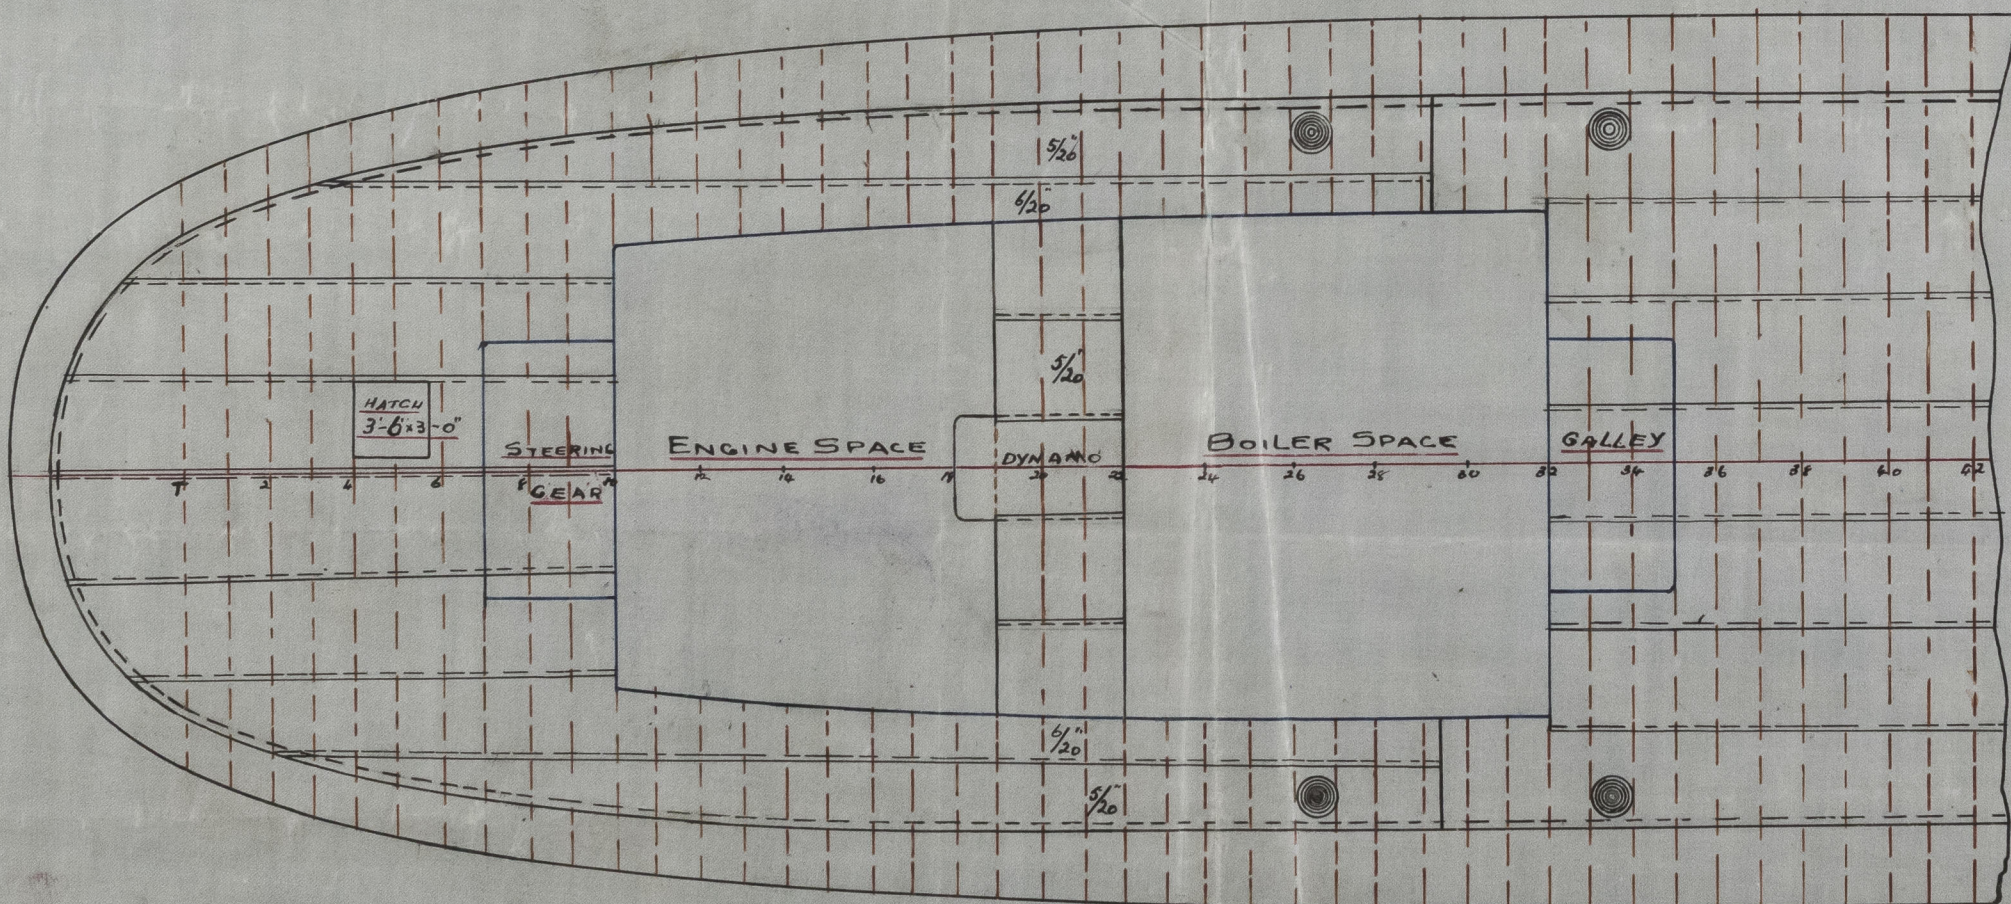


CORRECTED SKETCH OF AFTER END

T.S.S. No 358.

Scale 1/8 INCH = 1 FOOT.

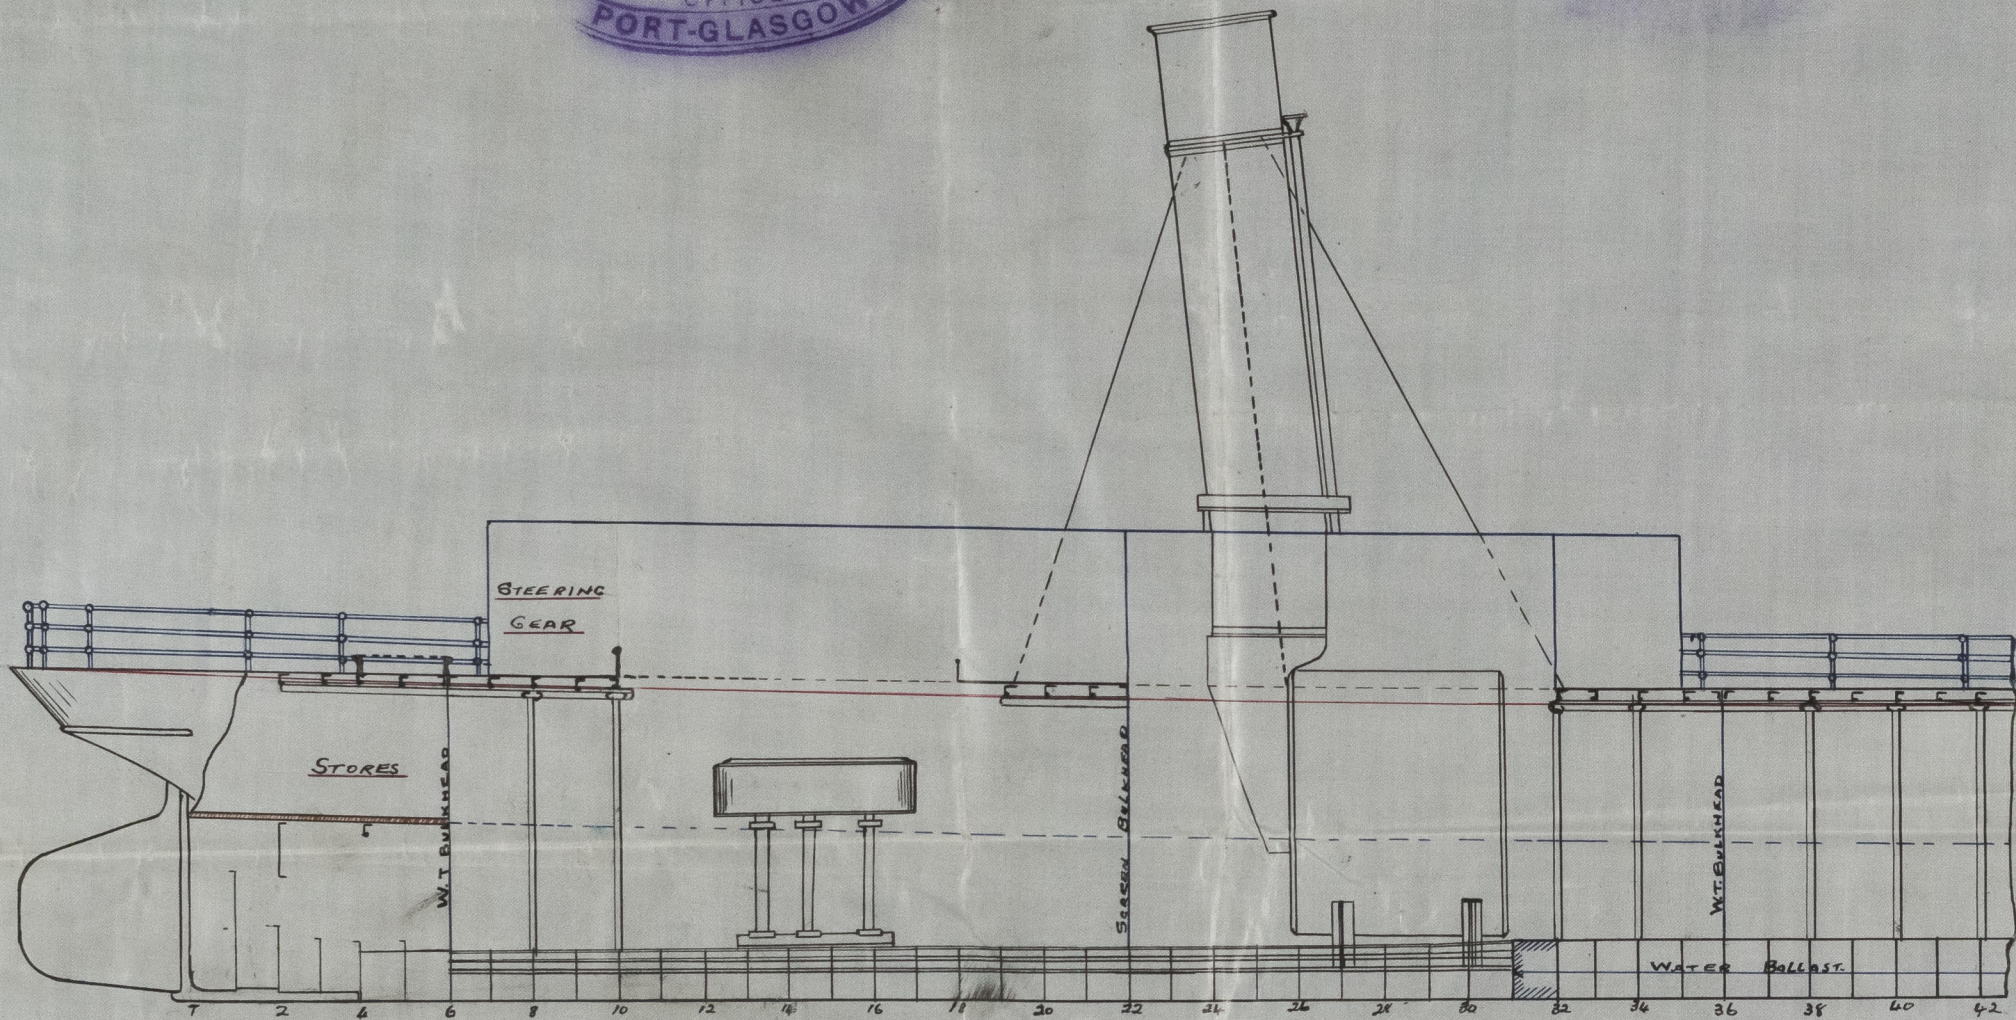

© 2021

Lloyd's Register

008804-008817-0241 Foundation