

27-9-00

For
Stern
Bracket
of
H.M.S. "Penguin"
2000
Tons




008804-008811-0505

STERN BRACKETS

T.S.S. N° 358

SCALE 1/2" INCH = 1 FOOT

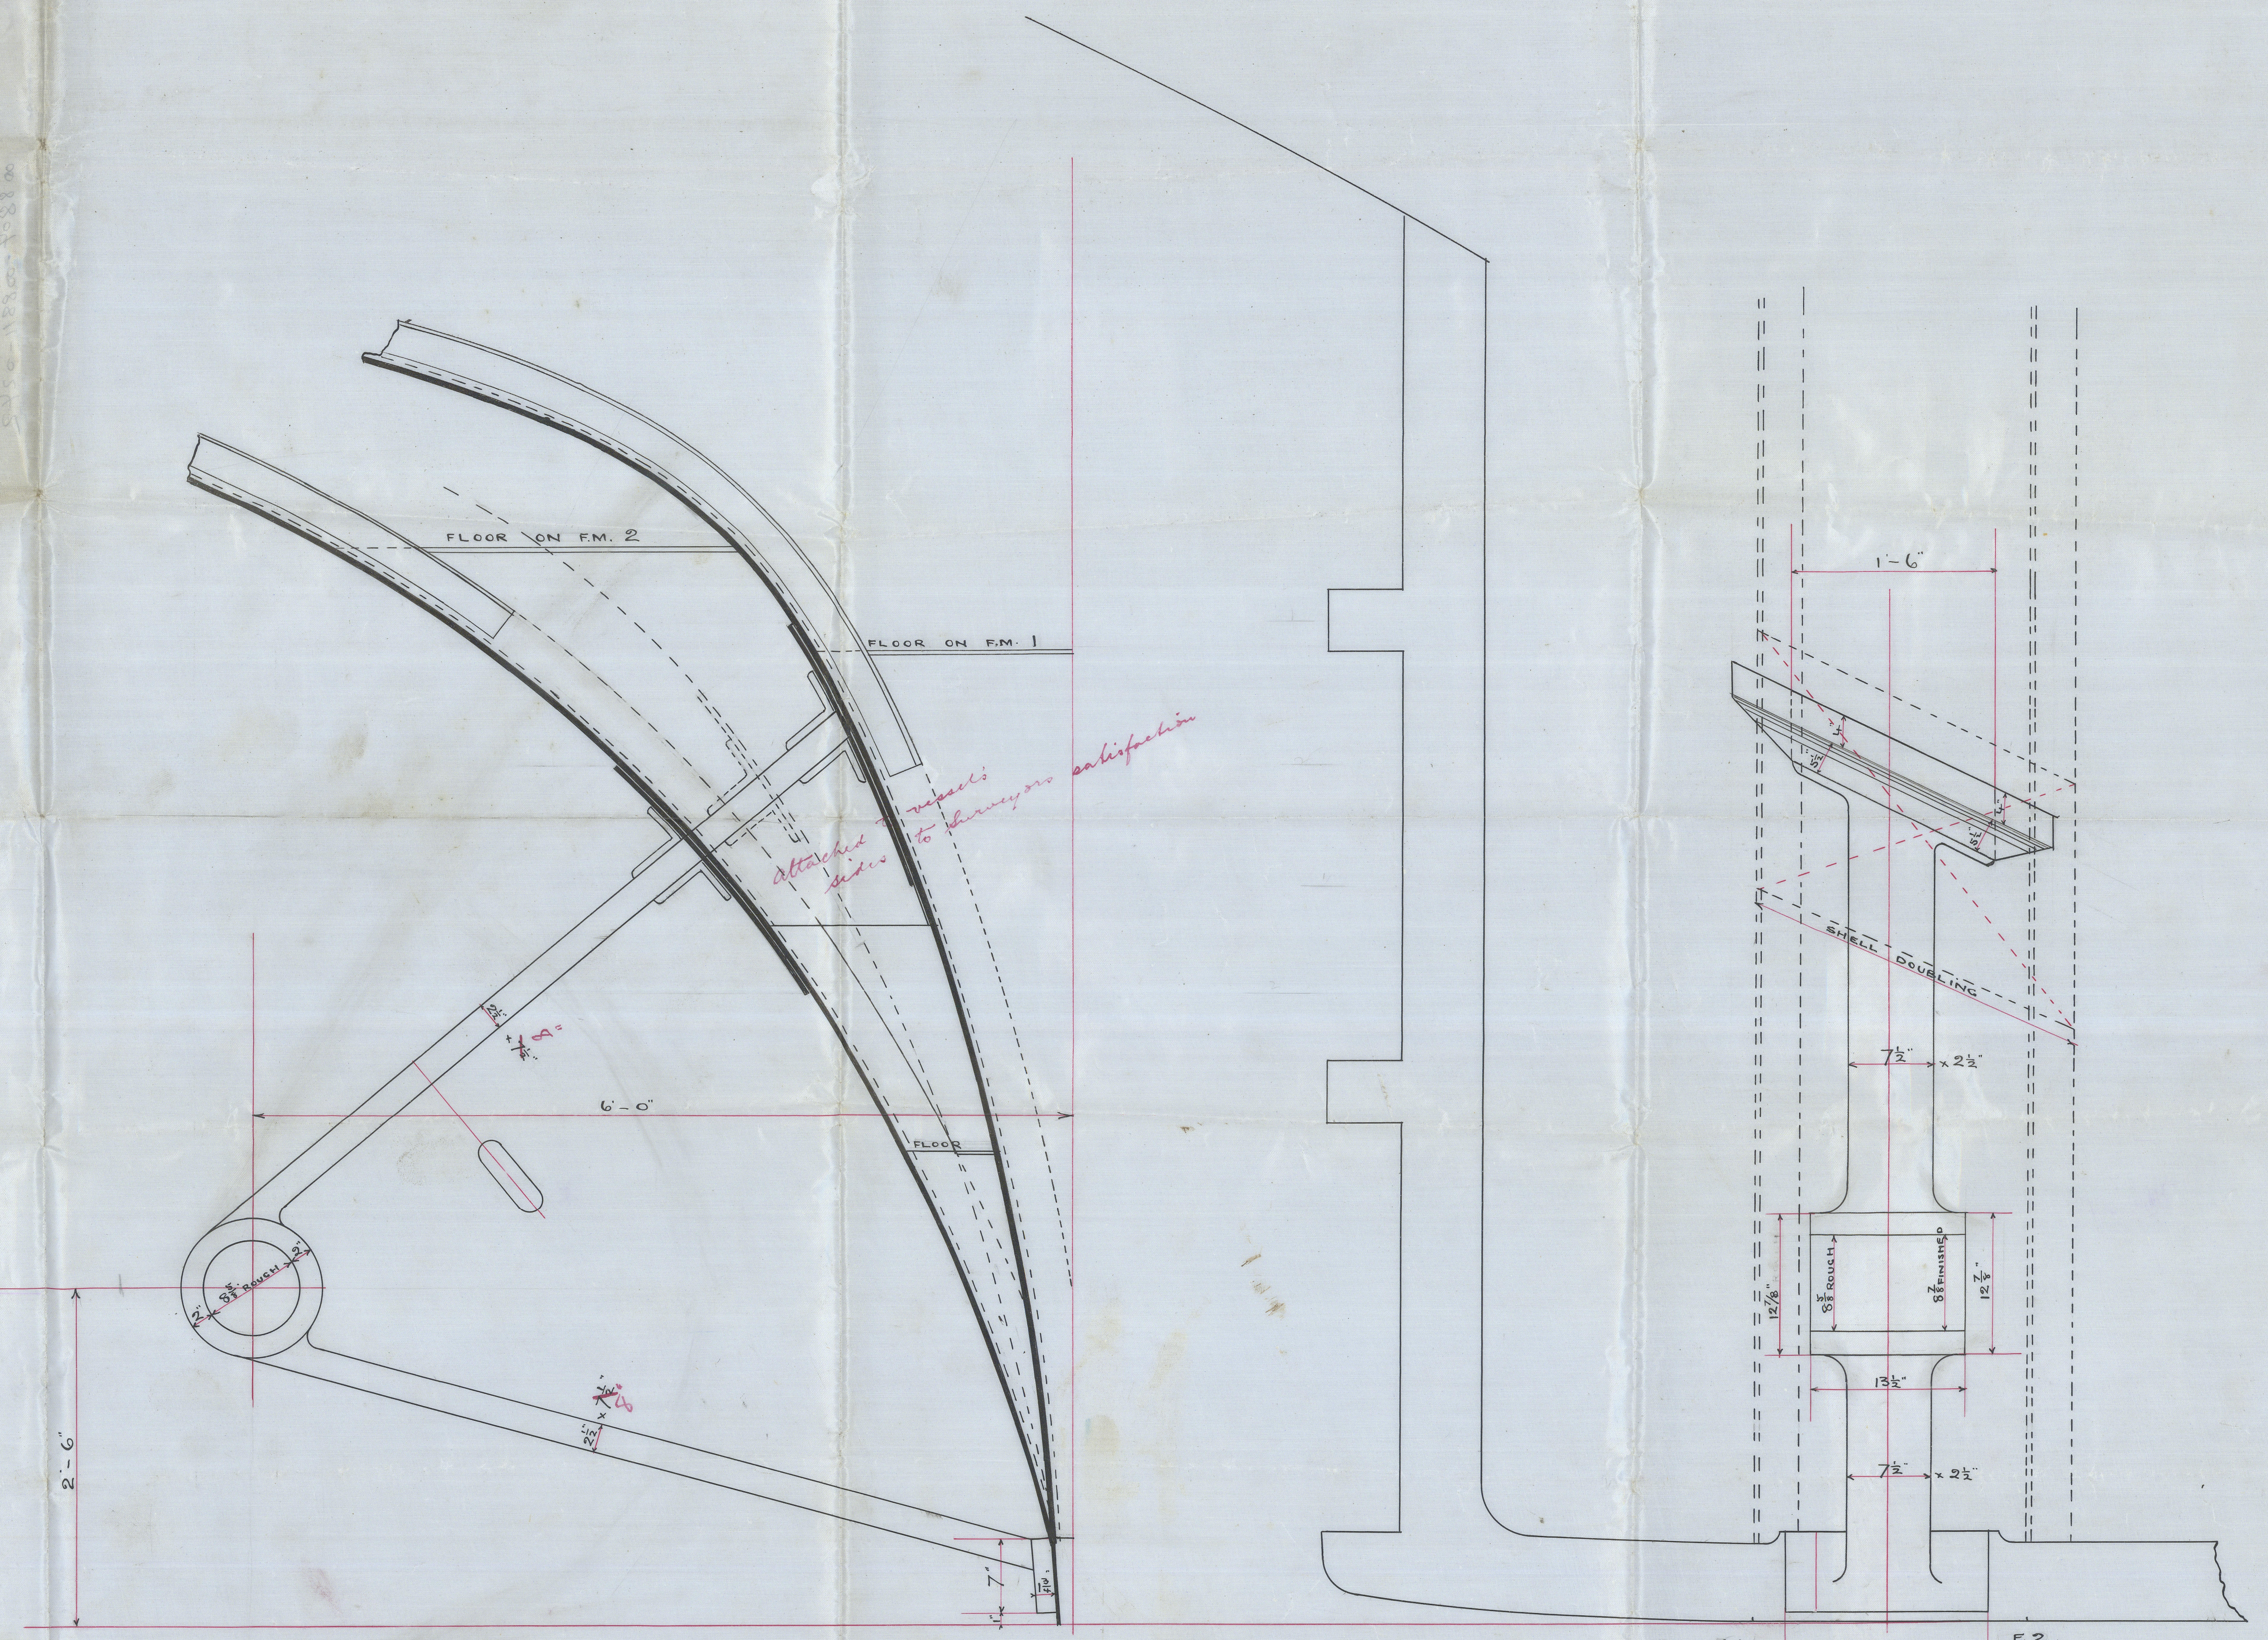

J.V.L.
27/9/00

21. 0. 8

00 8804 - 00 8811 - 0242

© 2021

Lloyd's Register
Foundation