


27. 10. 99
28. 11. 99

PROFILE.

SCALE 1/8" = 1 FOOT.

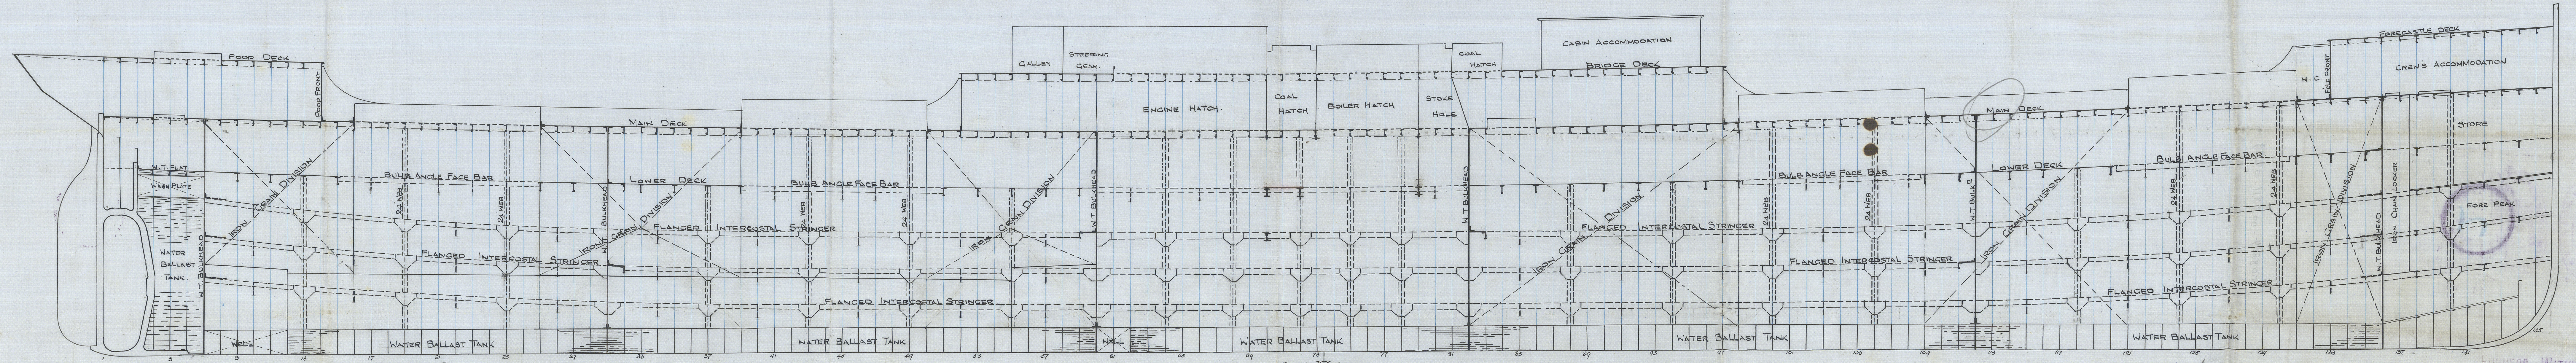

N^{os} 250 & 1.

FURNESS, WITBY & CO., LIMITED.

SHIPBUILDERS & REPAIRERS

WEST HARTLEPOOL

Oct 24/99

Lloyd's Register

Foundation

008804-008811-0299

Furness Withy & Co. Ltd.

No. 250 & 251.
Amended Profile.

"Morocco" now "PUNGUE"
Hpl. Report No. 11331

27.10.99
20.11.99



008804-008811-0299



© 2021

Lloyd's Register
Foundation