
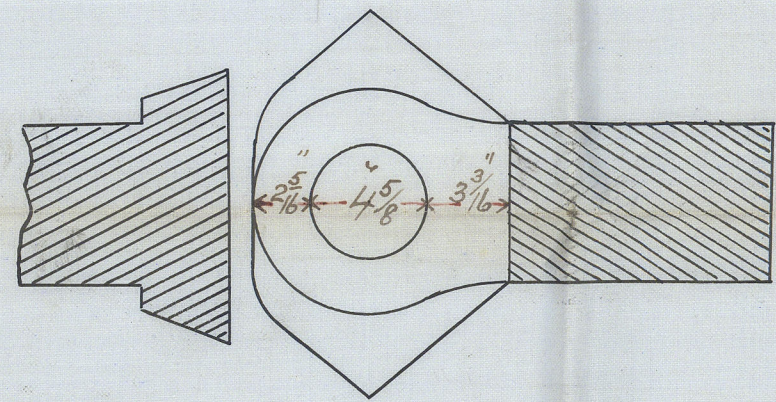


# SCREW FRAME


SCALE  $\frac{1}{2}$ " = ONE FOOT

TO PASS LLOYDS

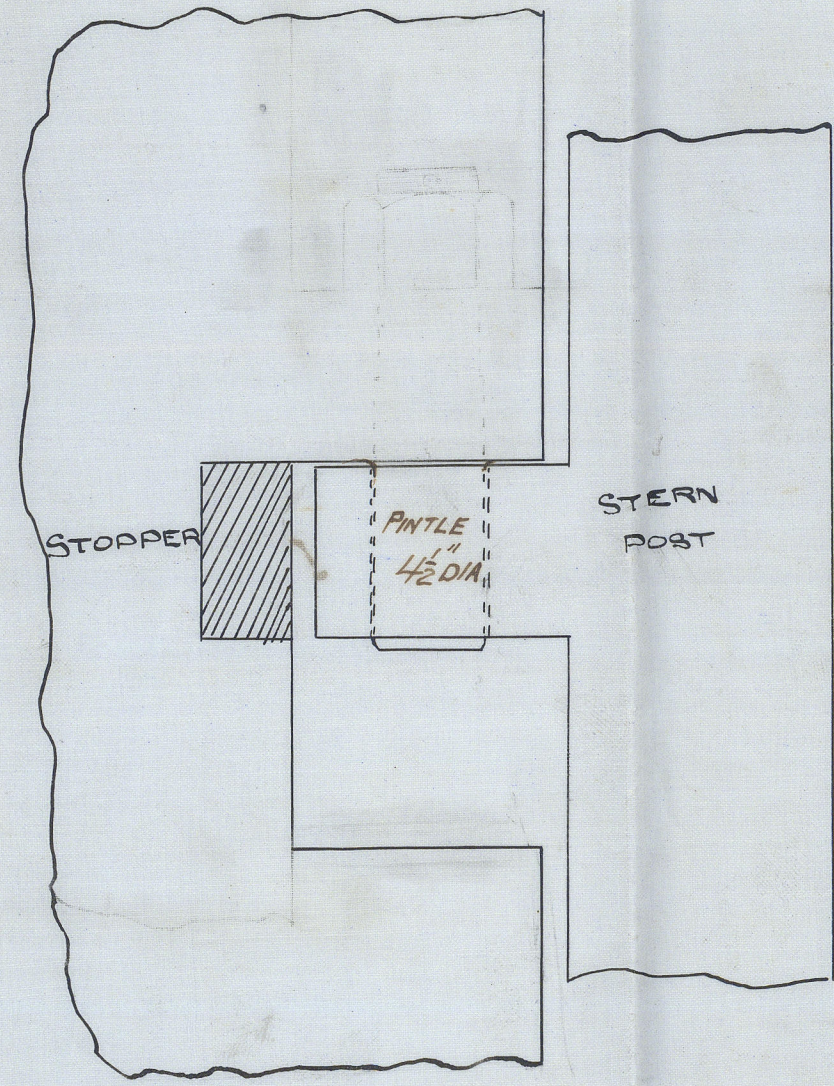


### SKETCH OF GUDGEON & STOPPER

SCALE  $1\frac{1}{2}'' = \text{ONE FOOT}$

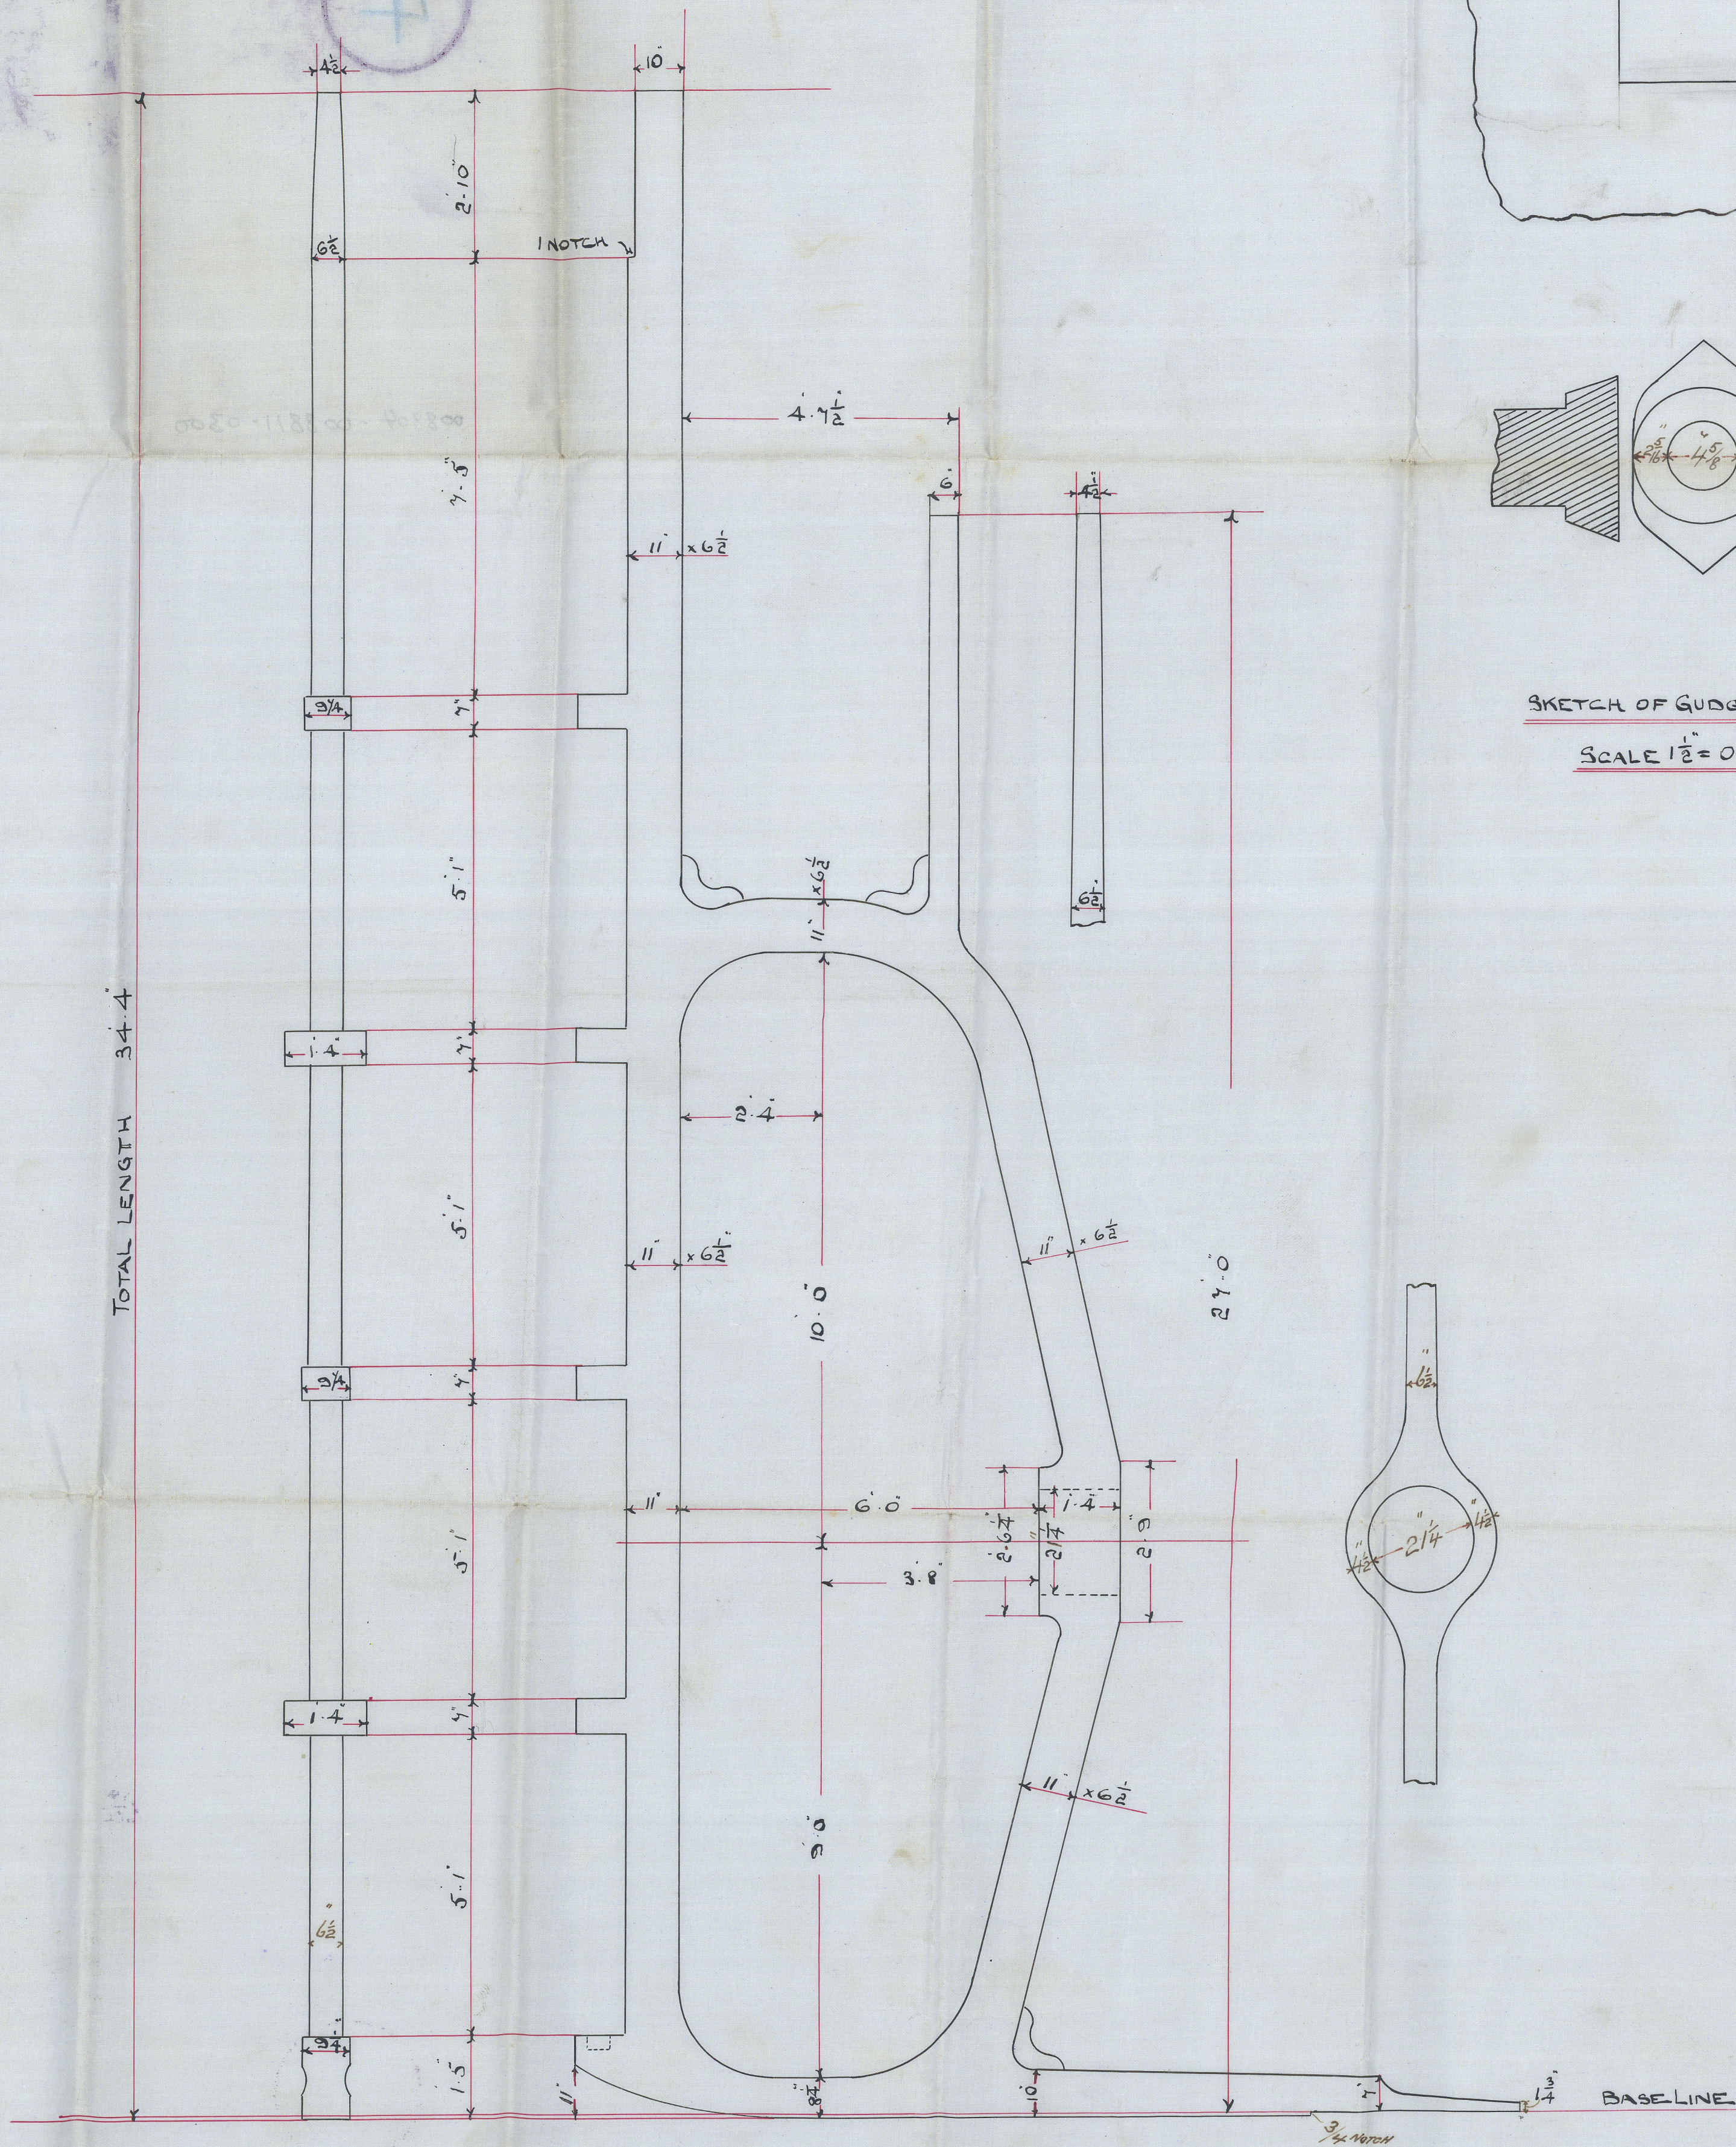

N<sup>o</sup> 250 & 51

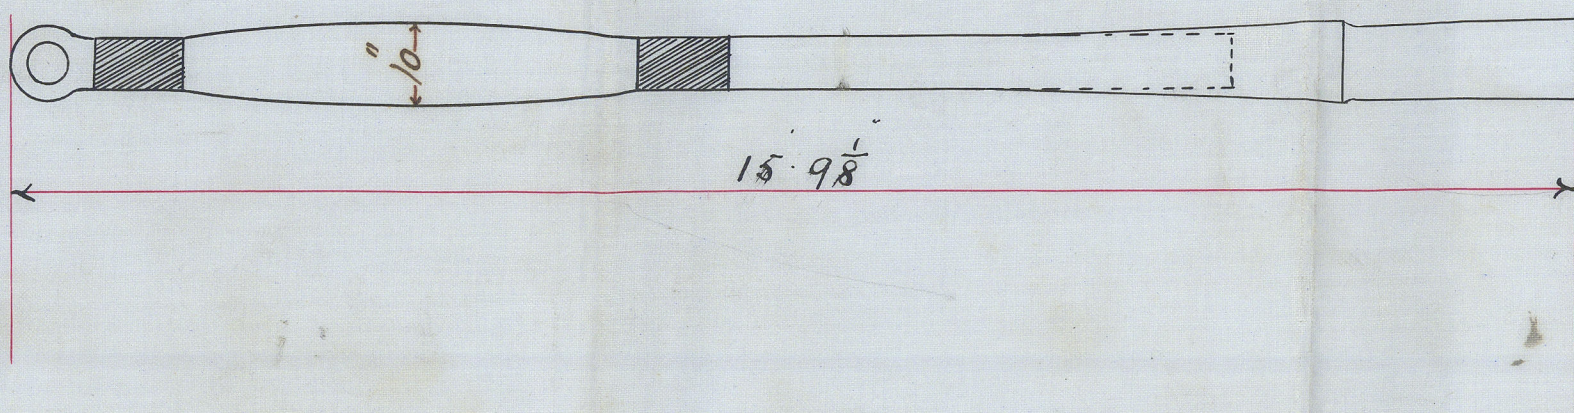

FURNESS, WITBY & CO., LIMITED

WEST HARTLEPOOL © 2021

Oct 17<sup>th</sup> / 99

© 2021

Lloyd's Register  
Foundation

008804-008811-0300


Furness Witby & Co Ltd

11 No 250 ~~250~~

C.S. Stern frame.

"Morocco" <sup>Now 'PUNGUE'</sup>

Hpl Report no 113

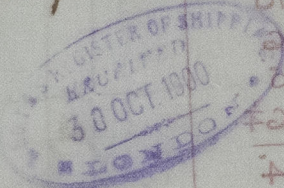

ABOVE DECK	1
CARP	1
2 SHEER	1
D M	1
KEEL	1
3 + 4	

pp. 01-02



© 2021

Lloyd's Register  
Foundation

008804 - 008811 - 0300