

Lloyd's Register of Shipping.


SURVEYS FOR FREEBOARD.

(CONDITIONS OF ASSIGNMENT.)

Pld 4614

Ship's Name *FRESHENER* Port of Survey *Lytham (Liverpool Office)*
 Official Number *168298* Surveyor's Signature *W. Welton + J.A. Hendry*
 Nationality and Port of Registry *British, London* Date of Survey *17th June 42*

Disposition and dimensions of superstructures, trunks, deckhouses and machinery casings to be inserted in the diagrams and tabular statement :-

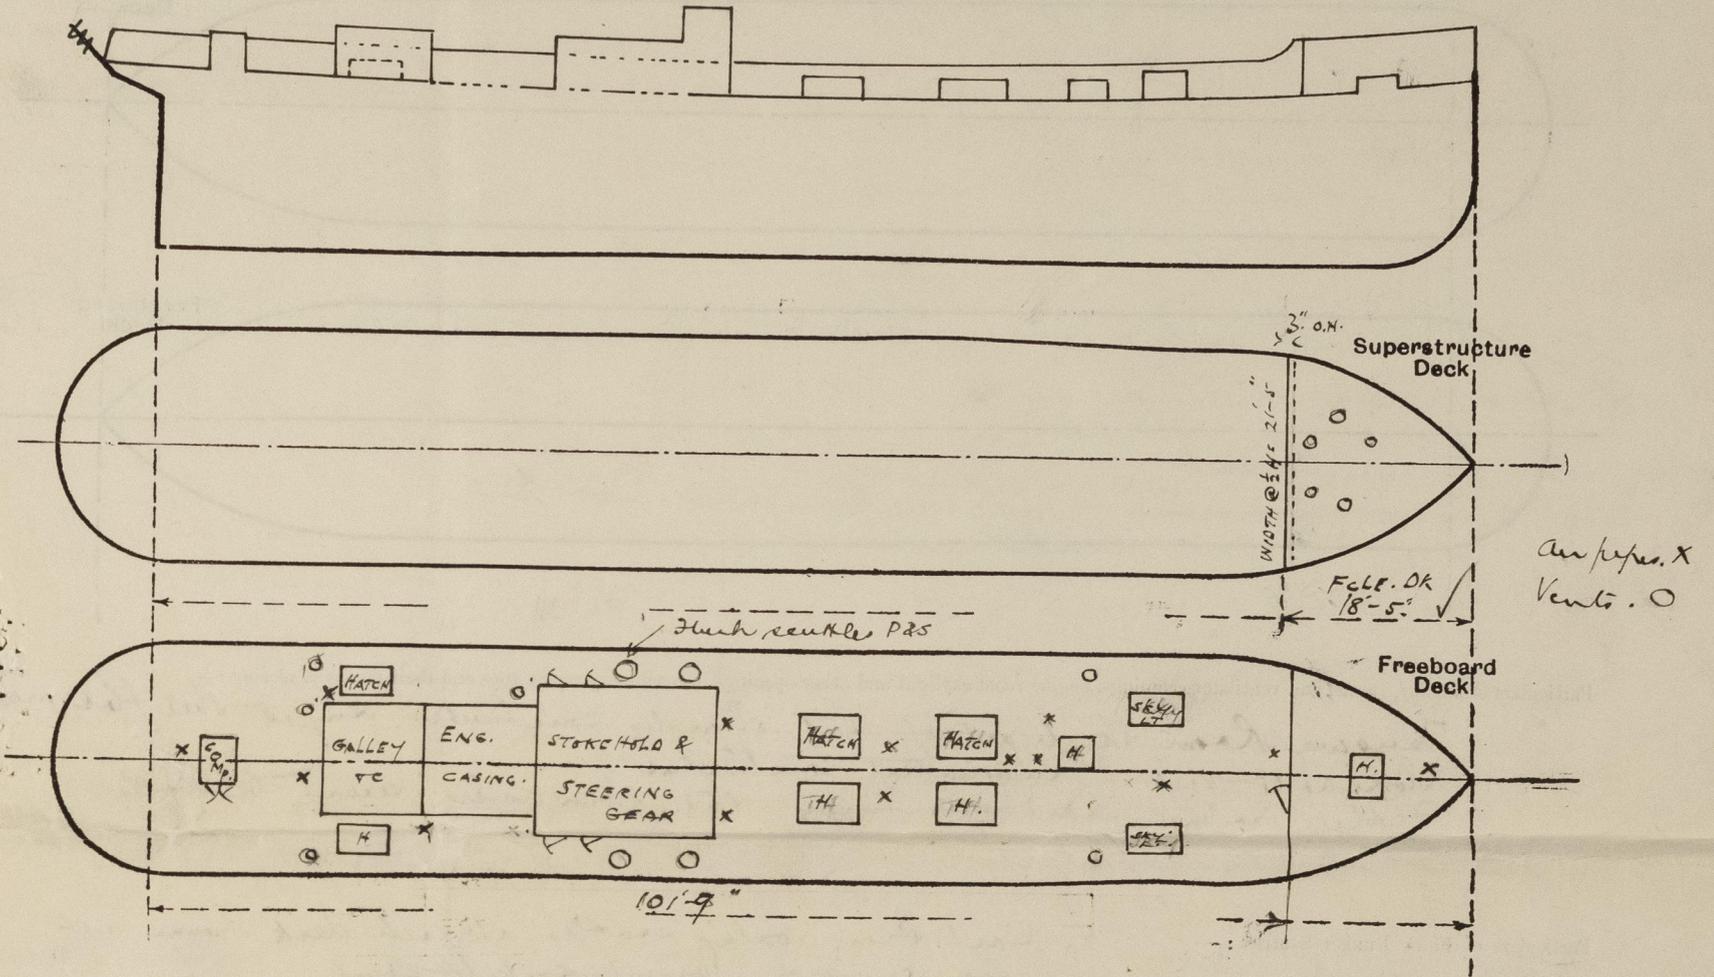


Particulars of Superstructures, Trunks, Casings, Deckhouses.

	Coaming	Plating	Stiffeners	Spacing	End Attachments of Stiffeners	Size of Openings	Height of Sills	Height of Casings
Poop Bulkhead								
Raised Quarter Deck Bulkhead ...								
Bridge, After Bulkhead								
Bridge, Forward Bulkhead								
Forecastle Bulkhead	14x.25	.20	3x2x.25.L	27"-30"	end web thro bar only	4'-9"x2'-0"	14" ✓	6'-6"
Trunk, Aft								
Trunk, Forward								
Exposed Machinery Casings on Freeboard or Raised Quarter Decks ...	18x.31"	.27	3x2x.30.L	30"	B&G top only	4'-6"x2'-0"	20" ✓	7'-0"
Exposed Machinery Casings on Superstructure Decks								3'-9" ✓
Machinery Casings within Superstructures not fitted with Class I Closing Appliances								
Deckhouses on Flush Deck Ships ...								

Particulars of Closing Appliances (state if capable of being manipulated from both sides).

Poop Bulkhead	
Raised Quarter Deck Bulkhead ...	
Bridge, After Bulkhead	
Bridge, Forward Bulkhead	
Forecastle Bulkhead	
Exposed Machinery Casings on Freeboard or Raised Quarter Decks ...	1 Steel hinged door to be operated both sides ✓
Exposed Machinery Casings on Superstructure Decks	4 Steel hinged W.T. doors to machy space. operated both sides ✓
Machinery Casings within Superstructures not fitted with Class I Closing Appliances	
Deckhouses on Flush Deck Ships ...	

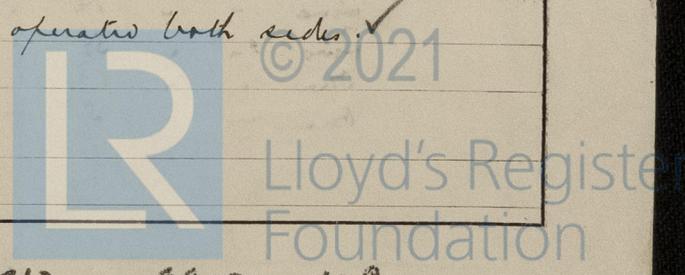

PARTICULARS OF PROTECTION TO OPENINGS, ETC.

HATCHWAYS ON FREEBOARD AND SUPERSTRUCTURE DECKS.									
Description of Hatchway	SIX WATER TANK HATCHES		Under Deck		on fore deck to hold stow				
Dimensions of Hatchway	36" x 24"		36 x 30.		27 x 27"				
COAMINGS	Height above Deck	18"	18		18				
	Thickness	} 30.	} 30.		} 30				
	Sides Ends								
	Stiffeners								
Brackets, Stays	✓								
HATCH BEAMS	Number								
	Spacing								
	Scantling and Sketch	✓	✓		✓				
	Bearing Surface								
FORE AND AFTERS	Number								
	Spacing								
	Unsupported Lengths								
	Scantling* and Sketch	✓	✓		✓				
Bearing Surface									
HATCH COVERS	Material	Steel	Steel		Steel				
	Thickness	.26.	.26		.26				
	How fitted								
	Bearing Surface	Hunged	Hunged		Hunged				
Spacing of Cleats	6	6	3		2				
Number of Tarpaulins	rubber joint	✓	rubber jointed.		rubber jointed				

*Are wood fore and afters steel shod at all bearing surfaces?
 Are battens and wedges efficient and in good condition?
 Are tarpaulins in good condition and in accordance with rule requirements?
 Are lashings provided in accordance with rule requirements?

Particulars of any special features:—

Vessel is constructed as a special water tank vessel

Endorsement at first survey and at surveys for renewal of Certificate:—

The fittings and appliances are in accordance with the particulars shown on this form (or as now modified) and are in good condition.



© 2021

Lloyd's Register Foundation