


7-12-22

# DETAIL OF COUPLING


SCALES 3' 1 FOOT

FLANGES 2 1/2" THICK

6 BOLTS 2 1/2" DIAM. (TAPERED)

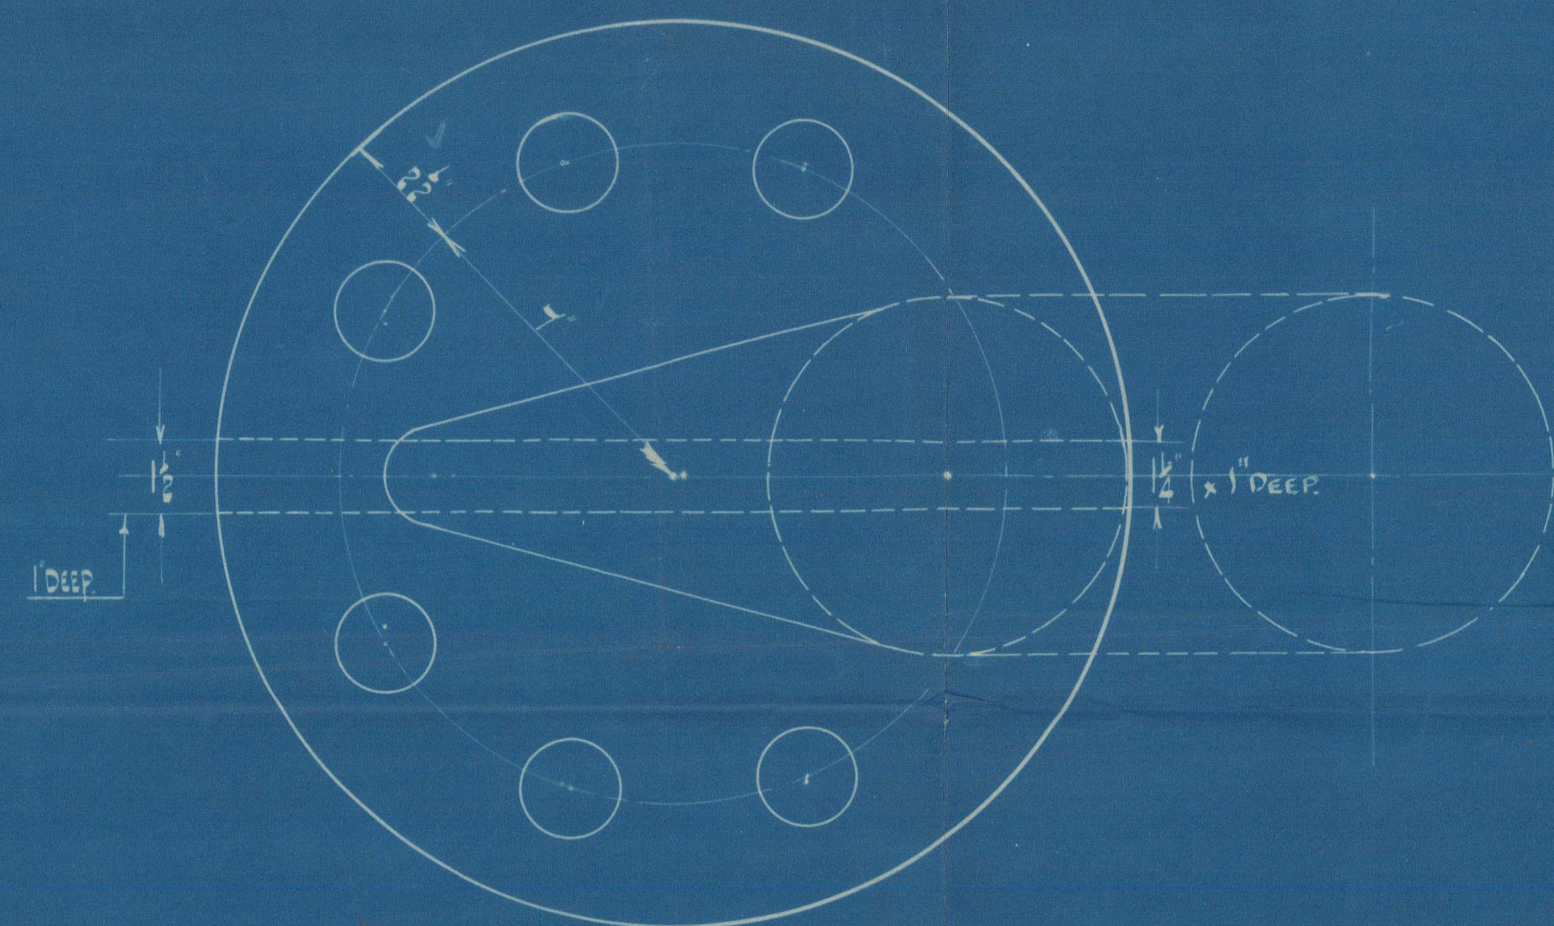

## PLAN OF ARMS

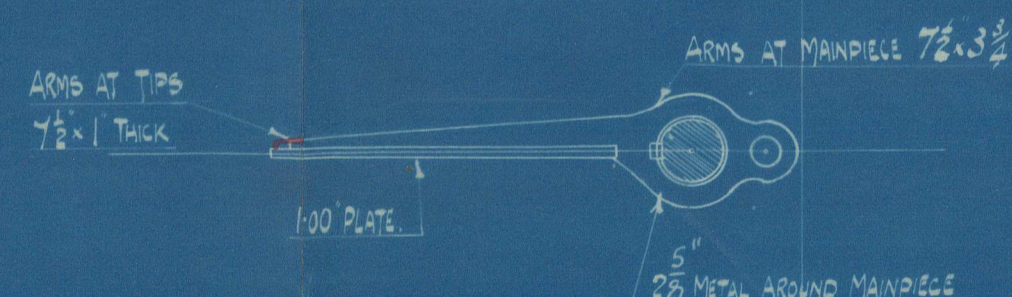

1/2\"/>

## Nº 1146 STERN & RUDDER FRAMES

SCALE 1/2\"/>

AREA OF RUDDER 76 1/2 SQ FEET


A x D = 191

SPEED IN KNOTS = 15


FIRST LONGITUDINAL NUMBER = 7000-7035

DIAMETER OF RUDDER HEAD = 7 1/2"

DIMENSIONS - 230'-0\"/>

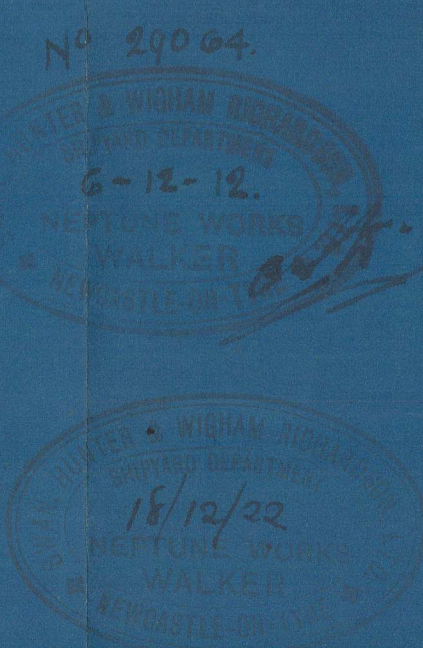


*See later plan of rudder.  
appd. 29/12/22.*

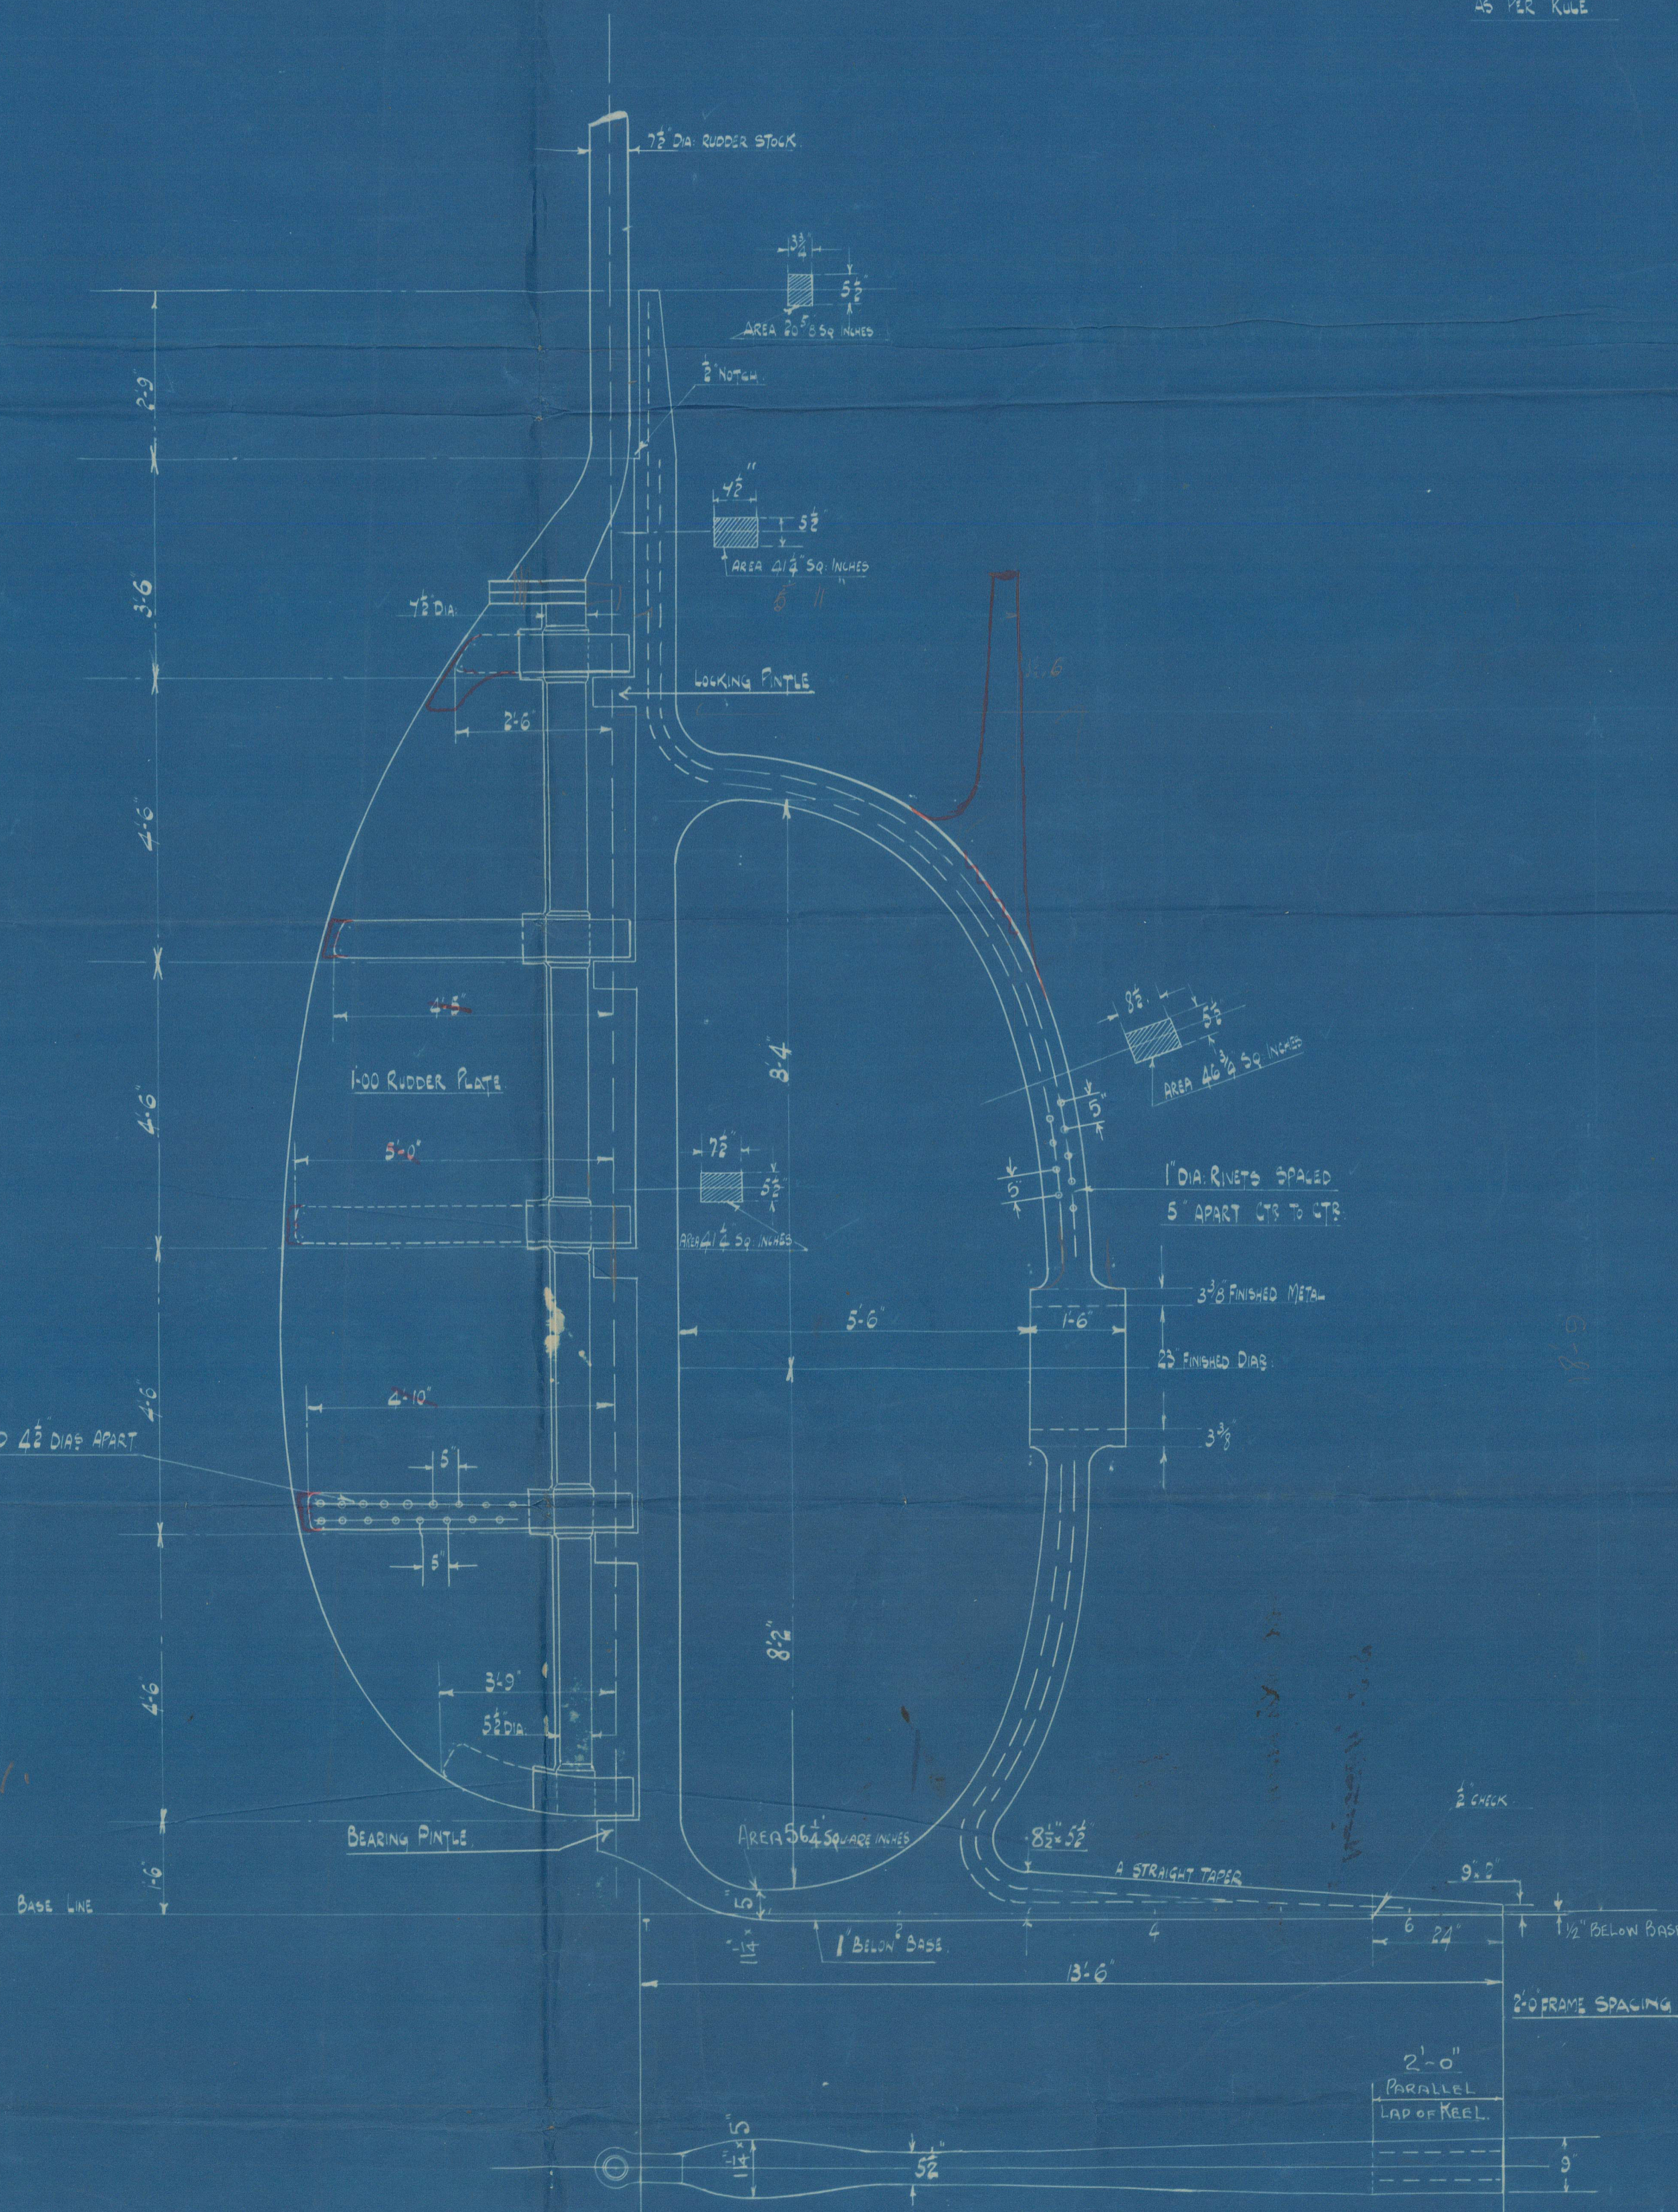


KEYS AS PER RULE INCREASED IN THICKNESS BY 1/2\"/>

RUDDER POST INCREASED AS PER RULE

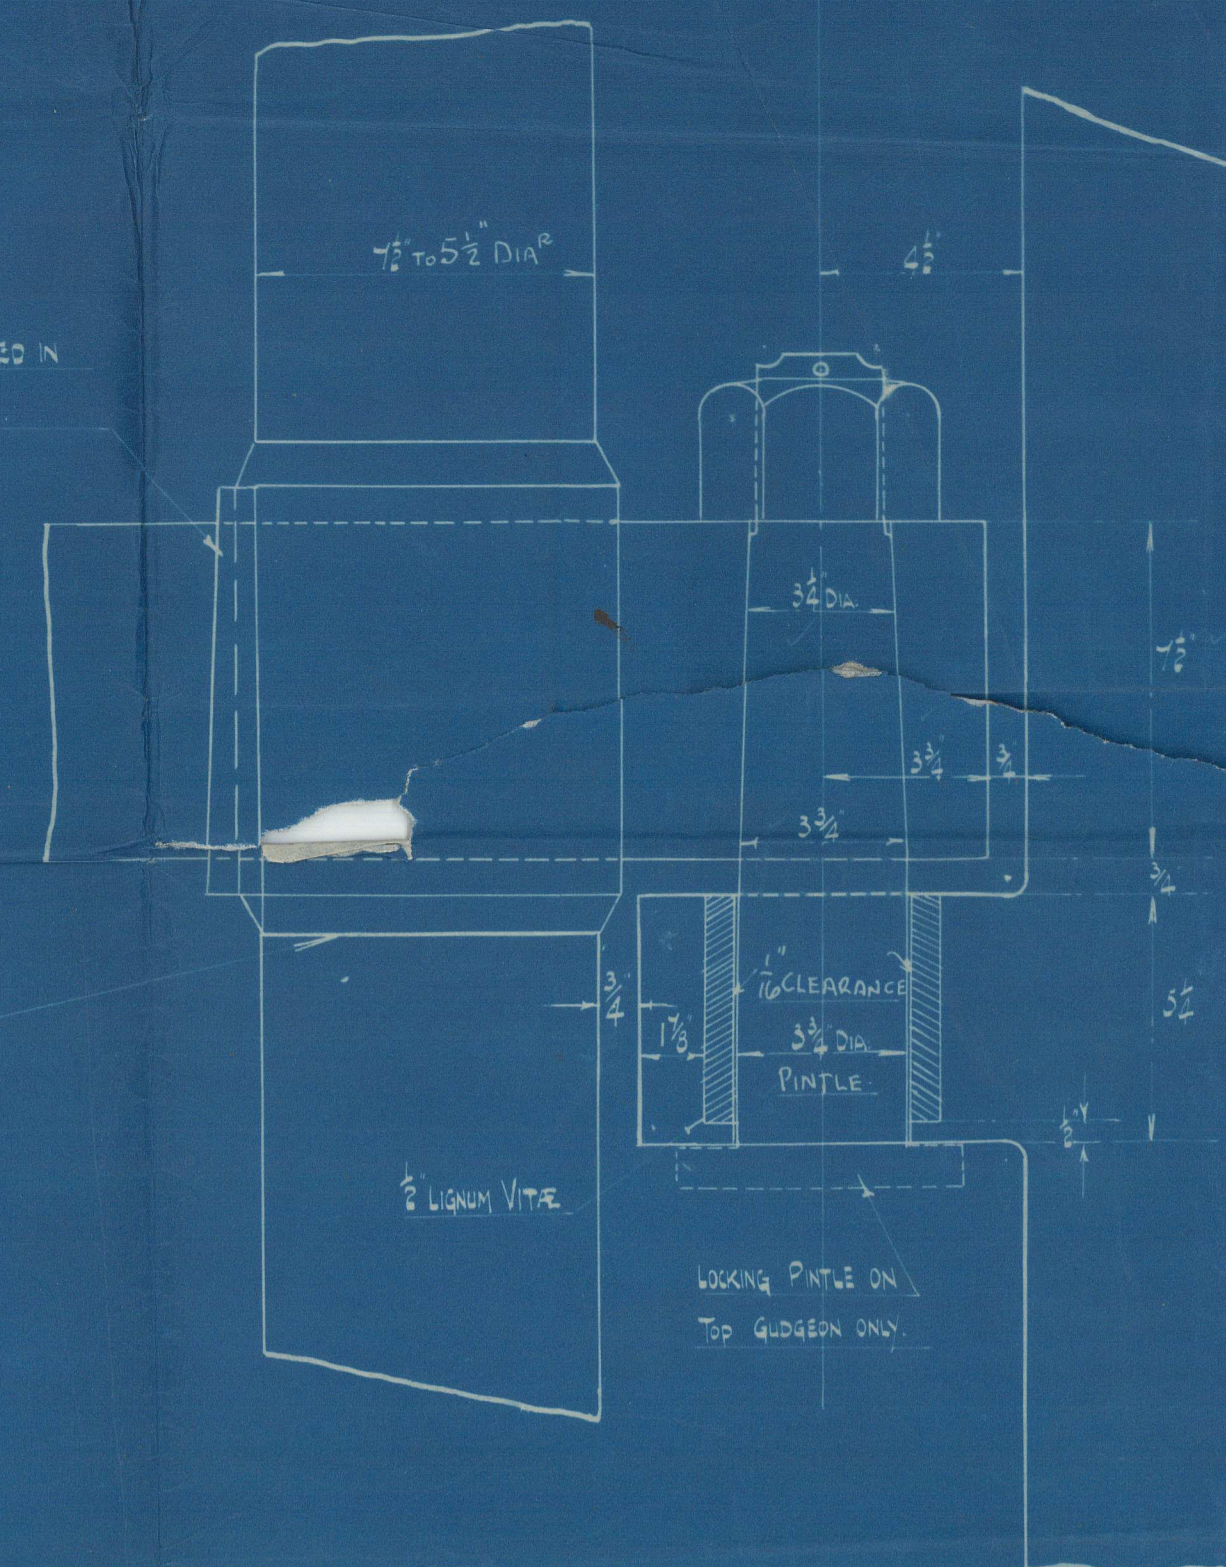

DETAIL OF GUDGEONS  
(EXCEPT BOTTOM GUDGEON)  
SCALE 1/4\"/>

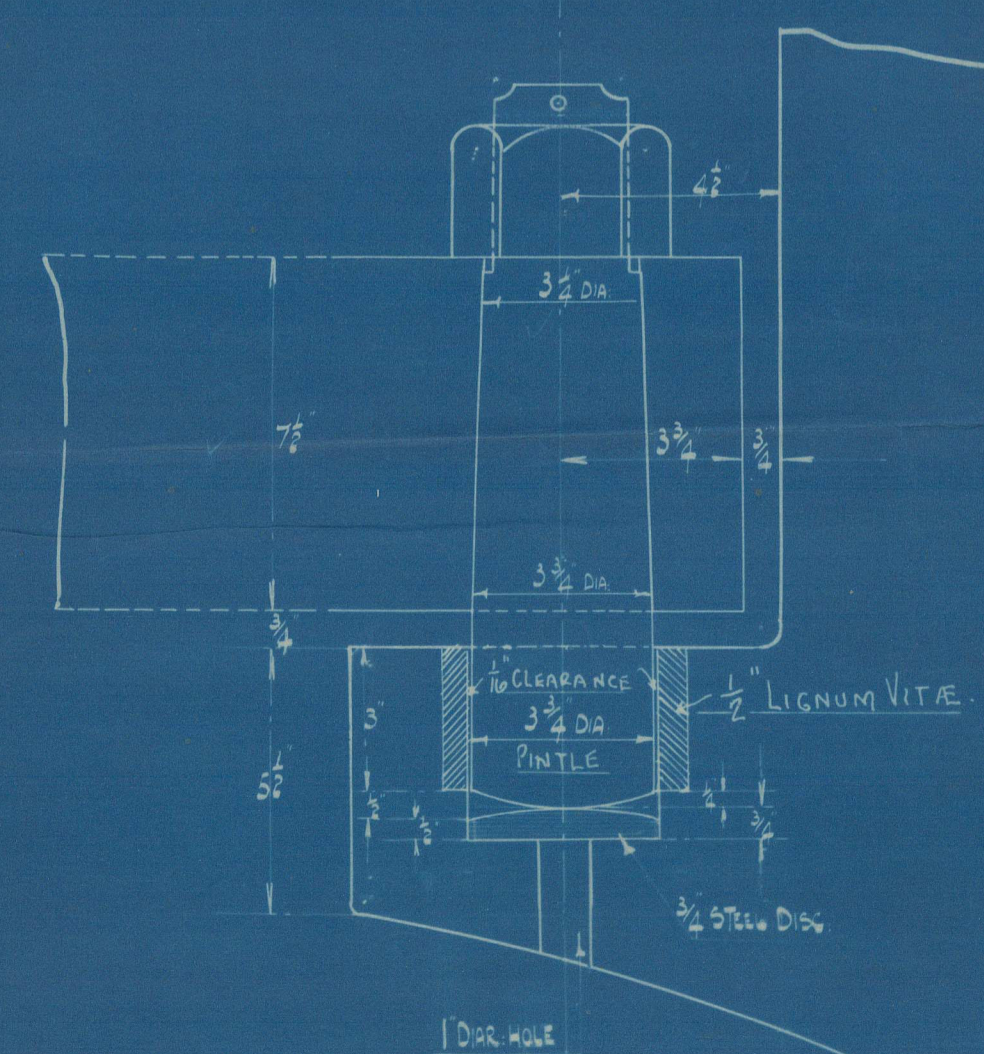

DETAIL OF BOTTOM GUDGEON  
SCALE 1/4\"/>

Swain Hunter & Wigham Richardson

No 1146

Plan of Stern frame & Rudder

No 1146.

~~Stern frame & Rudder~~

Approved by Lloyd's.  
16/12/22

No 1

See later plan of Rudder

S.S. "HADRIAN"

NEWCASTLE ON TYNE.

Report No. 46839.

39.83

.96

40.79



© 2021

Lloyd's Register  
Foundation

008823 - 008830 - 0054