



12.8.08  
1.12.05

— PROPOSED SCREW STEAMER — No 30

— PROFILE AND DECK PLAN. —

— DIMS. 120'-0" B.P. x 22'-0" x 9'-9" M.L.D. —

— SCALE  $\frac{1}{4}" = 1 \text{ FOOT.}$  —

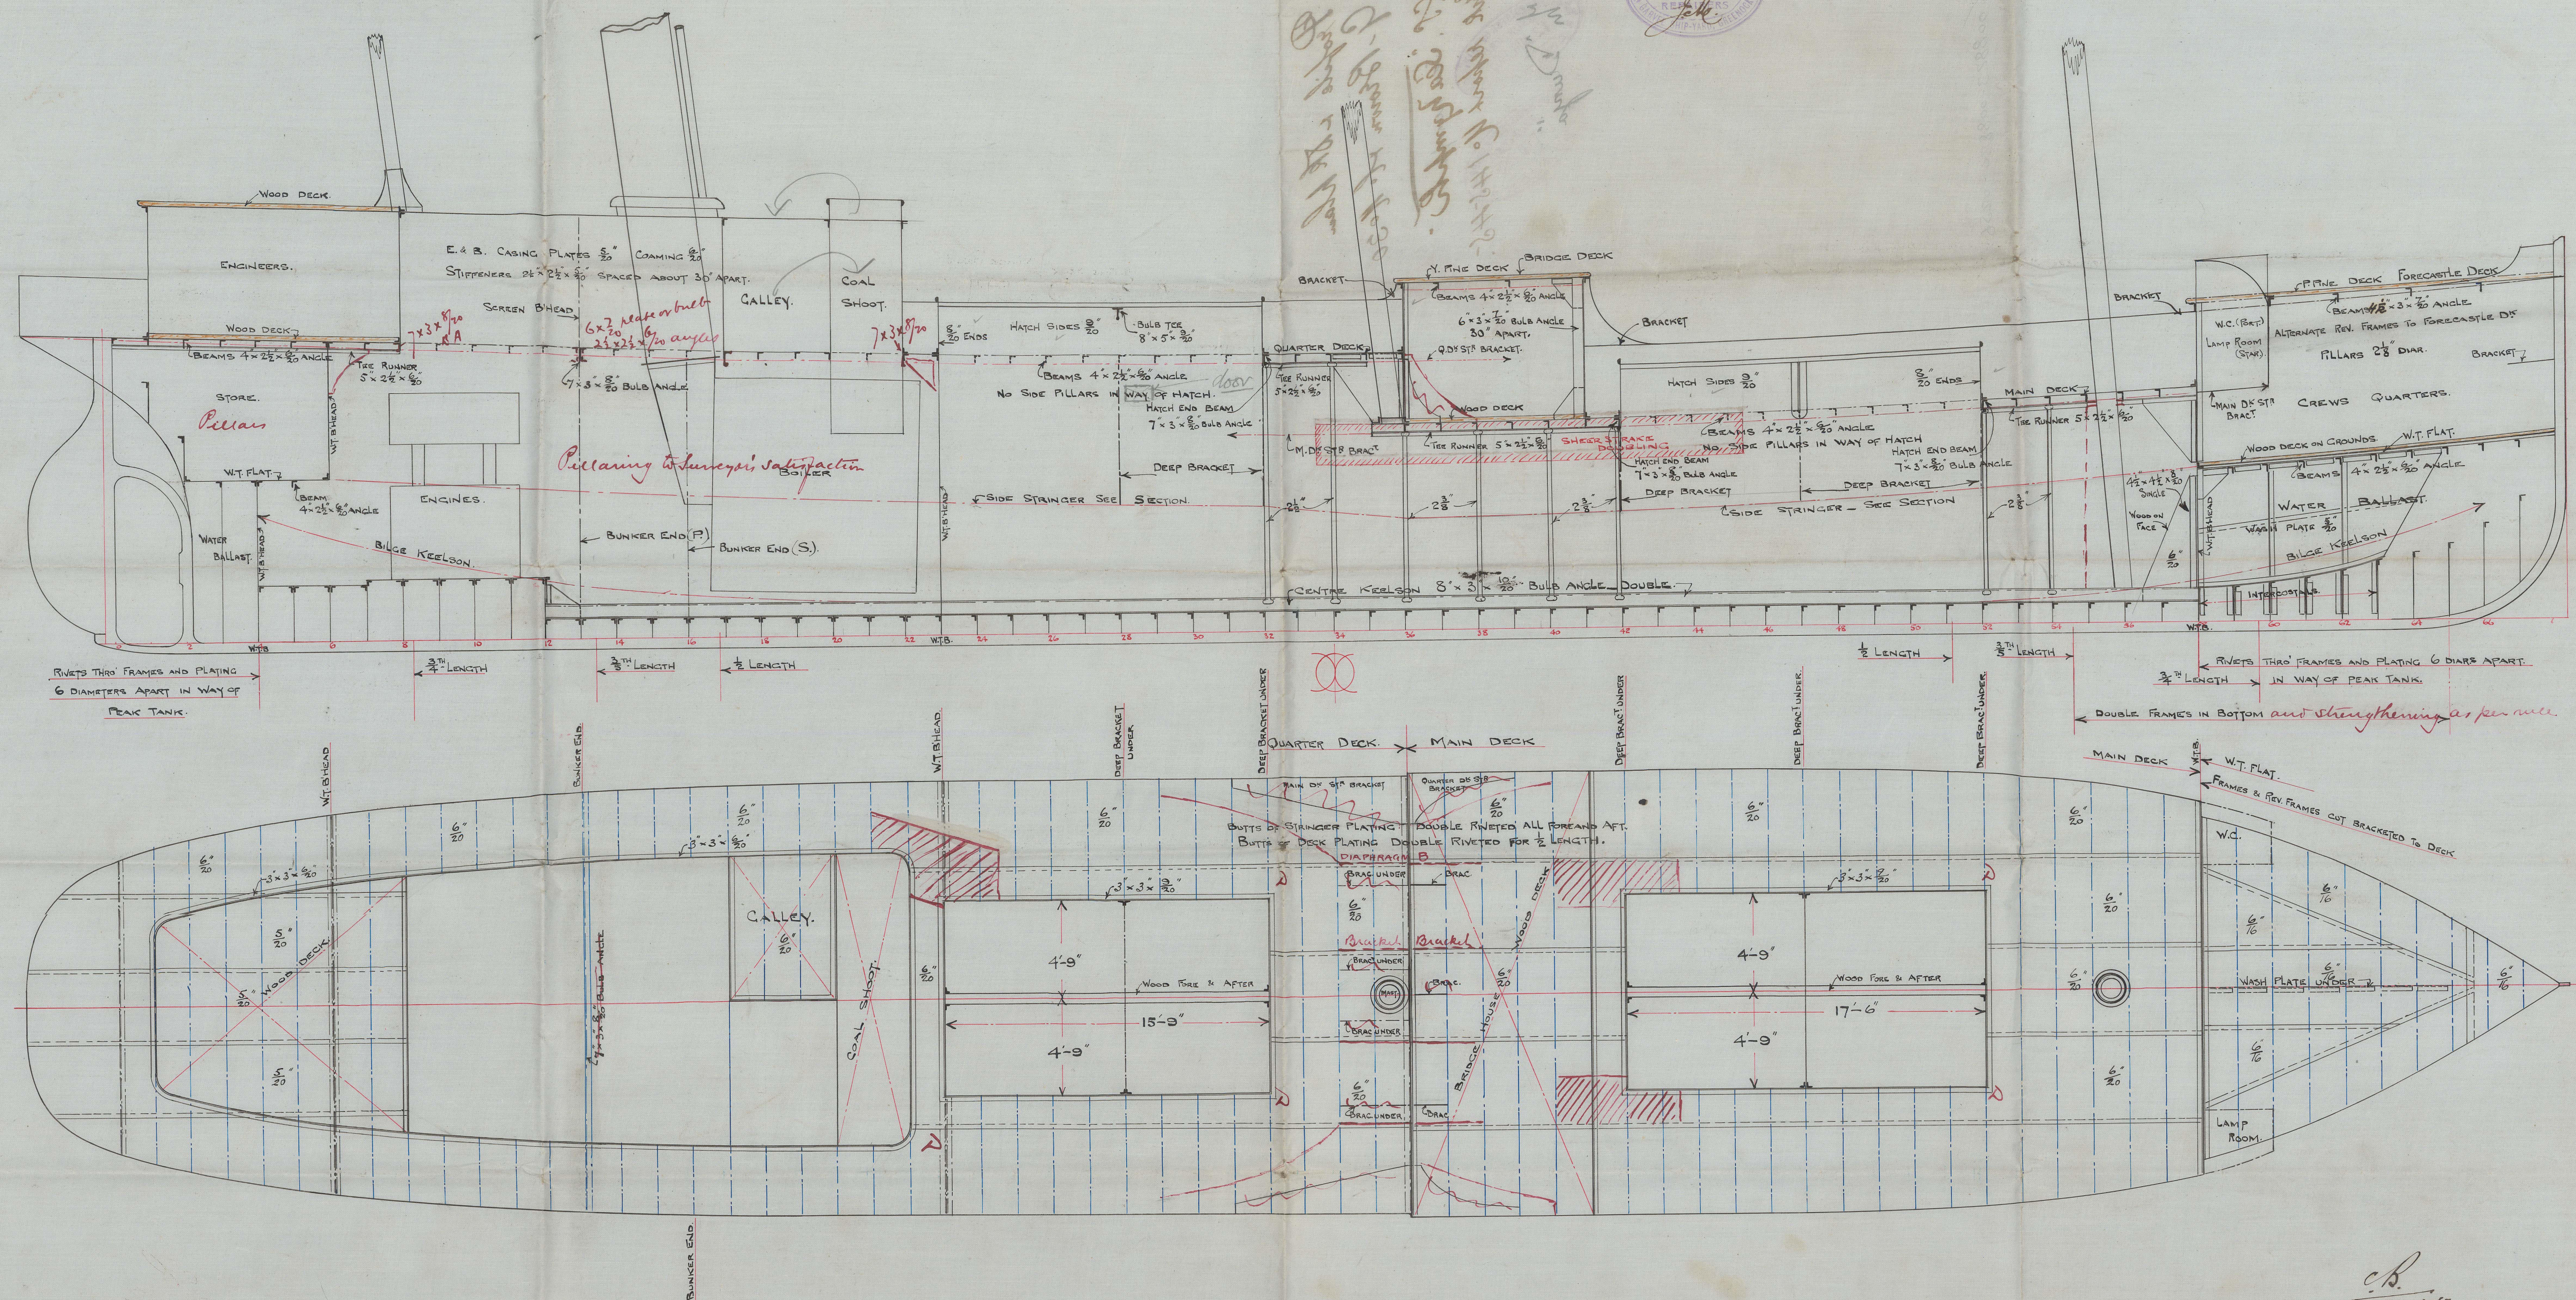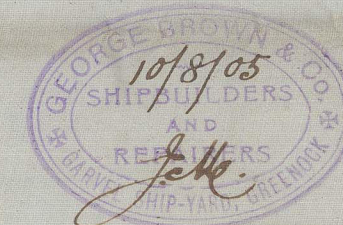

C.B.  
12.8.05




Profile & Sk plan  
G. Brown No. 30

S.S. "Sea nymph"  
Yak report No. 145-45-

1/2 "Dunya"

BRIDGE DECK

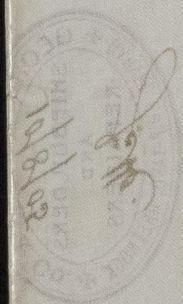

© 2021

Lloyd's Register  
Foundation

008823-008830-0256