



STERNFRAME & RUDDER FOR WATER CARRIER



SCALE: 1" = 1 FOOT

LLOYDS NUMERAL

A x D = 61.1

L x D = 1012

APPROX SPEED 8 KNOTS

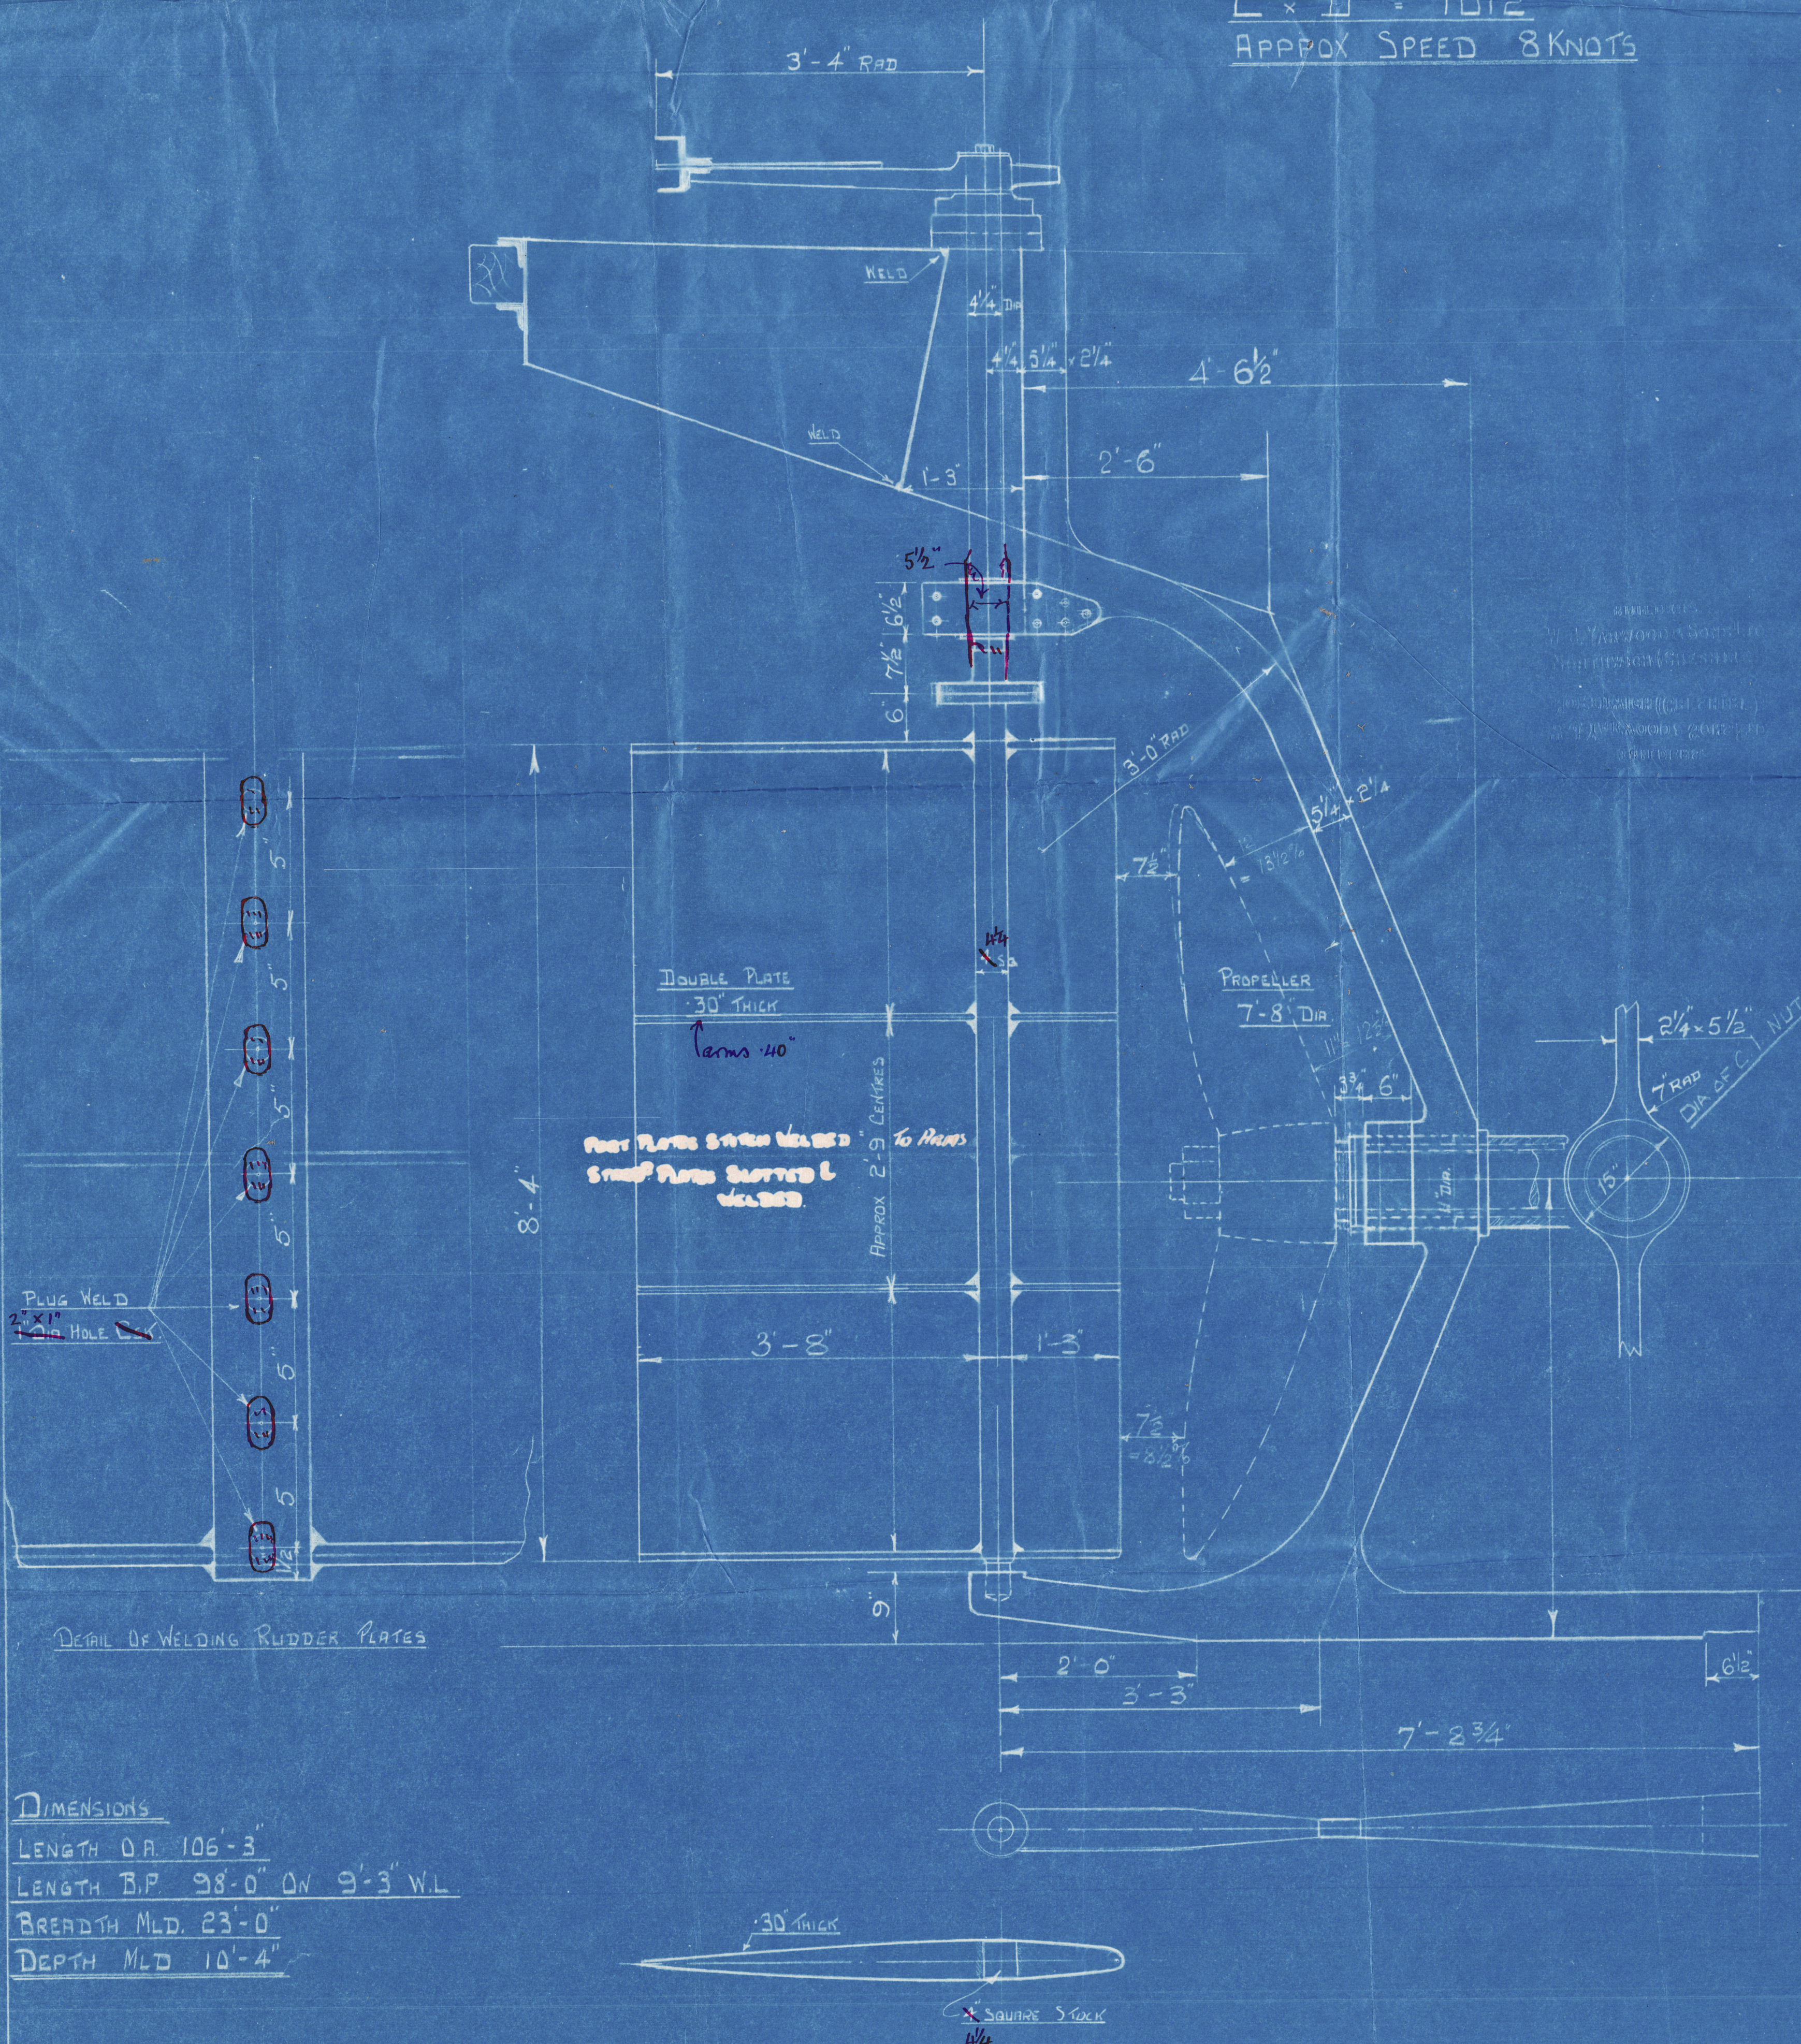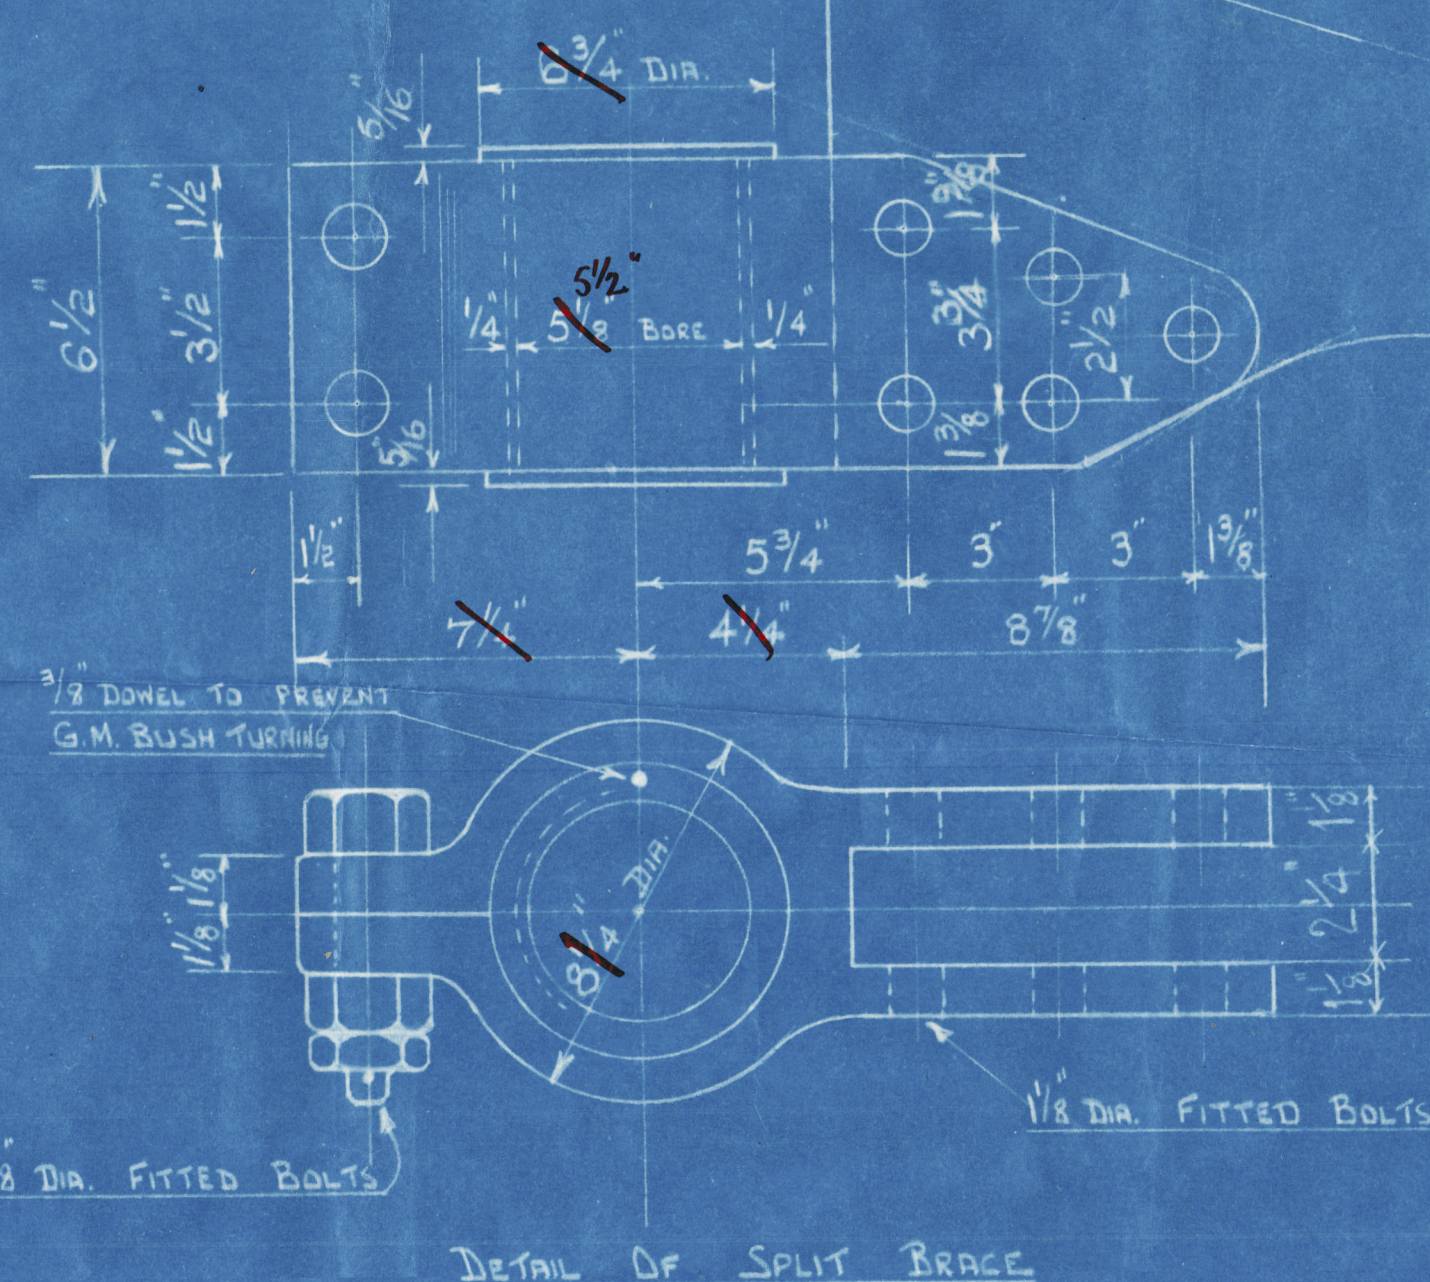

DETAIL OF WELDING RUDDER PLATES


DIMENSIONS

LENGTH O.A. 106'-3"

LENGTH B.P. 98'-0" ON 9'-3" W.L.

BREADTH MLD. 23'-0"

DEPTH MLD. 10'-4"

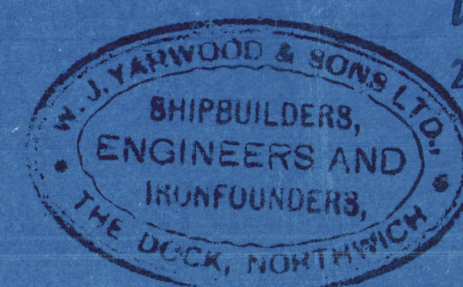


PRINT No. 6887
DATE 5-1-98

W.J. YARWOOD & SONS LTD
THE DOCK
NORTHWICH DATE: 28-12-42

Vessel 759
DRG No 5766

DRAWN BY CHECKED BY
INDEXED BY GF.

Report No. 121376

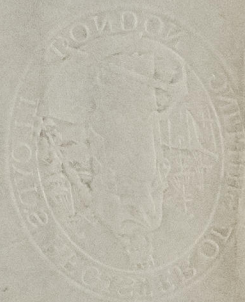

759/60
stem frame

&
Rudder
Approved
S. S. Empire Barnaby

LIVERPOOL

Report No. 121600.

S. S. Empire Fulham

LIVERPOOL

008831-008838-0220

Report No. 121876.



Lloyd's Register
Foundation