


DECK CALVANISED CHEQUERED STEEL.  
THICKNESSES GIVEN ARE UNDER CHEQUER.

NOTE:- DECKS OVER CREW SPACES WILL NOT BE TIMBER SHEATHED  
IN LIEU. NONCONDUCTING MATERIAL WILL BE FITTED UNDER DECK.

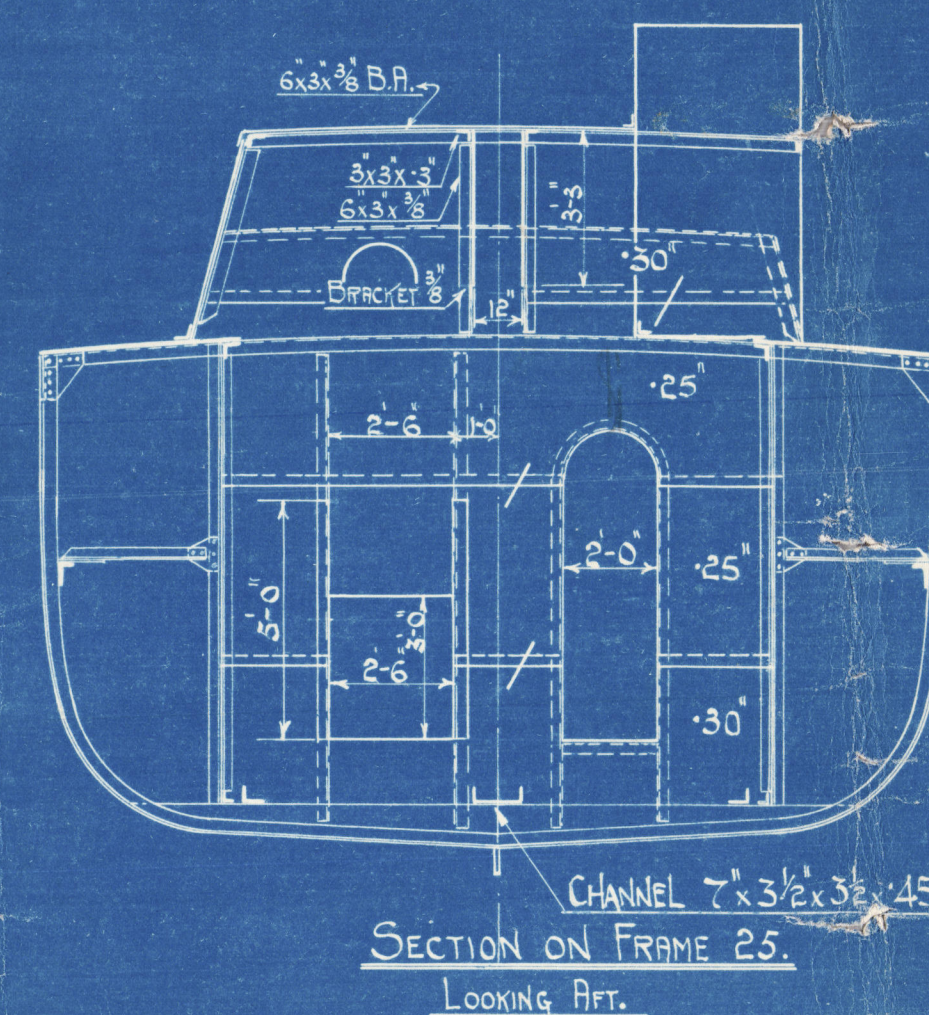

G. L. L.  
his.  
28.11.23

LENGTH 85'-6" O.A.  
" 80'-3" B.P.  
BREADTH 19'-0" MOULDED  
DEPTH 10'-3" "

# GENERAL STEELWORK PLAN FOR STEEL SCREW TUG.

SCALE 1/4" = 1 FOOT.

W. J. YARWOOD & SONS LTD  
THE DOCK.  
NORTHWICH.                      Nov 6<sup>TH</sup> 1923.

DRG: № 2182./A6.

DRAWN BY.	INDEXED BY.
TRACED BY.	CHECKED BY.

008831-008838-0246



Amended Profile & Deck

Steel Sums Eng.

Larwood No 338

351

S.S. Stanlow

LIVERPOOL

Report No. 87254

S.S. Keela

LIVERPOOL

Report No. 90820

9420-858800-128800

008831-008838-0246