


18.5.11
19.8.11

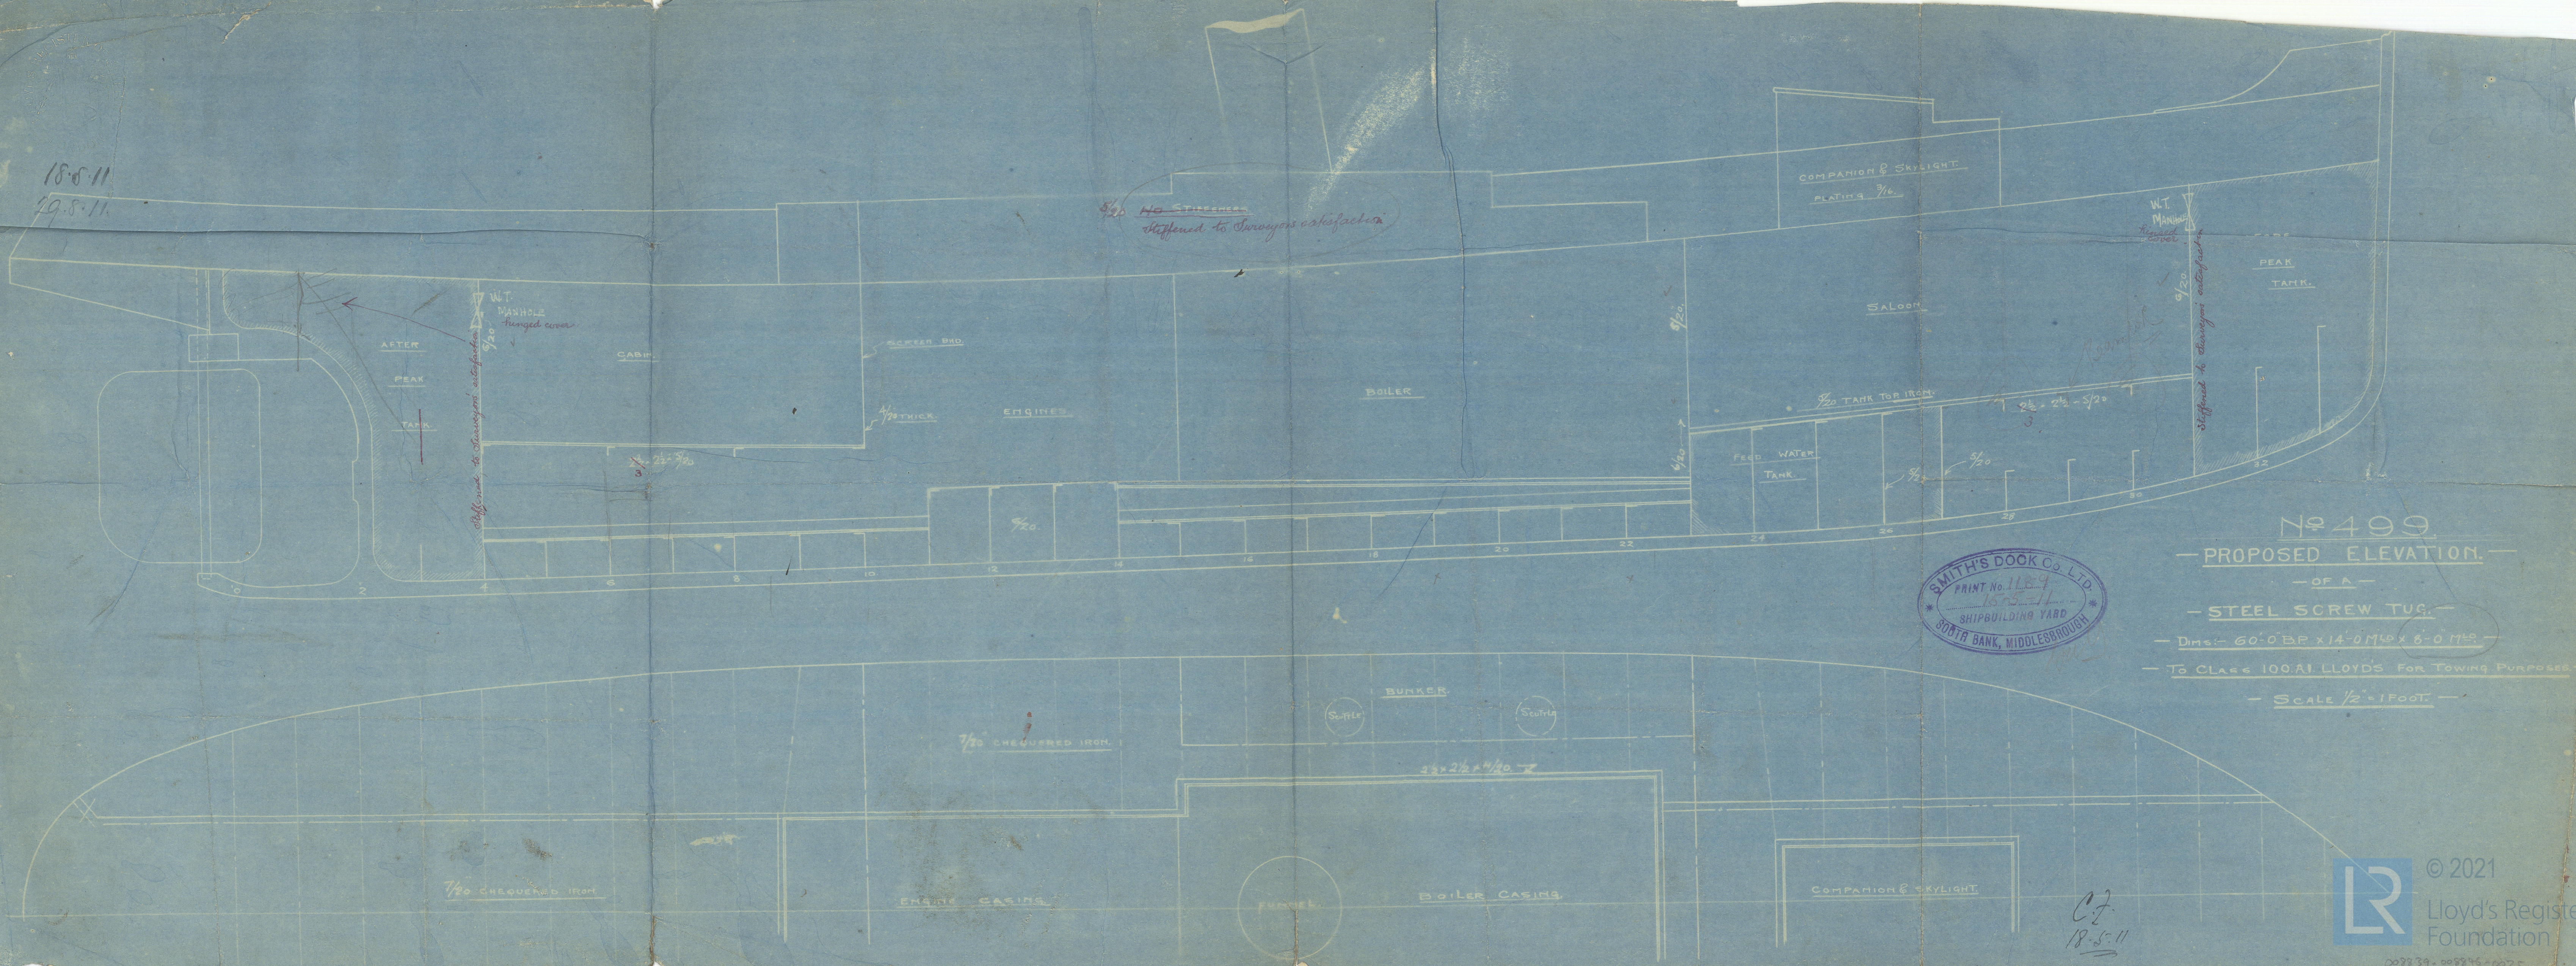

No 499
— PROPOSED ELEVATION. —

— OF A —
— STEEL SCREW TUG. —

— Dims: 60'-0" BP x 14'-0" MLD x 6'-0" MLD. —

— TO CLASS 100 AL LLOYD'S FOR TOWING PURPOSES. —

— SCALE 1/2" = 1 FOOT. —

C.F.
18.5.11

499


PROFILE DECK PLAN

499

Screen. Aug.

S. S. Smiths Dock No 3

Draw. Rpt. No. 7/74.

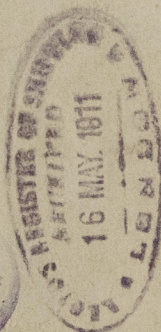

808 108
Allan
W. J. A.



© 2021

Lloyd's Register
Foundation

008839-008846-0035

008846-0035