


S.S. N^o 145.

MIDSHIP SECTION.

SCALE, $\frac{1}{2}$ " = 1 FOOT.

9.8.01
15.8.01
17.8.01
11.10.01
22.10.01

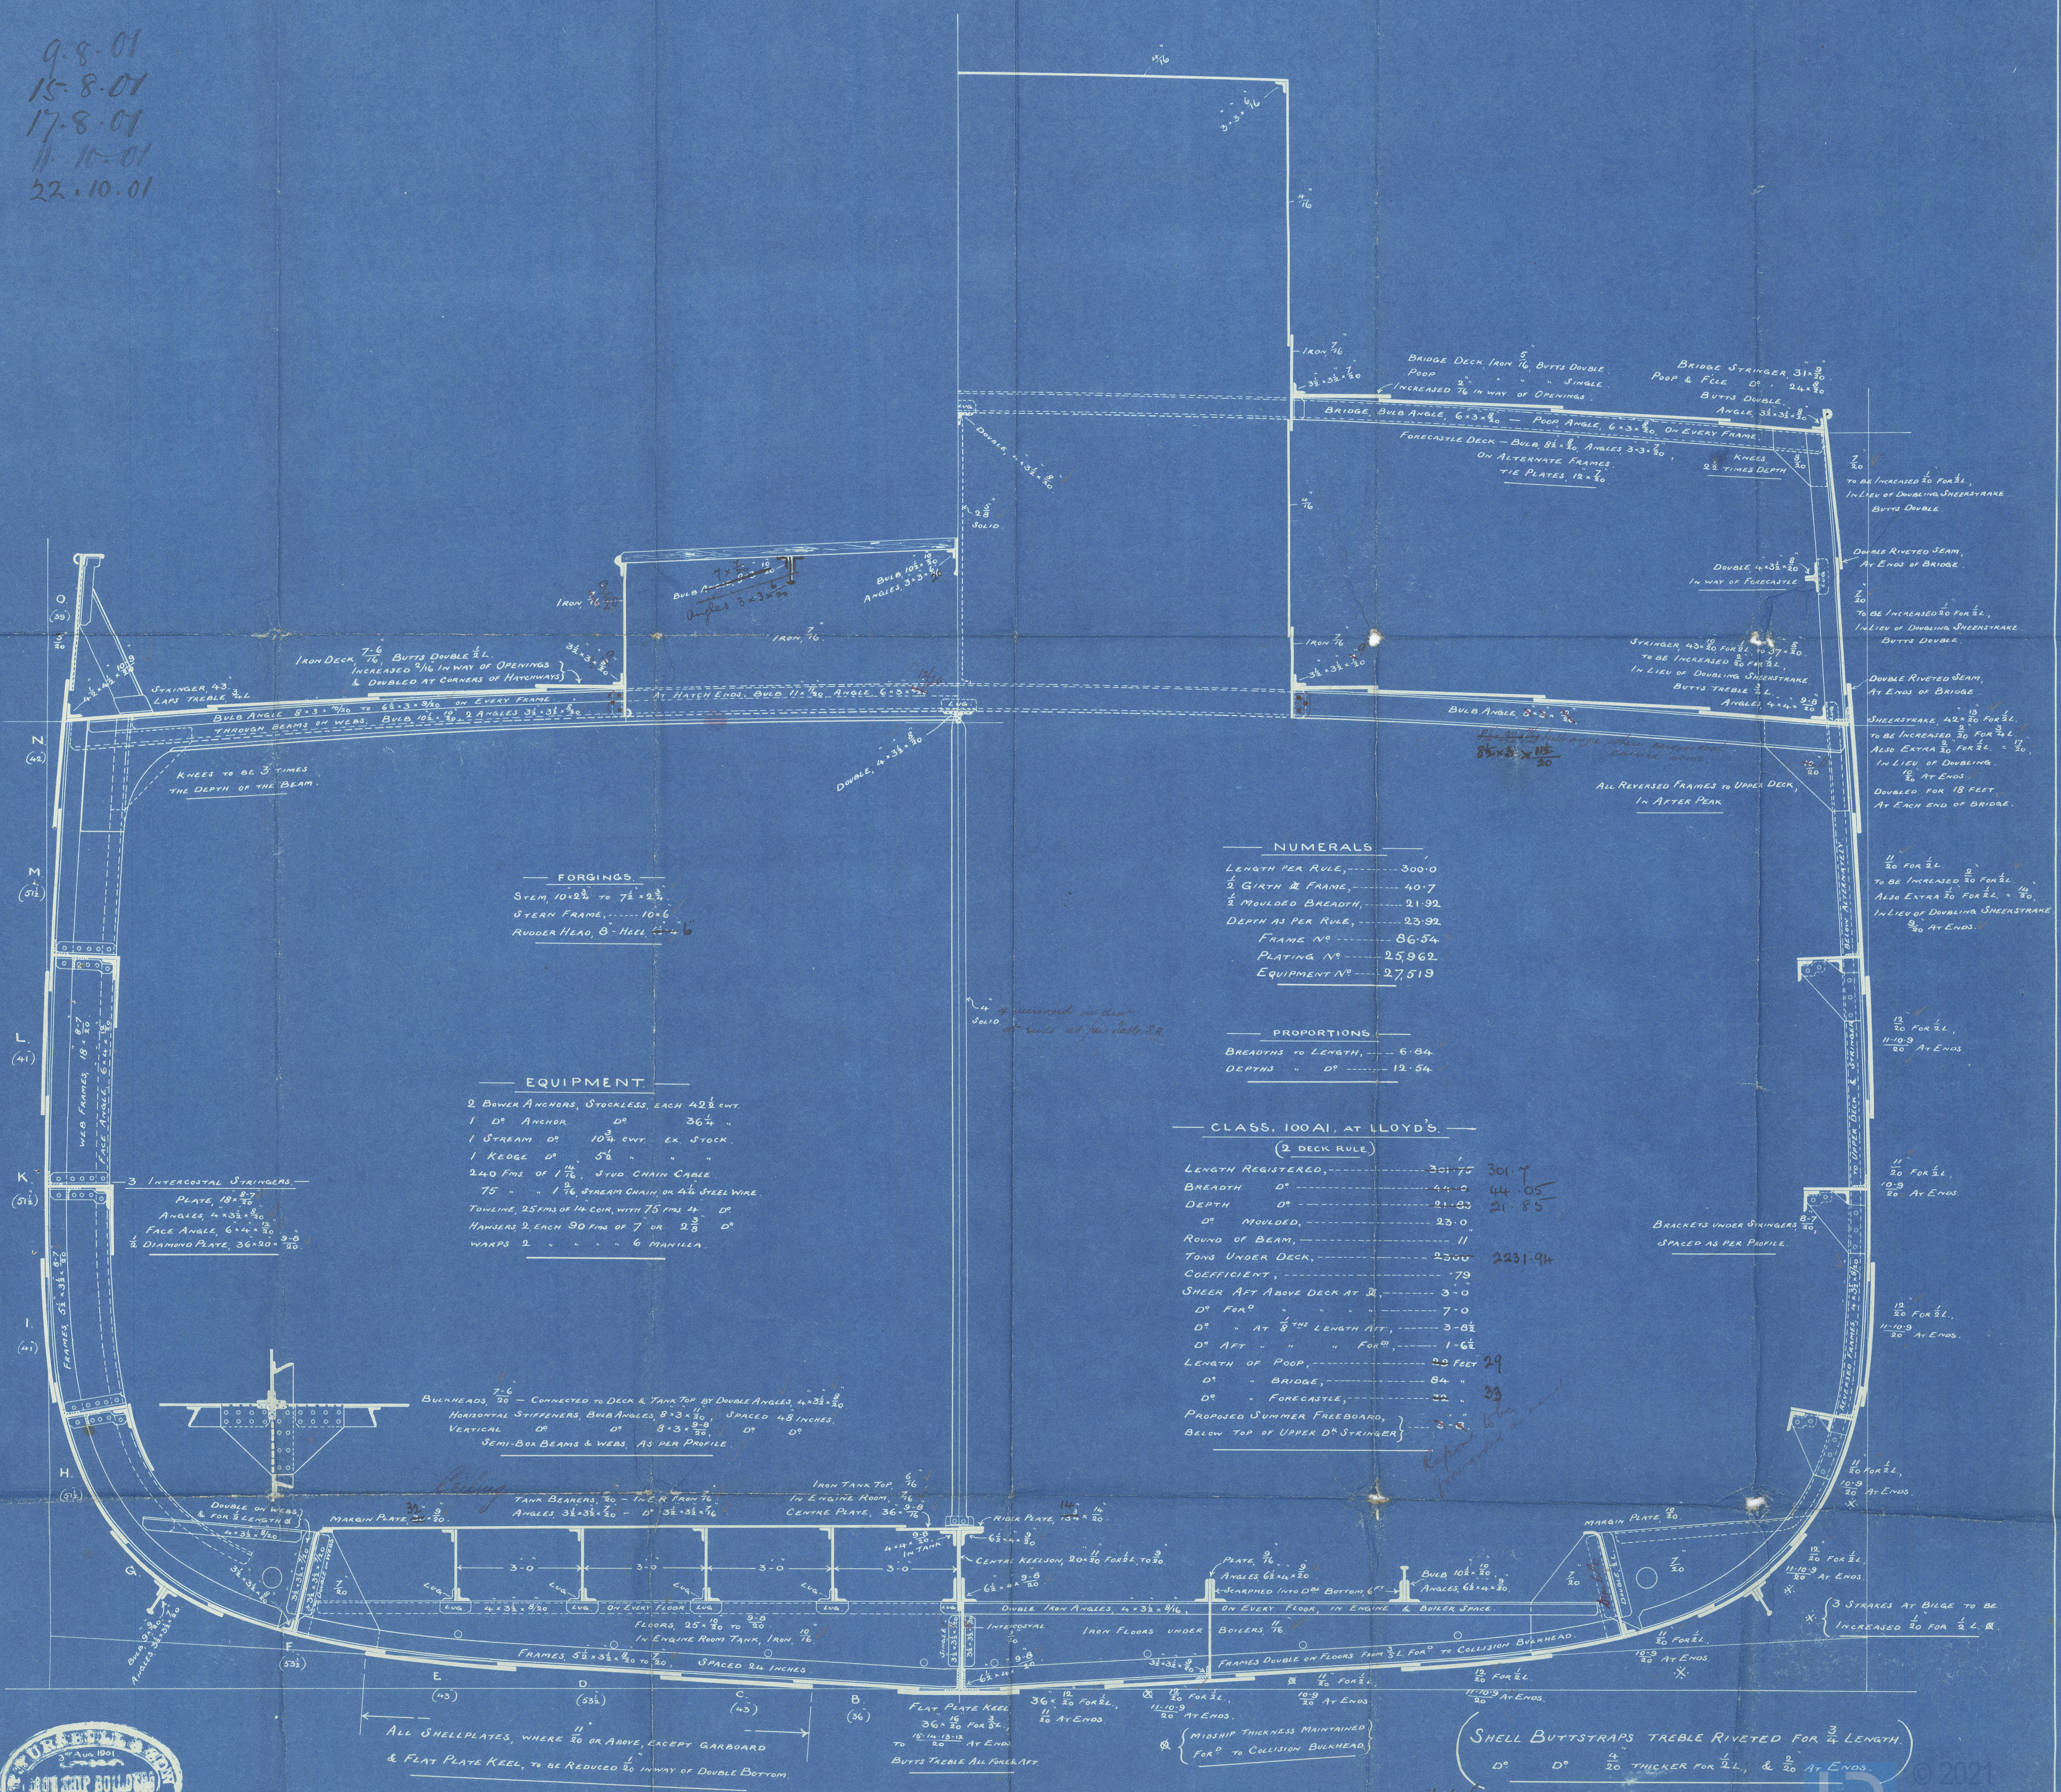

FORGINGS.

STEM, 10" x 2 1/2" to 7 1/2" x 2 1/2".
STEM FRAME, 10" x 6".
RUDDER HEAD, 8" x 11" x 4"

EQUIPMENT.

2 POWER ANCHORS, STOCKLESS, EACH 42 1/2 CWT.
1 D° ANCHOR, 36 1/4".
1 STREAM D°, 10 3/4 CWT. EX. STOCK.
1 KEEDGE D°, 5 1/2".
240 FMS OF 1 1/2", STUD CHAIN CABLE.
75" OF 1 1/2" STREAM CHAIN OR 4 1/2" STEEL WIRE.
TOWLINE, 25 FMS OF 1 1/2" COIL, WITH 75 FMS OF D°.
HAWSERS, 2 EACH 90 FMS OF 7 OR 2 3/8" D°.
WARPS, 2 " " " 6 MANILA.

NUMERALS.


LENGTH PER RULE, 300.0
1/2 GIRTH & FRAME, 40.7
1/2 MOULDED BREADTH, 21.92
DEPTH AS PER RULE, 23.92
FRAME N° 86.54
PLATING N° 25.962
EQUIPMENT N° 27.519

PROPORTIONS.

BREADTHS TO LENGTH, 6.84
DEPTH " " 12.54

CLASS, 100A1, AT LLOYD'S.
(2 DECK RULE)

LENGTH REGISTERED,	301.7	301.7
BREADTH " "	44.2	44.05
DEPTH " "	21.83	21.85
D° MOULDED,	23.0	
ROUND OF BEAM,	11	
TONS UNDER DECK,	2300	2231.94
COEFFICIENT,	.79	
SHEER AFT ABOVE DECK AT 2,	3.0	
D° FOR,	7.0	
D° AT 1/8 TH LENGTH AFT,	3.82	
D° AFT " " FOR,	1.62	
LENGTH OF POOP,	22 FEET	29
D° BRIDGE,	84	
D° FORECASTLE,	32	33
PROPOSED SUMMER FREEBOARD,	3.0	
BELOW TOP OF UPPER D° STRINGER,		

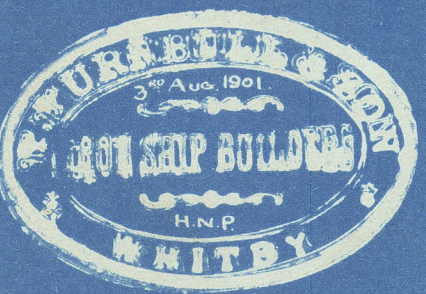






J. Turnbull & Son's

No. 145

Midship Section

'Broomfield'

Hpl. Report to 11845

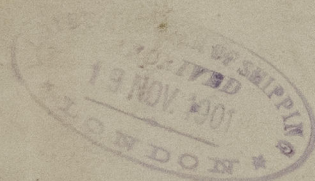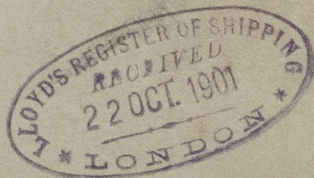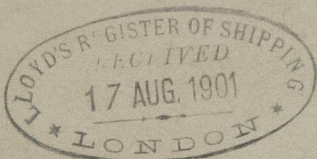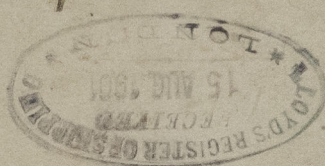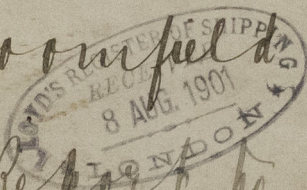

© 2021

Lloyd's Register
Foundation

008839-008846-0147