


9.8.01  
15.8.01  
17.8.01  
17.10.01

PROPOSED LONGITUDINAL SECTION.

S.S. N<sup>o</sup> 145.

Scale  $\frac{1}{8}$ " = One foot.

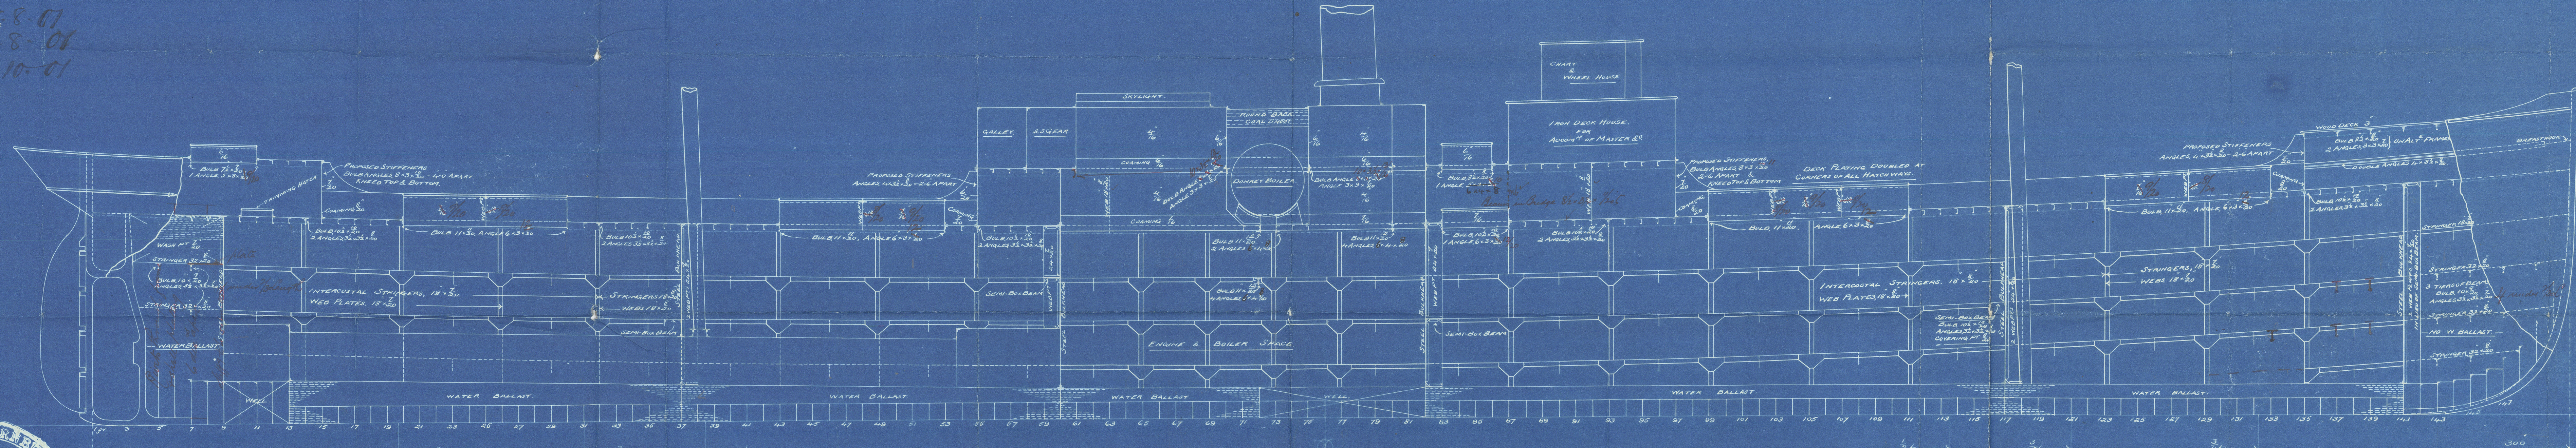




15/8/01  
17/8/01




J. Turnbull & Son  
No 145  
Profile

"Kroomfield"  
Hpl Report No. 11845.

"Show Betty H"  
Betty

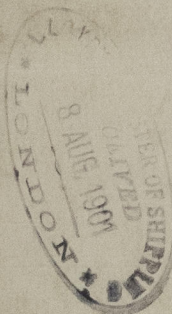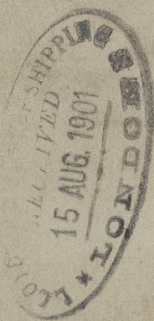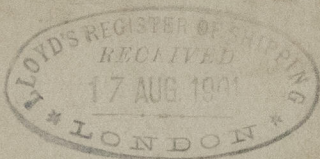

J. Turnbull & Son's  
Hpl. 145-  
Profile

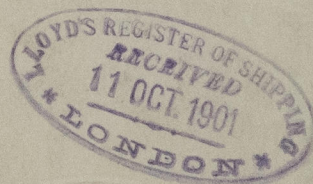

© 2021

Lloyd's Register  
Foundation