

S.S. "Jugenna" Report No. 14447

S.S. N° 156

JOHN READHEAD & CO.
Shipbuilders.
SOUTH SHIELDS.

Quarter Deck exceeding $\frac{1}{4}$ vessel's length to be strengthened
in way of break as per rule.

Class 100 A.

$\frac{1}{2}$ Girth	32.01
$\frac{1}{2}$ Breadth	16.27
Depth	19.60
	<u>67.88</u>
	243
	<u>20364</u>
	27152
	<u>13576</u>
	16494.84

12 + 13 Depth

Equipment No. 18143


Forecastle beams $6 \times \frac{1}{16}$ bulbs
" " $2 \times 2 \times \frac{1}{16}$ angle

After Ballast Tanks 40.11 long
Fore " " 97.9

20/8/79

Keel $8 \frac{1}{2} \times 2 \frac{1}{2}$
Stem $8 \times 2 \frac{1}{2}$
Post 10×4 . Head $8 \times 2 \frac{1}{2}$

22/8/79

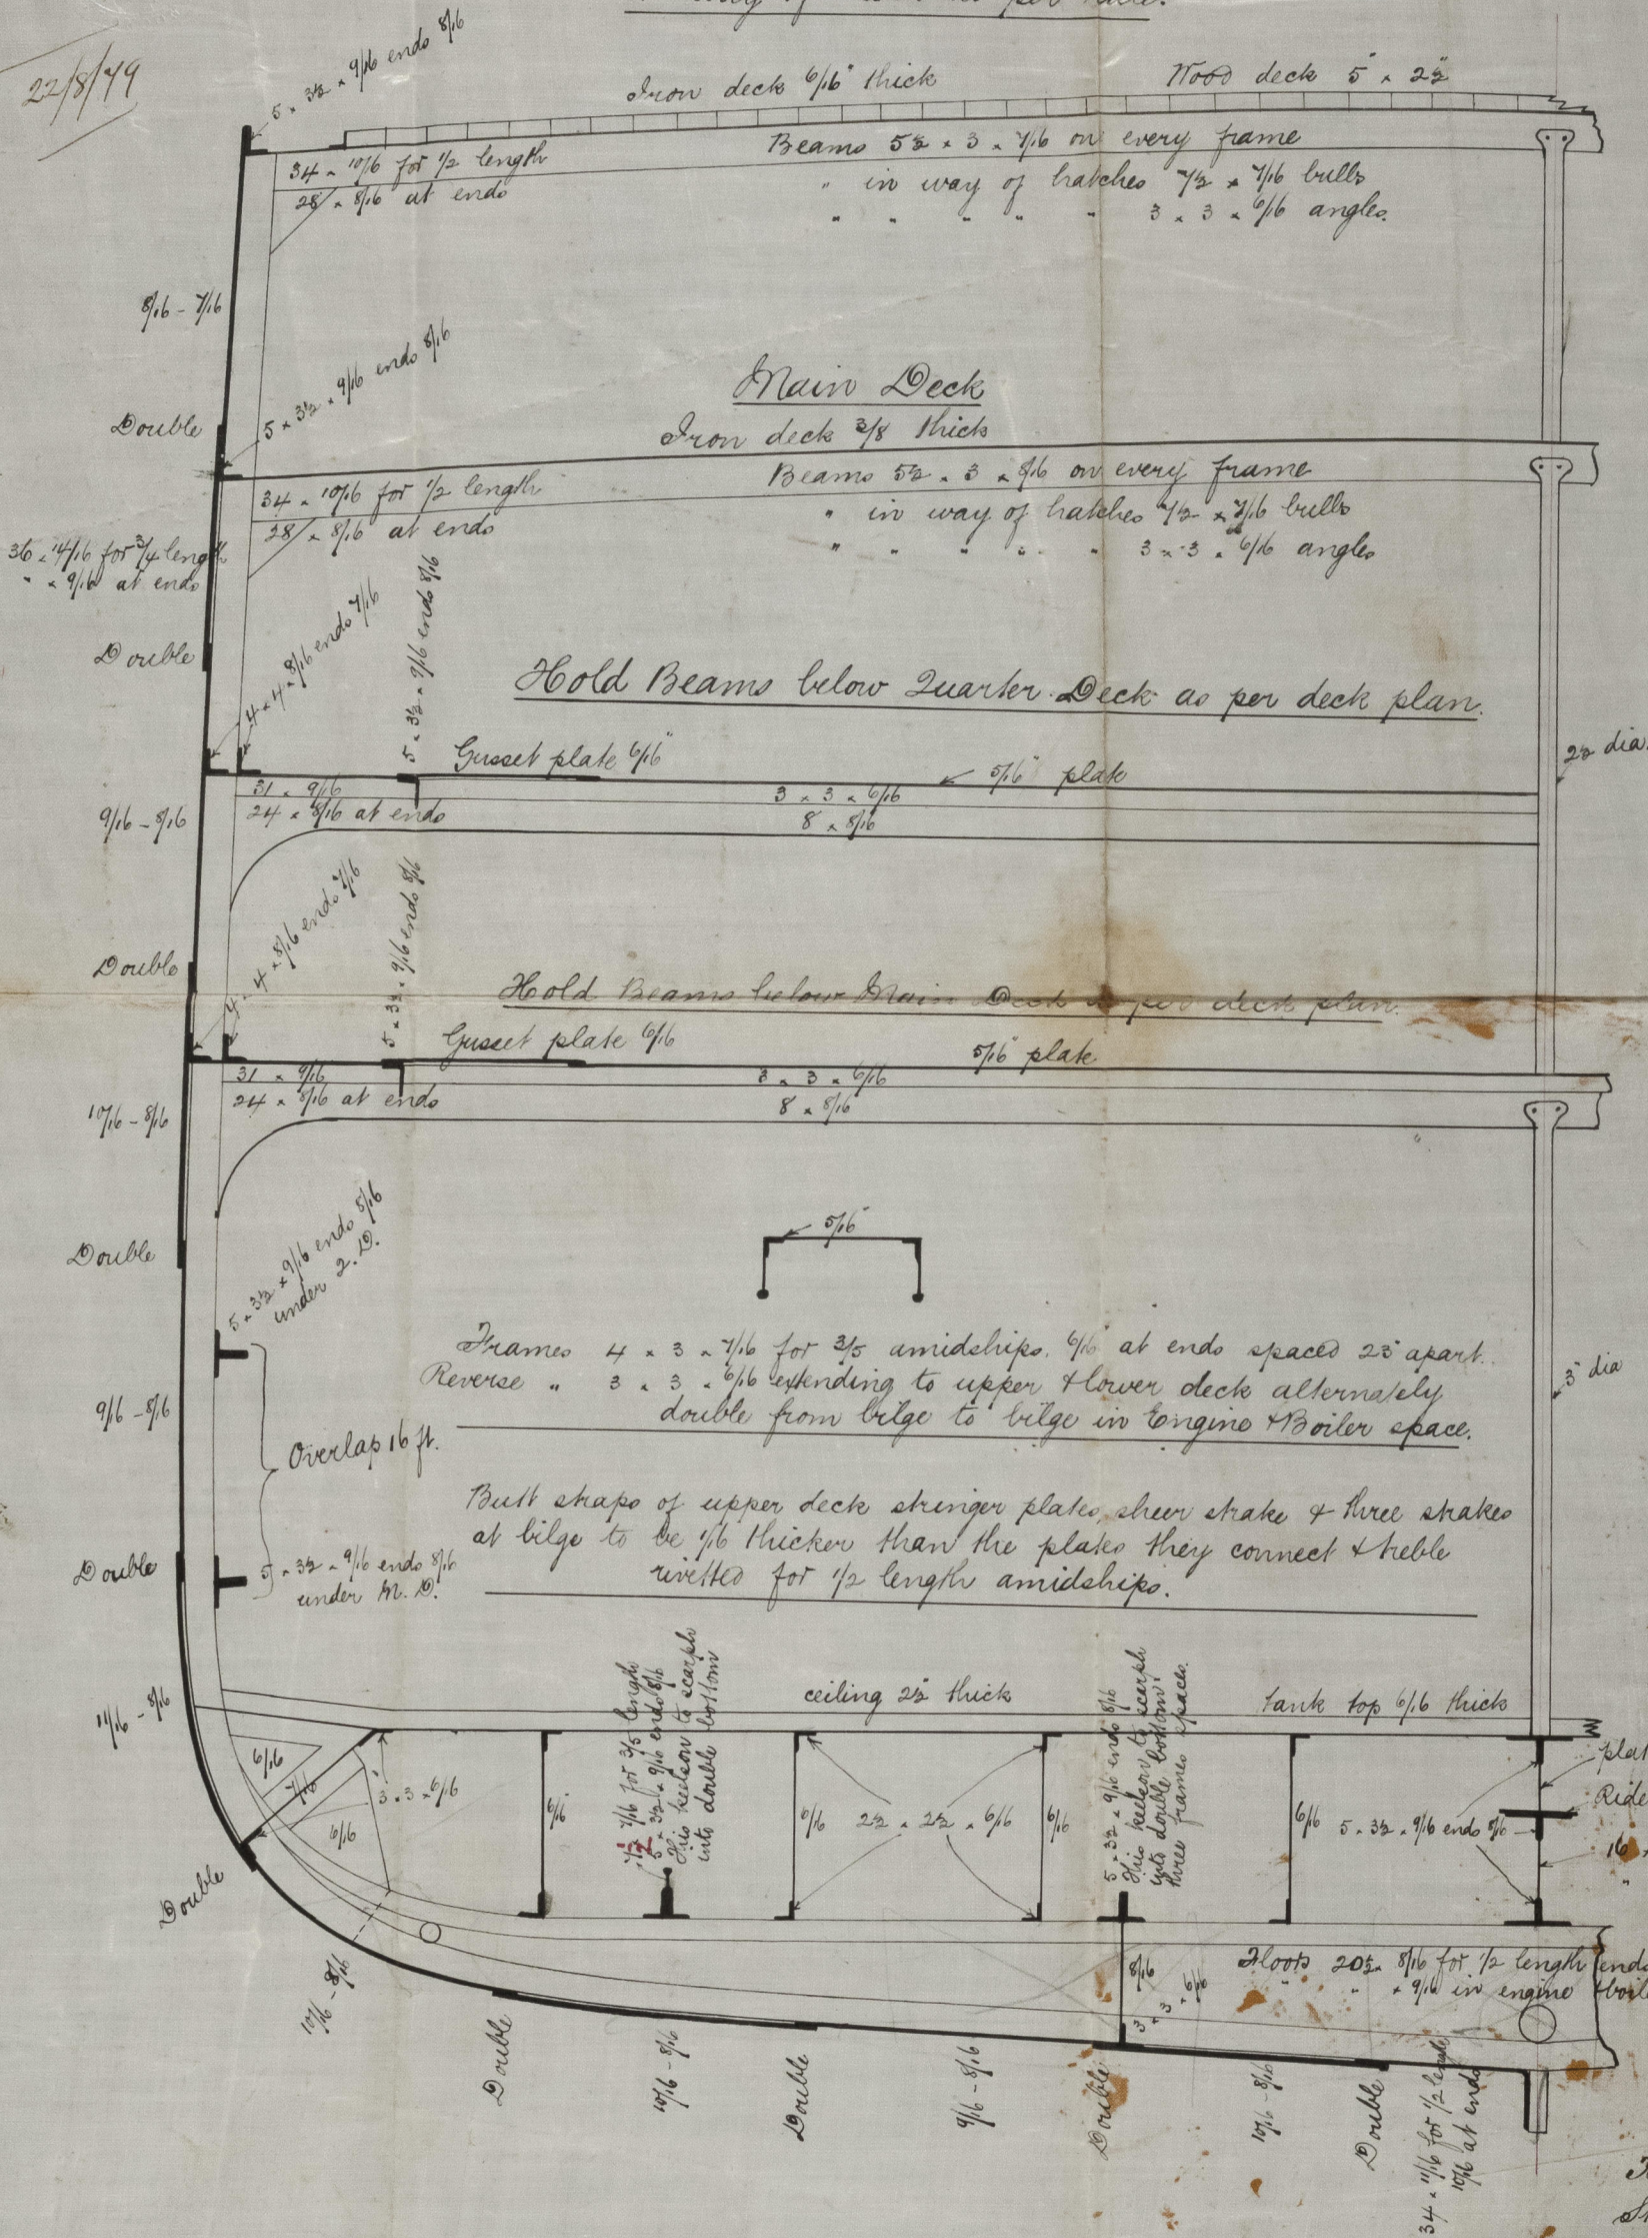

22/8/79

Lloyd's Register
Foundation