

# MIDSHIP SECTION

## T.S.S. N° 783

NOTE.

THE FOLLOWING QUANTITIES ARE SPECIFIED ABOVE LLOYD'S.

STOCKLESS ANCHORS TO BE 20% HEAVIER THAN LLOYD'S REQUIREMENTS.

AN EQUIVALENT WEIGHT OF 3/20 INCREASE ON UPPER AND SHELTER DECK.

13.4.06 AND SHELTER DECK SHEERSTRAKES AND INTERMEDIATE STRAKE INCREASED 3/20 FOR 215 FEET.

8.5.06 TWO BILGE STRAKES INCREASED 3/20 + STRAKE ABOVE THESE INCREASED 3/20 FOR 200 FEET.

11.5.06 TANK TOP IN BOILER SPACE (AT STEEL) INCREASED 3/20 OVER LLOYD'S.

15.6.06.

19.6.06

12.7.06


17.7.06

20.8.06

4.10.06

The scantlings shown on the midship section are those required by the Rules, and do not include the requirements of the specification indicated above.

BUILDERS DIMS 460.0 x 60.0 x 34.0  
LLOYD'S 457.92 x 59.74 x 35.25  
TO CLASS 100 A1 LLOYD SHELTER DECK.  
SCALE 1/2" = 1 FOOT.

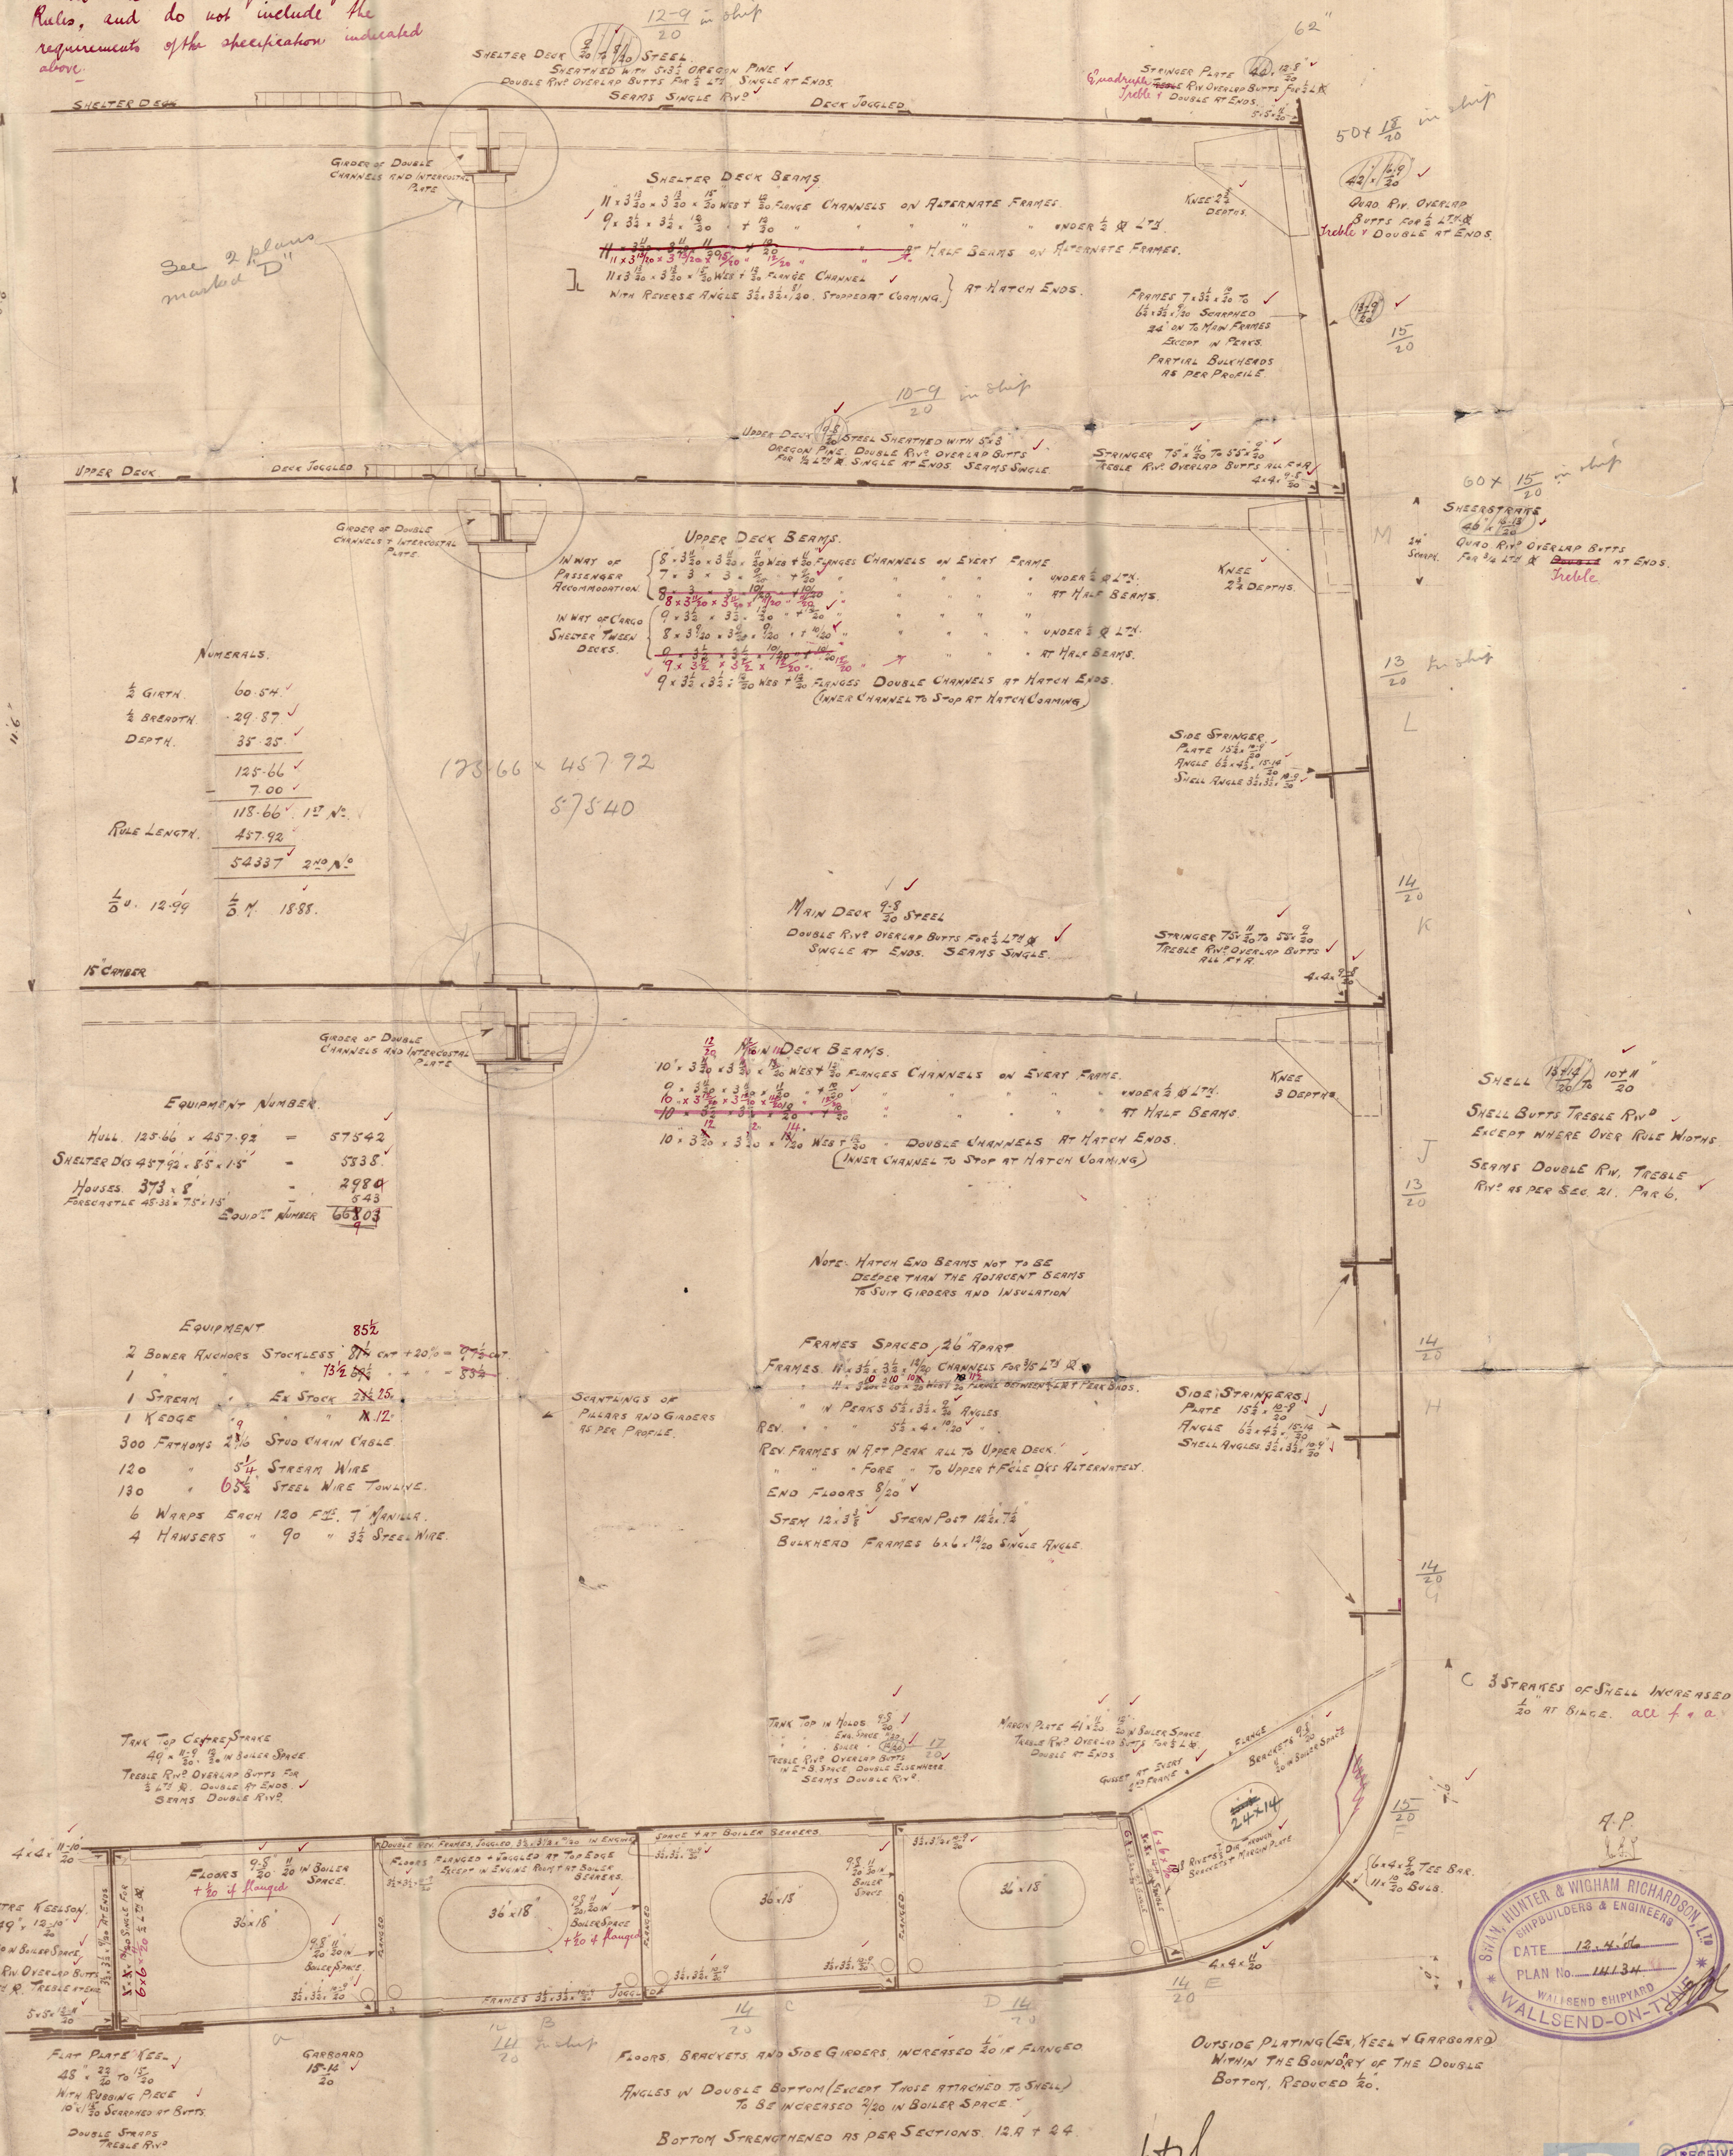

NUMERALS.

1/2 GIRTH.	60.54
1/2 BREADTH.	29.87
DEPTH.	35.35
	125.66
	7.00
RULE LENGTH.	118.66' 12" N°.
	457.92
	54337 210 N°.
1/2 12.99	1/2 N. 1885.

EQUIPMENT NUMBER.

HULL 125.66 x 457.92	=	57542
SHELTER DECK 457.92 x 59.74	=	57335
HOUSES 373.8	=	2984
FORECASTLE 45.36 x 75.15	=	543
QUARTER NUMBER		66803

EQUIPMENT 85 1/2

2 BOWER ANCHORS STOCKLESS 7 1/2" dia x 20" = 7 1/2" dia	
1 Stream	EX STOCK 3 1/2" dia
1 KEDGE	9" dia
300 FATHOMS 1 1/2" STUD CHAIN CABLE	
120 " 5/8" STEEL WIRE	
130 " 3/4" STEEL WIRE TOWLINE	
6 WARPS EACH 120 FEE. 7 MANILLA	
4 HAWSERS " 90 " 3/4" STEEL WIRE	

TANK TOP COFFER SPACE  
40' x 11' 8" IN BOILER SPACE  
TREBLE RIV OVERLAP BUTTS FOR 1/2" R. DOUBLE RIV. ENDS  
SEAMS DOUBLE RIV.

CENTRE KEELSON  
49' x 12' 10" dia  
130 N BILGE SPACE  
QUARTER RIV OVERLAP BUTTS FOR 1/2" R. TREBLE RIV. ENDS

FLAT PLATE KEEL  
48' x 22' 15" dia  
WITH RIBBING PLATE  
10' x 30" SCREWED AT BUTTS  
DOUBLE STRIPS  
TREBLE RIV



GARGBOARD  
18' 12" dia

FLOORS, BRACKETS AND SIDE GIRDERS INCREASED 20% IF FLANGED  
ANGLES IN DOUBLE BOTTOM (EXCEPT THOSE ATTACHED TO SHELL)  
TO BE INCREASED 20% IN BOILER SPACE  
BOTTOM STRENGTHENED AS PER SECTIONS 12.9 & 24.





Newcastle  
Swan Hunter & Wigham Richardson Ltd.  
S.S. No 483  
Middish Section




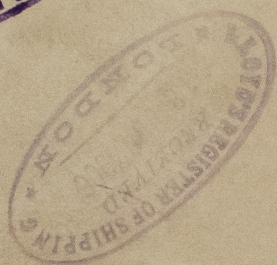
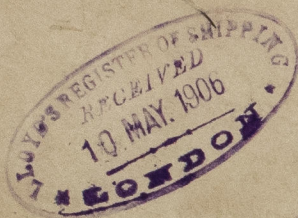


S.S. Arawa  
Newcastle R. out  
520 52309.

008863-008870-0036

783

520 52309  
Arawa

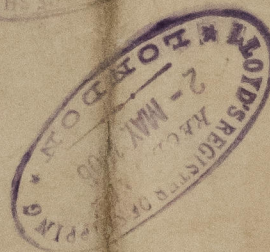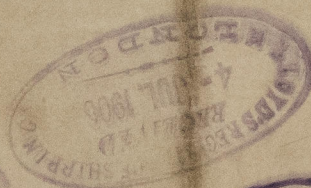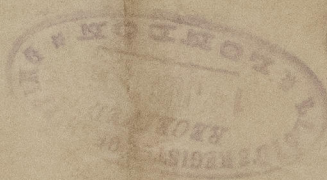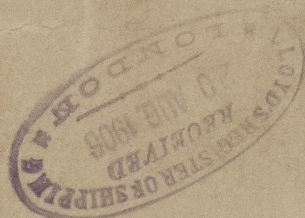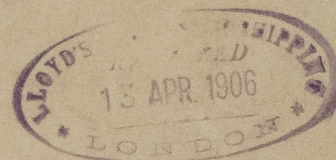

© 2021

Lloyd's Register  
Foundation