


18.5.06

RUDDER HEAD.
✓ PER RILE $10\frac{1}{2}$ "
• FORMULA $10\frac{3}{8}$ "
SPEED AT SEA.
13 KNOTS.

$\frac{5}{38}$ around main piece

FORGED STEEL RUDDER
T.S.S. N° 783.

SCALE $\frac{1}{2}$ " = ONE FOOT.

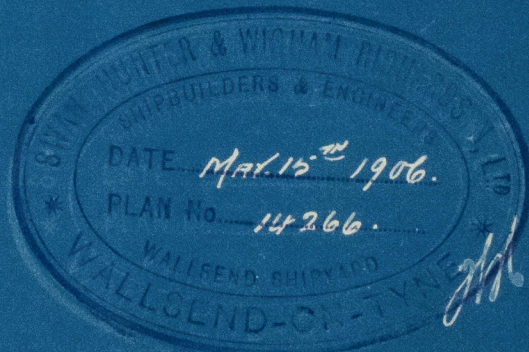

thickness round,
main piece $3\frac{5}{8}$

C.B.
18.506.


S. I. Arawa.

No 52309

FORGED STEEL RUDDER

T. 5.5. № 783.

SCALE $\frac{1}{2}$ " = ONE FOOT.

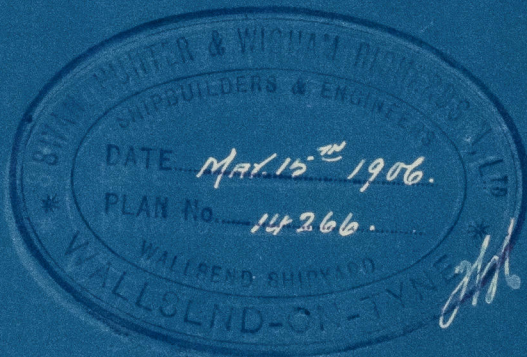

Thickness round
Grain piece $3\frac{5}{8}$ "

C.B.
18.5.06.

RECEIVED
MAY 19 1966
WALLSEND

008863-008870-0037