

23.4.06
3.5.06
8.5.06
15.6.06
19.6.06

PROFILE & DECK PLANS

T.S.S. N^o 783


SCALE $\frac{1}{8}$ " = ONE FOOT

BUILDERS DIMENSIONS 460'0" x 60'0" x 34'0"

LLOYDS 457'9" x 59'4" x 35'25"


TO CLASS 100 A.I. LLOYD'S SHUTTER DR.

FORECASTLE DECK

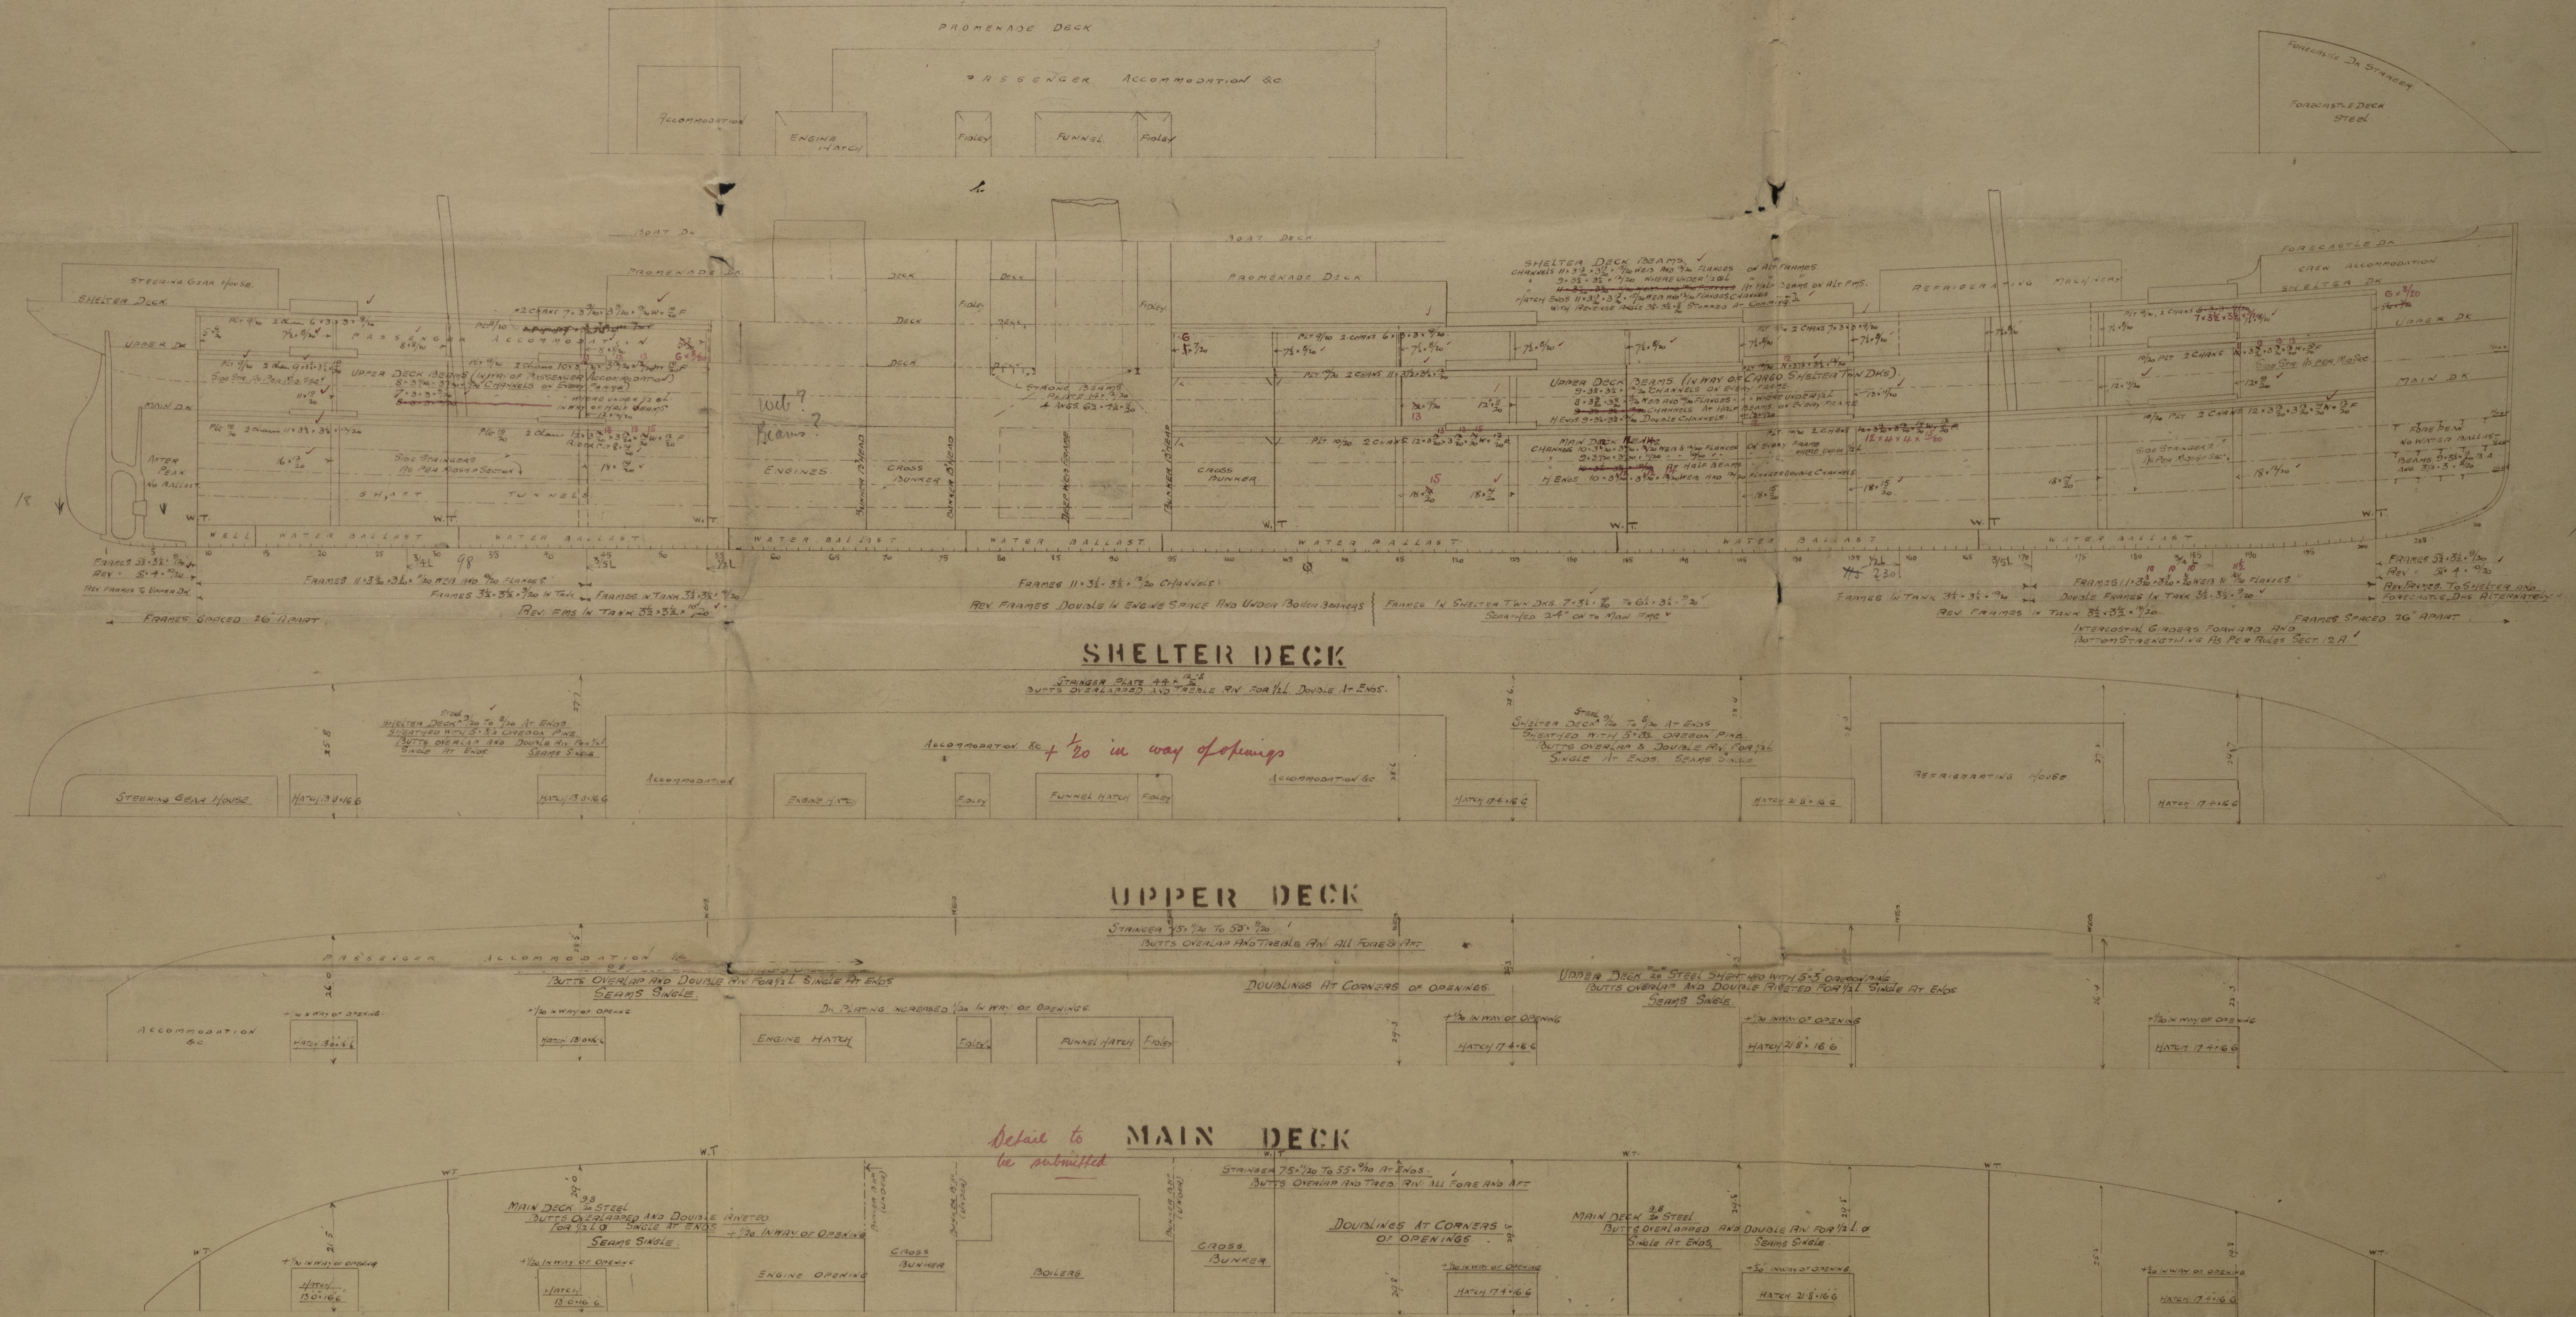

SWAN, HUNTER, & WIGHAM RICHARDSON LTD.

WALLSEND ON TYNE.

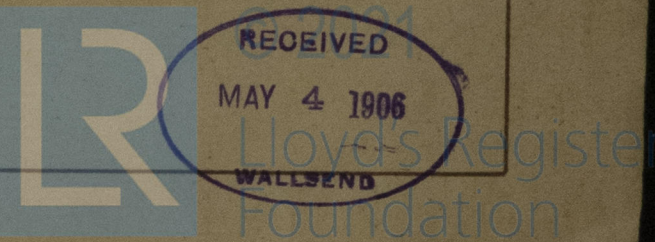



008863-008870-0039

Swan Hunter & Wigham Richardson Ltd
5/5 No 783

Profile + Deck Plan




S. H. Newk.
SS No 783

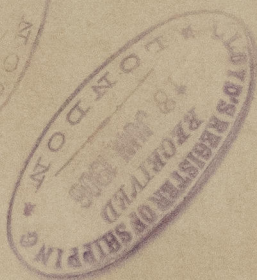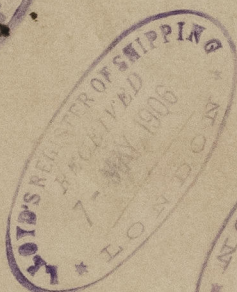

G. G. Arawa

Newcastle Report

No 52309

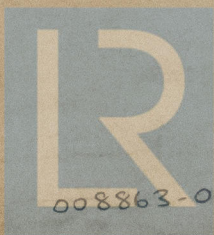

© 2021

Lloyd's Register
Foundation

008863-008870-0039

LONDON



© 2021

Lloyd's Register
Foundation