

SHIP N° 1055  
ENQUIRY N° 8188  
MIDSHIP SECTION  
SCALE  $\frac{1}{2}$  INCH = 1 FOOT

MOULDED DIMENSIONS:- 394'-0" x 53'-6" x 28'-3" TO 2<sup>ND</sup> DECK

CLASS + 100 A. I. LLOYDS. WITH FREEBOARD.


## LLOYDS NUMERALS.

$$\begin{aligned} \underline{D} &= 36.25, \quad \underline{d} = 23.833 \text{ (24.71 TO RULE)} \\ \underline{L \times D} &= 394 \times 36.25 = \underline{14,282.50} \\ \underline{L(B+D)} &= 394(53.50 + 36.25) = \underline{35361.50} \\ \underline{L/D} &= 394/36.25 = \underline{10.87} \end{aligned}$$

## EQUIPMENT NUMERAL.

<u>L (B + D) =</u>					35361.50
<u>HOUSES</u>	22.00	$\times$	7.50	$\times$	.50
					= 82.50
<u>HOUSES</u>	57.00	$\times$	7.50	$\times$	.50
					= 213.85
<u>FORECAST</u>	36.25	$\times$	7.50	$\times$	.75
					= 204.00
					35861.85

### RULE EQUIPMENT.

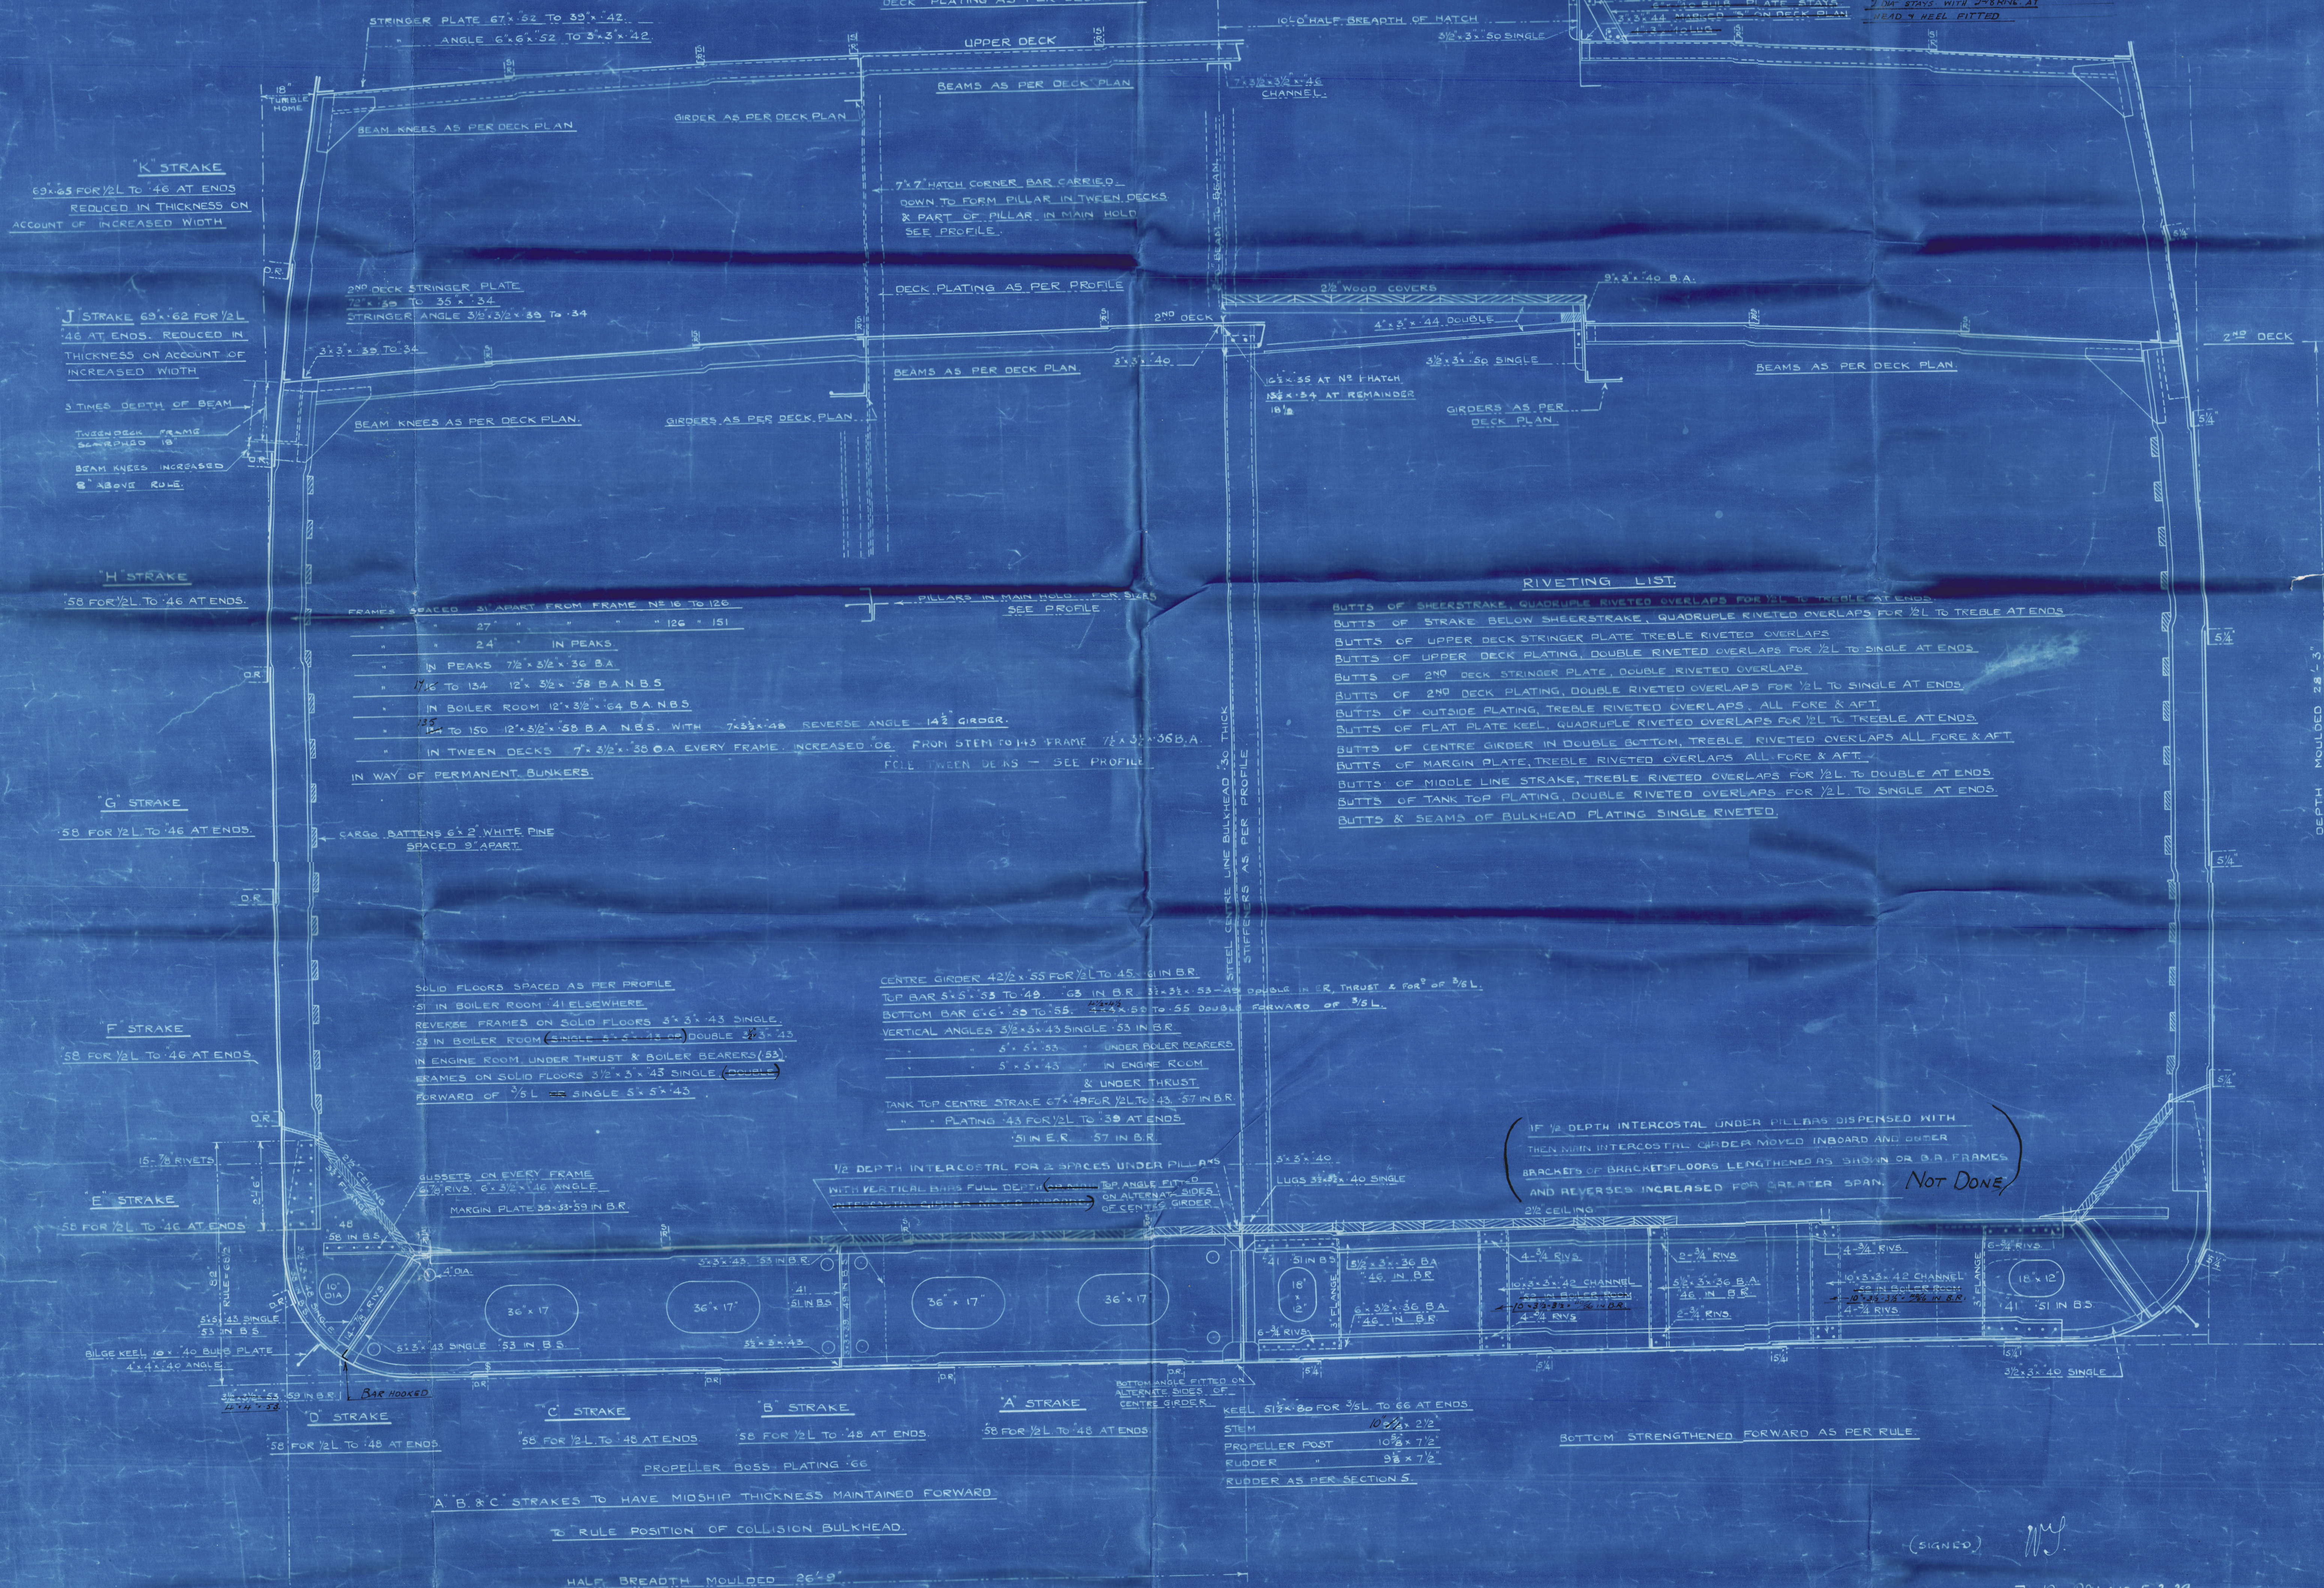




Finished  
Midships Section

WP-1055

Armstrong Whitworth & Co

"Jo Taylor"

---

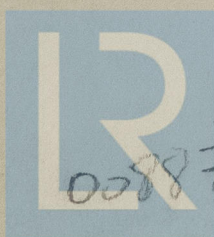

© 2020

008871-008878-0025  
Foundation