

EQUIPMENT NUMBER FOR FLUSH DECK = 26995

INCREASED 26995 FOR POOP ETC = 1800

9.5.06 EQUIPMENT NUMBER = 28795

6.6.06

- EQUIPMENT -

2 BOW ANCHORS 50 CWT. 35 STOCKLESS

1 DE - DE - 4 1/2 - DE - DE - 38 - EX STOCK

1 STREAM ANCHOR 12 - DE - EX STOCK

1 KEDGE - DE - 6 - DE - DE - DE -

370 FATHOMS 2 1/2" STUD CHAIN CABLE

100 - DE - 1 1/2" STREAM CHAIN, OR 4 1/4" STEEL WIRE.

90 - DE - 12" HEMP, OR 4" STEEL WIRE

90 - DE - 11" HAWSERS

90 - DE - 7" - DE -

MIDSHIP SECTION FOR SAILING SHIP. N° 253.

TO CLASS 100 A.I. LLOYDS SPECIAL SURVEY

BUILT OF STEEL

SCALE 1/2" = 1' 0"

LENGTH (LLOYDS') = 287'-4"

BREADTH MOULDED = 45'-9 1/2"

DEPTH MOULDED TO UPPER DK = 26'-5"

- DO - - DO - TO LOWER DK = 18'-8"

1/2 BREADTH = 22.89

1/2 GIRTH = 43.73

DEPTH = 27.33

93.95 = FRAMING NUMBER FOR 2DK RULE

86.95 = FRAMING NUMBER FOR 3DK RULE

287.33 x 93.95 = 26995 = PLATING NUMBER FOR 2DK RULE

287.33 x 86.95 = 24983 = PLATING NUMBER FOR 3DK RULE

RIVETING

7/8 RIVETS THRO' FRAMES TO SHELL PLATING 6 1/4" CTRS.

7 - DO - - DO - - DO - - DO - - DO - IN BALLAST

TANK & FORE AND AFTER PEAK TANKS 5 1/4" CTRS.

3/4 RIVETS THRO' FRAMES TO FLOORS, FLOORS TO TANK TOP

ALSO IN KEELSONS, STRINGERS, BHS STIFFENERS ETC 5 1/4" CTRS.

3/4 RIVETS THROUGH STRINGER & DECK PLATING TO BEAMS 5 1/4" CTRS.

EXCEPT ON UPPER DK IN WELLS ON POOP DK, WHERE BEAMS ARE

ON ALT. FRAMES, 3 RIVETS ARE TO BE SPACED 3 1/4" APART

WT BHS SEAMS & BUTTS OF WT BHS SR 3/4" RY 3 1/2" CTRS 1/2" RY 2 1/2" CTRS

BULKHEAD FRAMES TO SHELL 7/8 RIVETS, SPACED 4 1/2" APART ZIG ZAG

- DO - - DO - TO BHS 3/4 - DO - - DO - 3 1/4 - DO - - DO -

STRINGER & DECK.

BUTTS OF UPPER & LOWER DK STRINGER PLATE

OVERLAPPED AND TR FOR 3/4 L AMIDS, DR AT ENDS.

7/8 RIVETS 3 1/2" CTRS, 3/4 RIVETS 2 1/2" CTRS.

BUTTS OF POOP DK STRINGER PLATE OVERLAPPED & TR FOR 3/4 L

DR AT ENDS. 3 RIVETS 2 1/2" CTRS.

BUTTS OF UPPER, LOWER & POOP DK PLATING OVERLAPPED & DR

FOR 3/4 L AMIDS, 3 R AT ENDS. 3/4 RIVETS 3 1/2" CTRS, 5/8 RIVETS 2 1/2" CTRS.

BUTTS OF POOP DK TIES OVERLAPPED & DR 3/4 RIVETS 3 CTRS.

SEAMS OF UPPER, LOWER & POOP DK PLATING SR 3/4 RIVETS 3-3 1/2" CTRS.

5/8 RIVETS 2 1/2 - 2 3/4 CTRS.

INNER BOTTOM.

BUTTS OF CTR GIRDER OVERLAPPED & TR FOR 3/4 L AMIDS, DR AT ENDS.

7/8 RIVETS 3 1/2" CTRS, 3/4 RIVETS 3 CTRS, BUTTS OF TANK TOP

CTR STRAKE OVERLAPPED & DR 3/4 RIVETS 3 CTRS, BUTTS OF

REMAINING STRAKES OVERLAPPED & DR 3/4 RIVETS 3 CTRS, BUTTS OF

EDGES OF TANK TOP CTR STRAKE DR 3/4 RIVETS 3 CTRS, SEAMS OF

REMAINING PLATING SR 3/4 RIVETS 3 CTRS.

SHELL PLATING.

A STRAKE BUTT STRAPPED & TR FOR WHOLE LENGTH

B - DO - OVERLAPPED & TR FOR 2 L AMIDS TR AT ENDS

C - DO - - DO - & QR - DO - - DO -

D - DO - - DO - & QR - DO - - DO -

E - DO - - DO - & QR - DO - - DO -

F - DO - - DO - & QR - DO - - DO -

G - DO - - DO - & QR - DO - - DO -

H - DO - - DO - & QR - DO - - DO -






I - DO - - DO - & TR FOR WHOLE LENGTH

K - DO - - DO - & TR - DO - - DO -

L - DO - - DO - & TR FOR 2 L IN WAY OF POOP, REMAINDER DR 3/4 RIVETS 2 1/2" CTRS.


M - DO - - DO - & TR - DO - - DO - - DO - - DO -

8 7/8 - DO - 3 1/2" CTRS

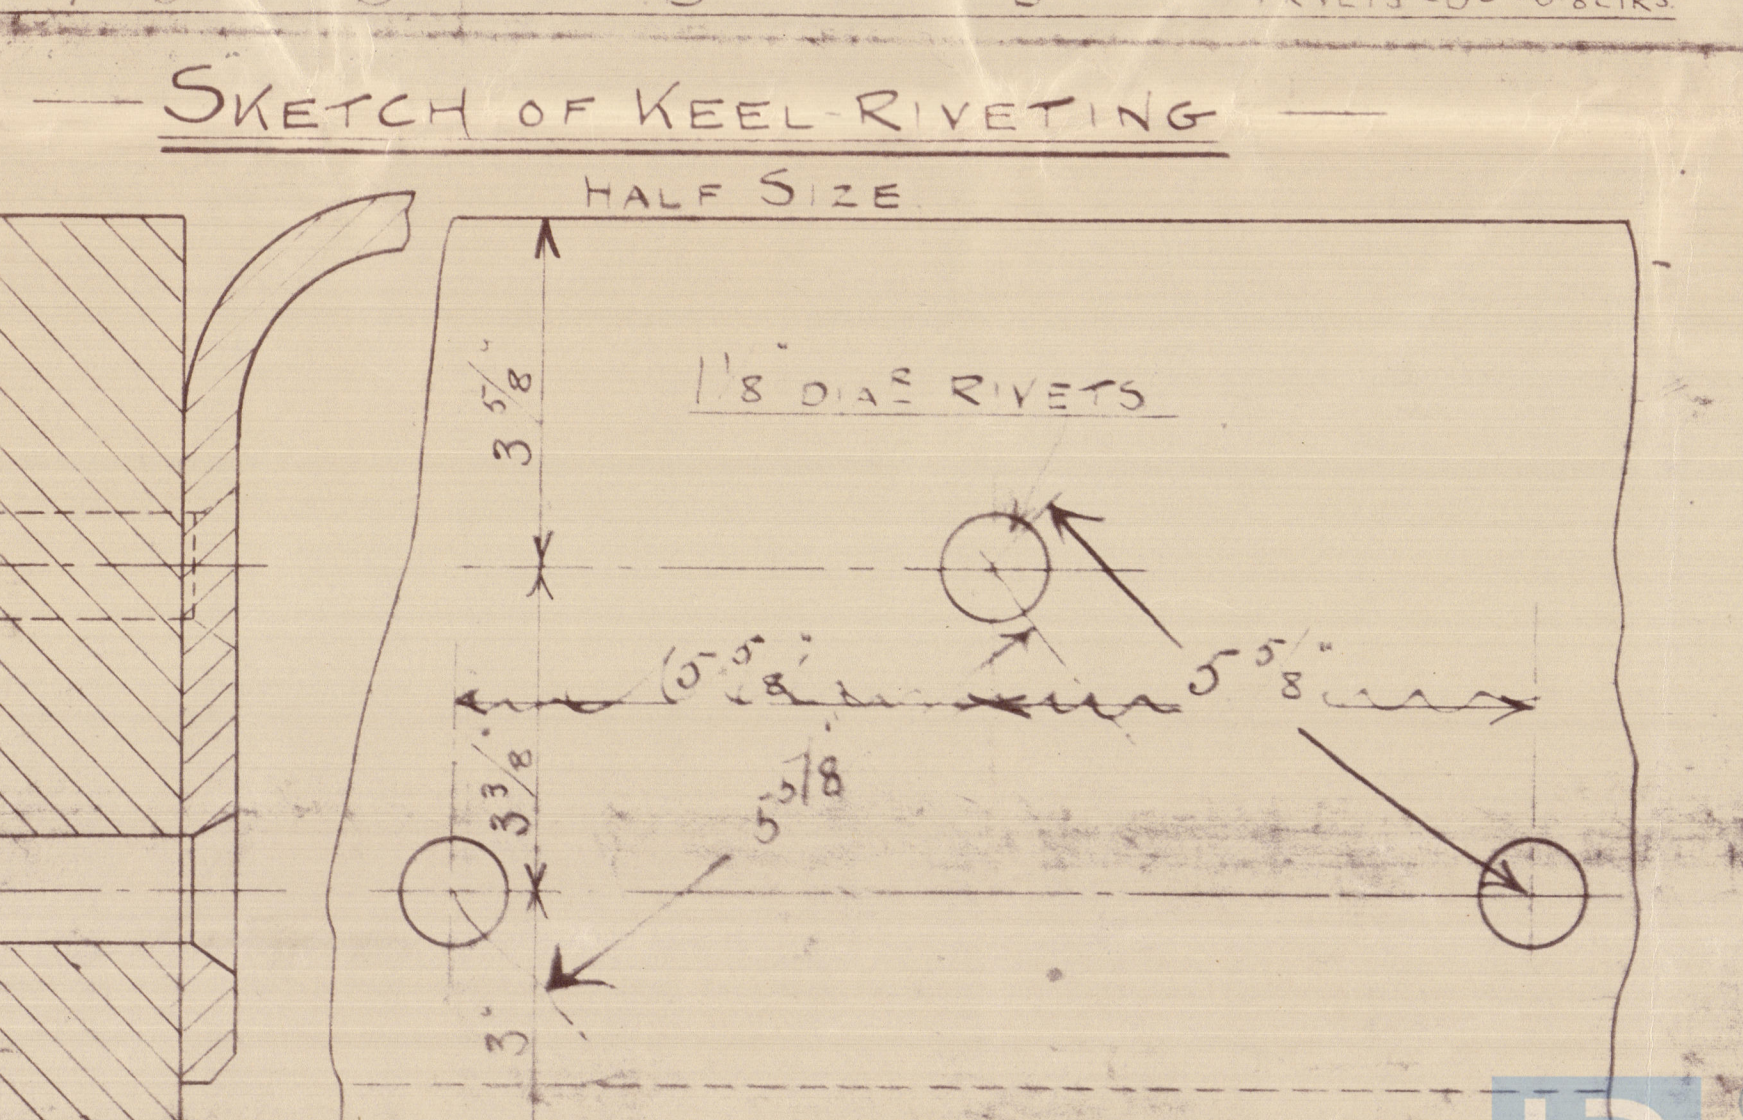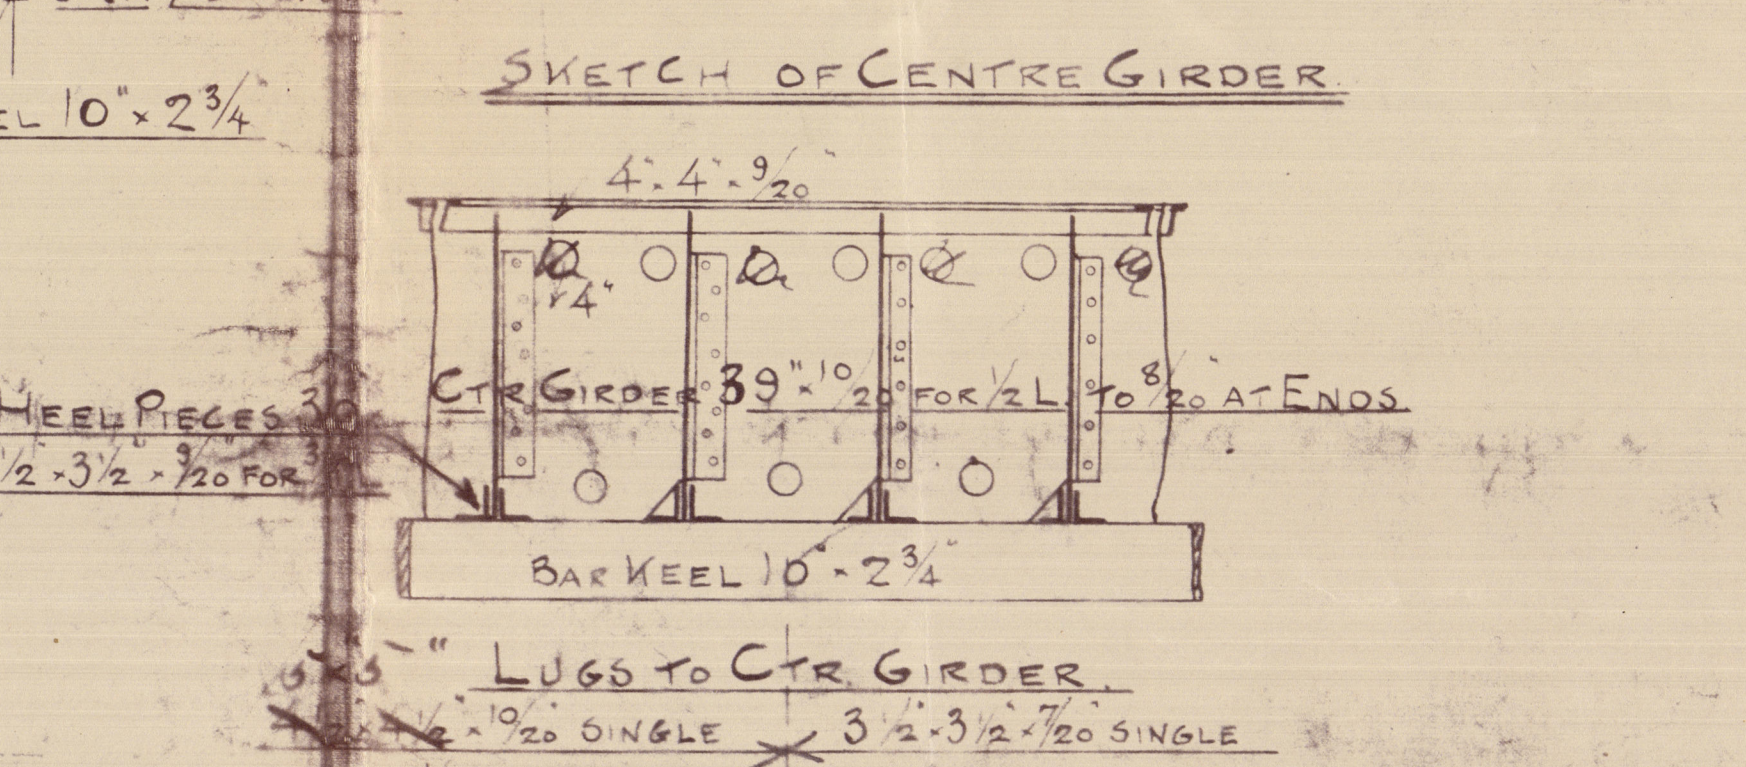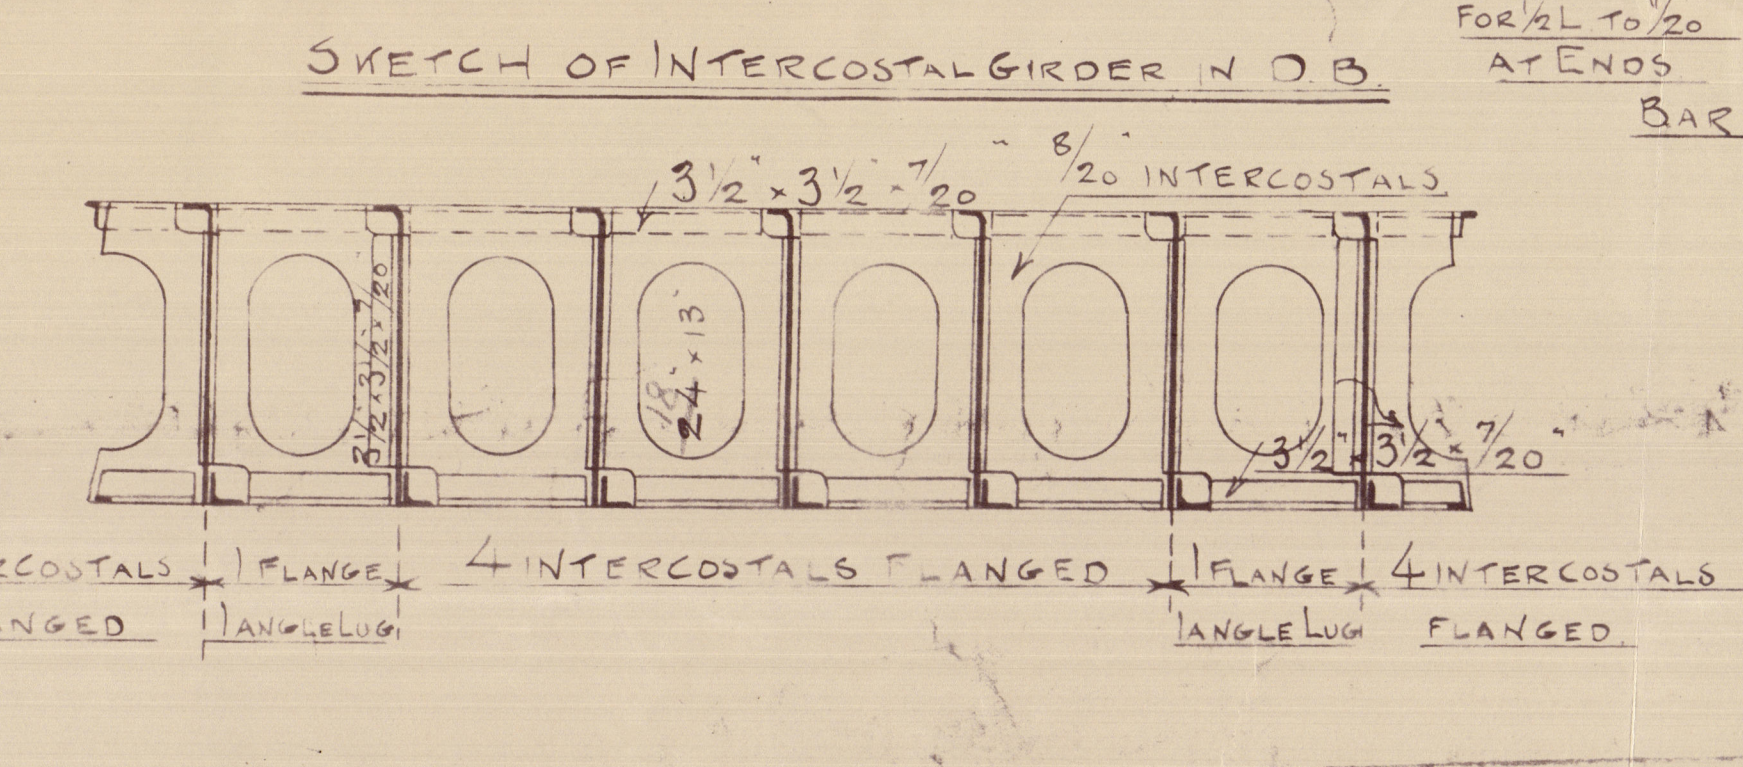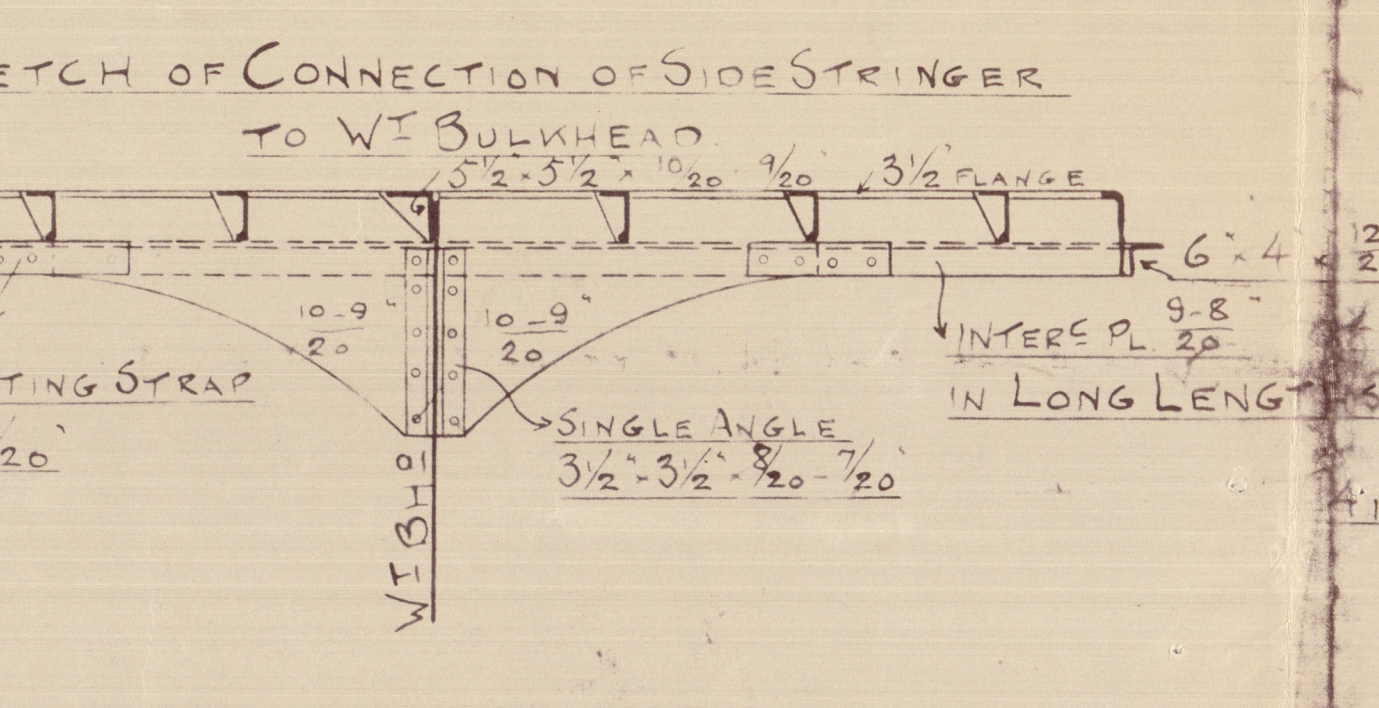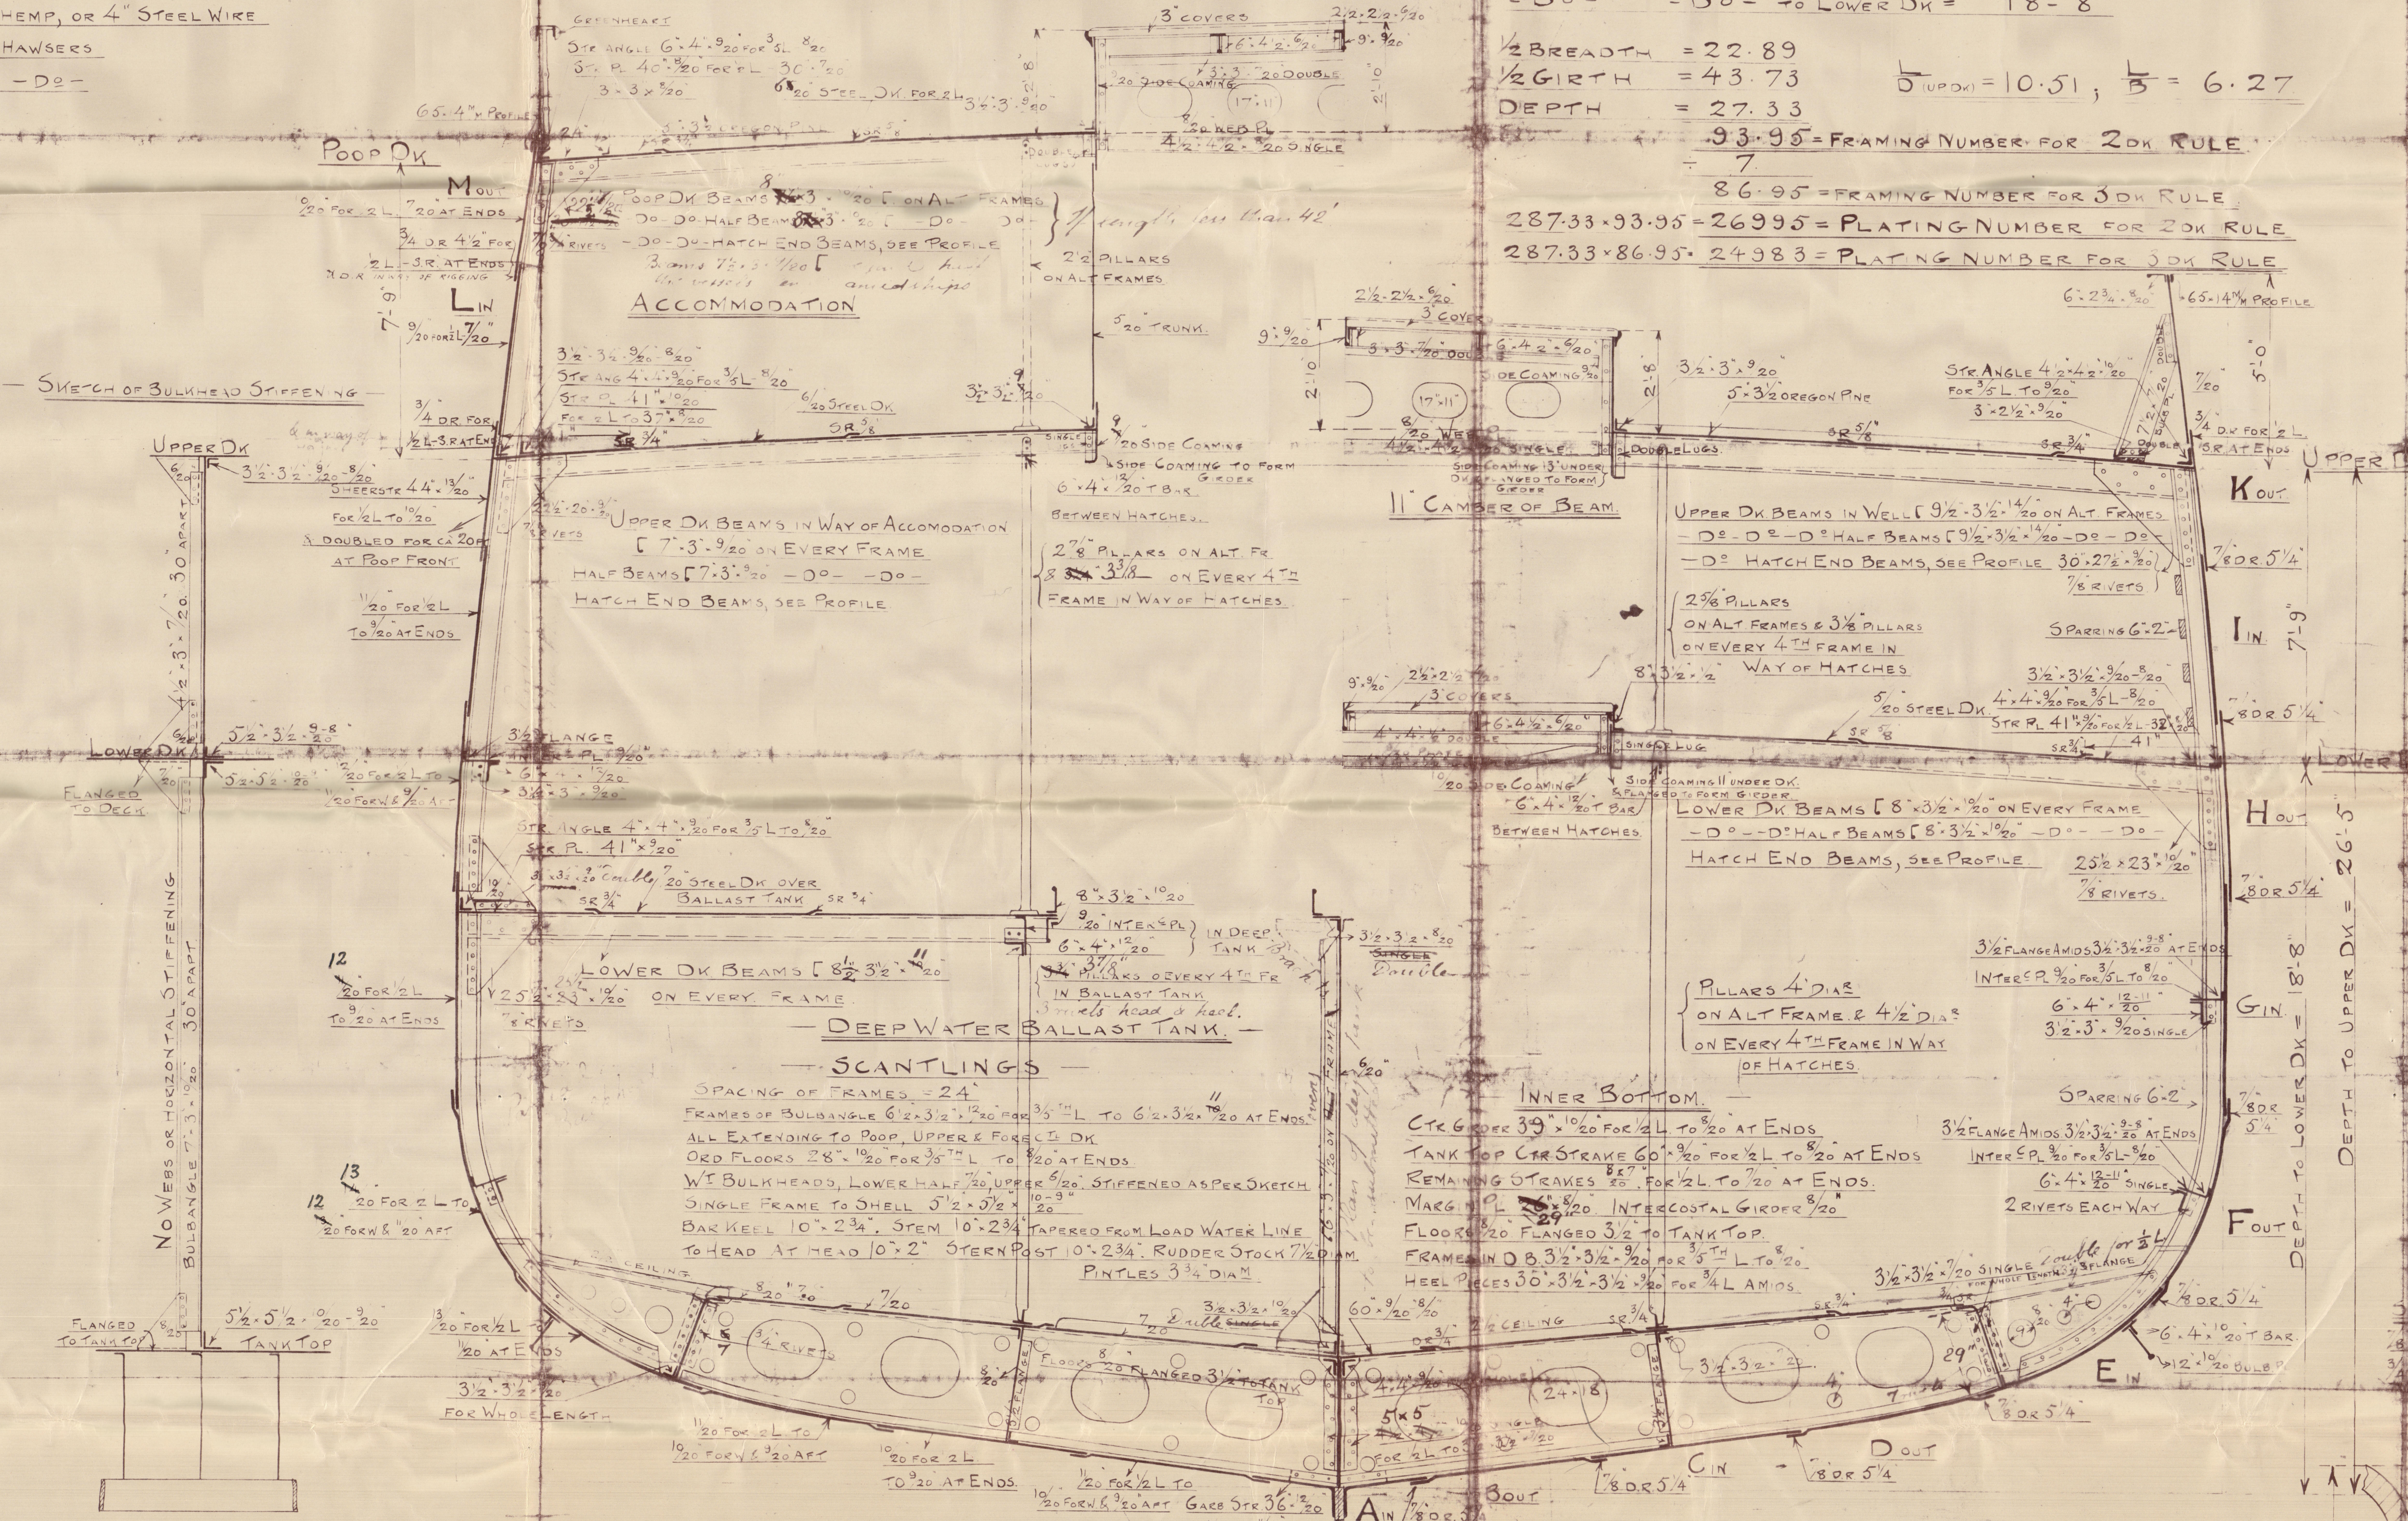

Adv. Cpn

Sh. 4 met BK "VIKING"
Midship Section

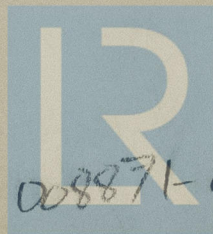

© 2020

Lloyd's Register
Foundation

008871-008878-0111