



PLAN VIEW

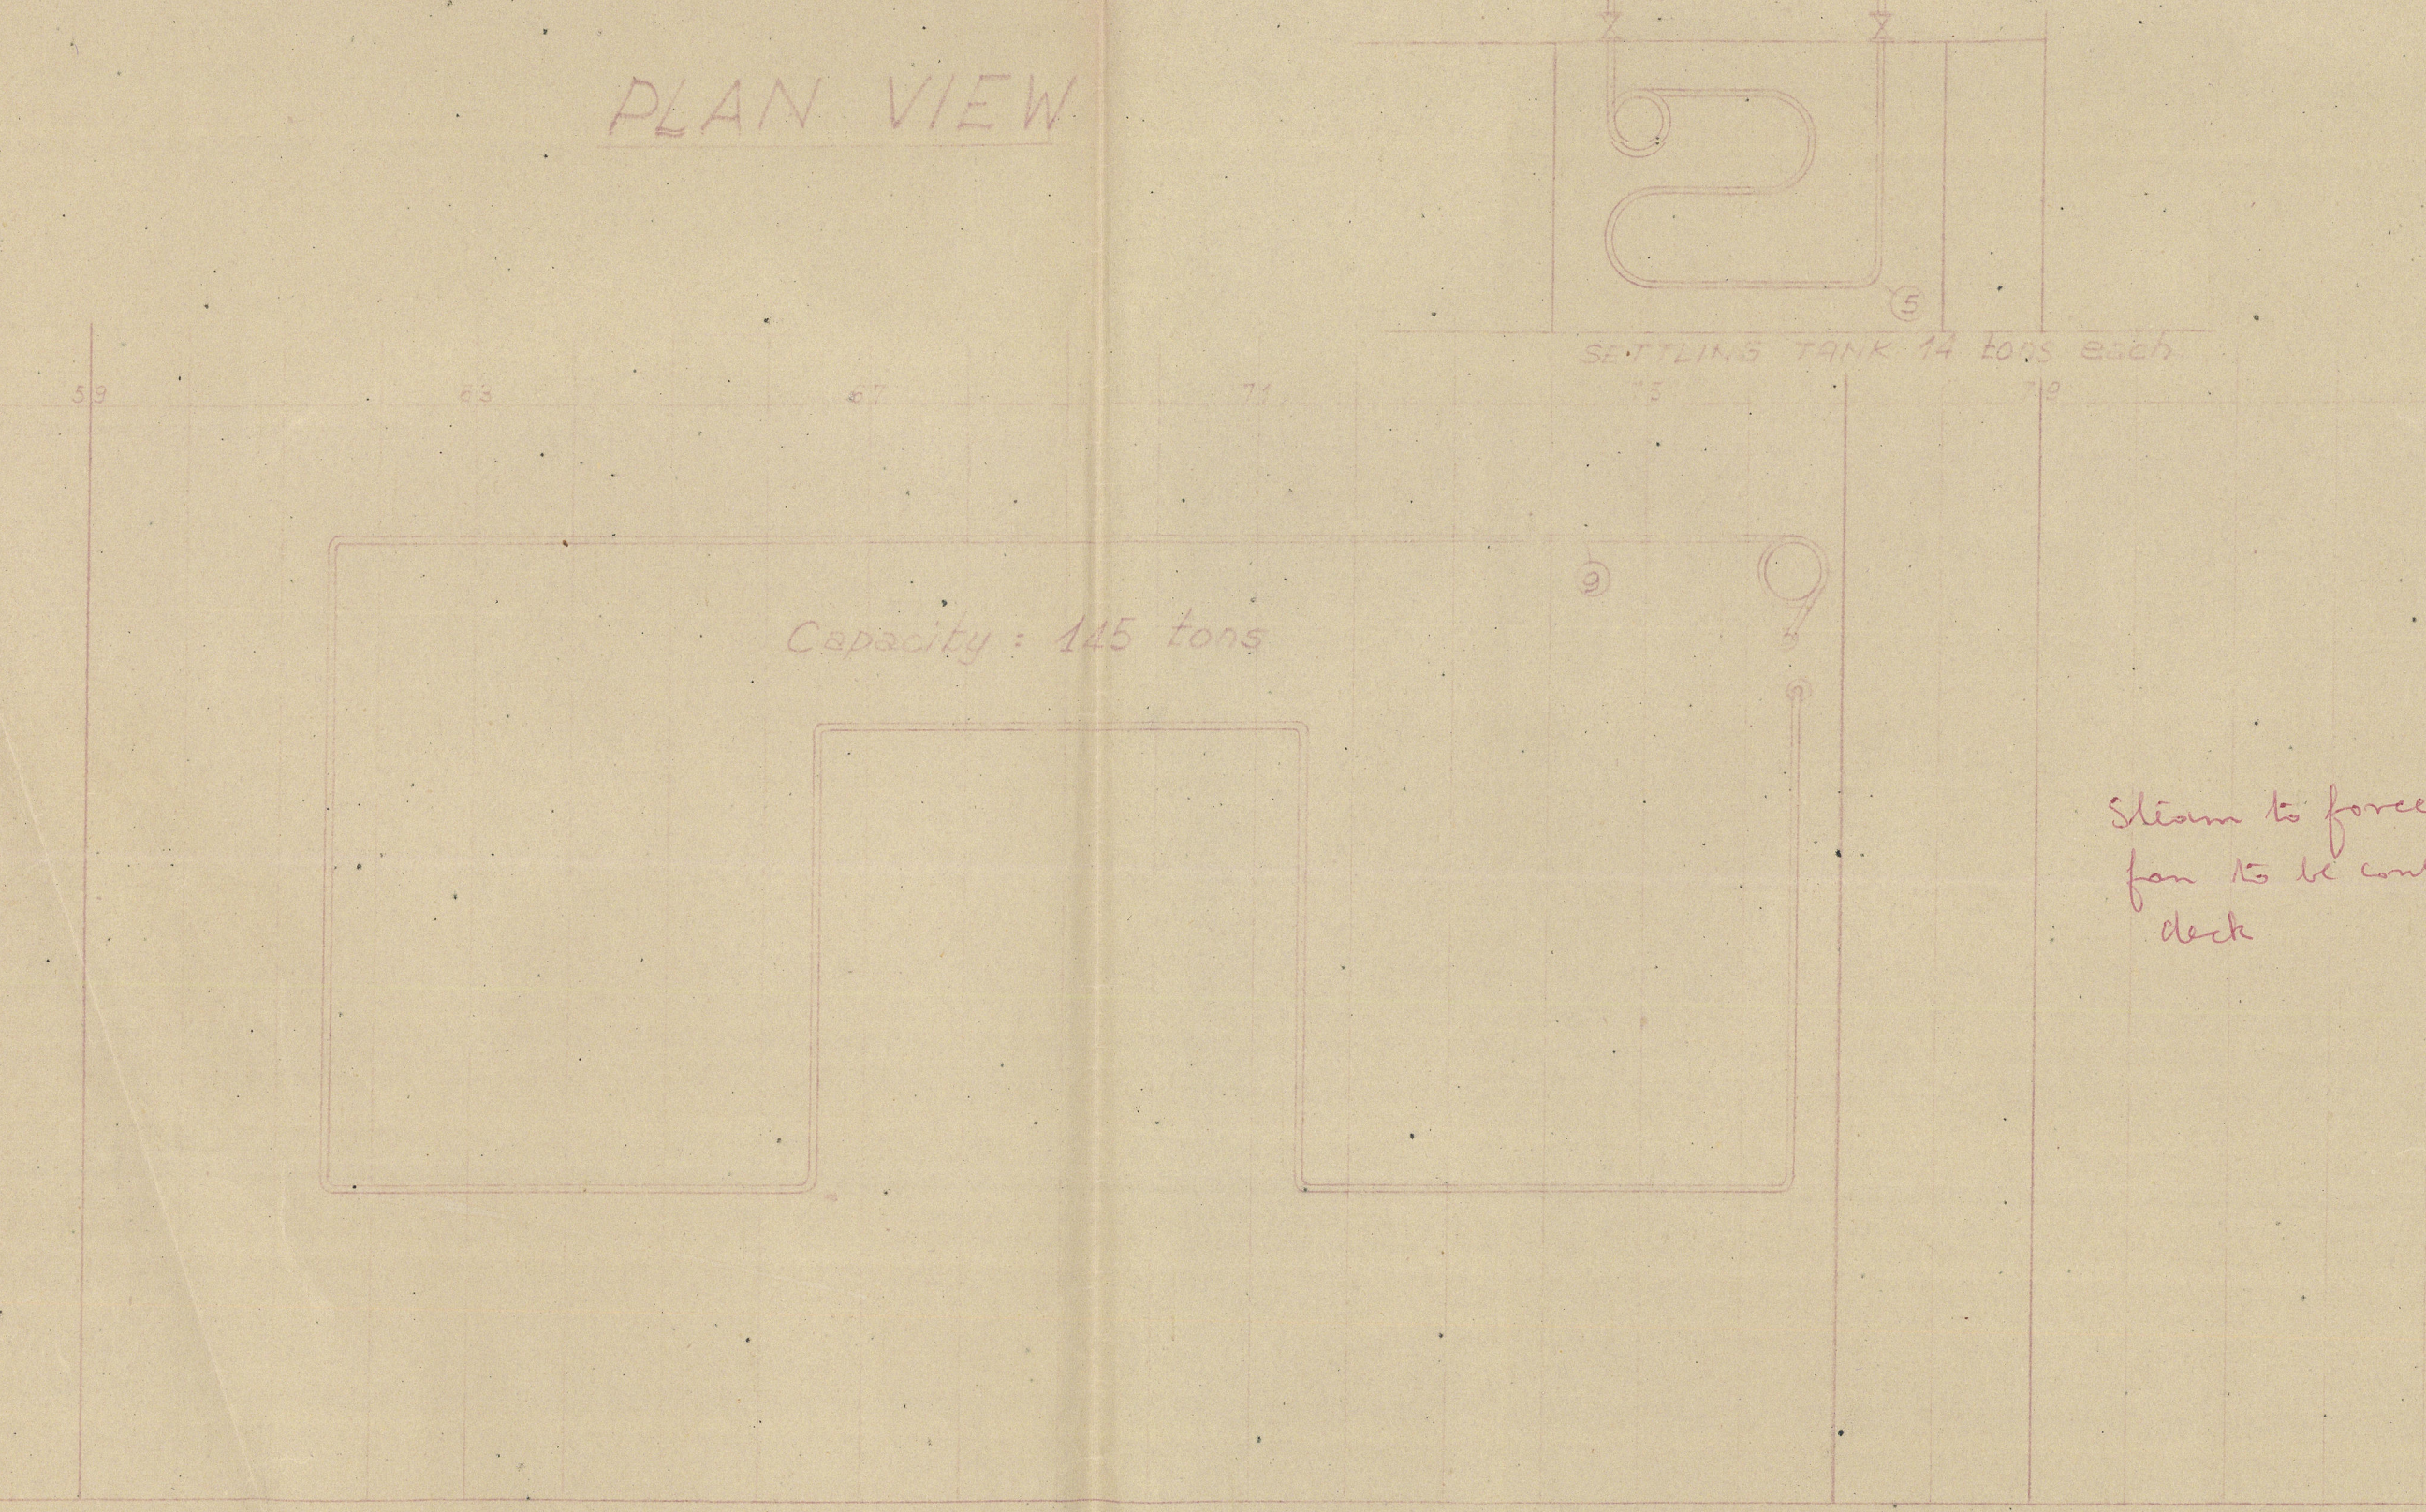

PLAN VIEW

SHOWING DOUBLE BOTTOM COILS

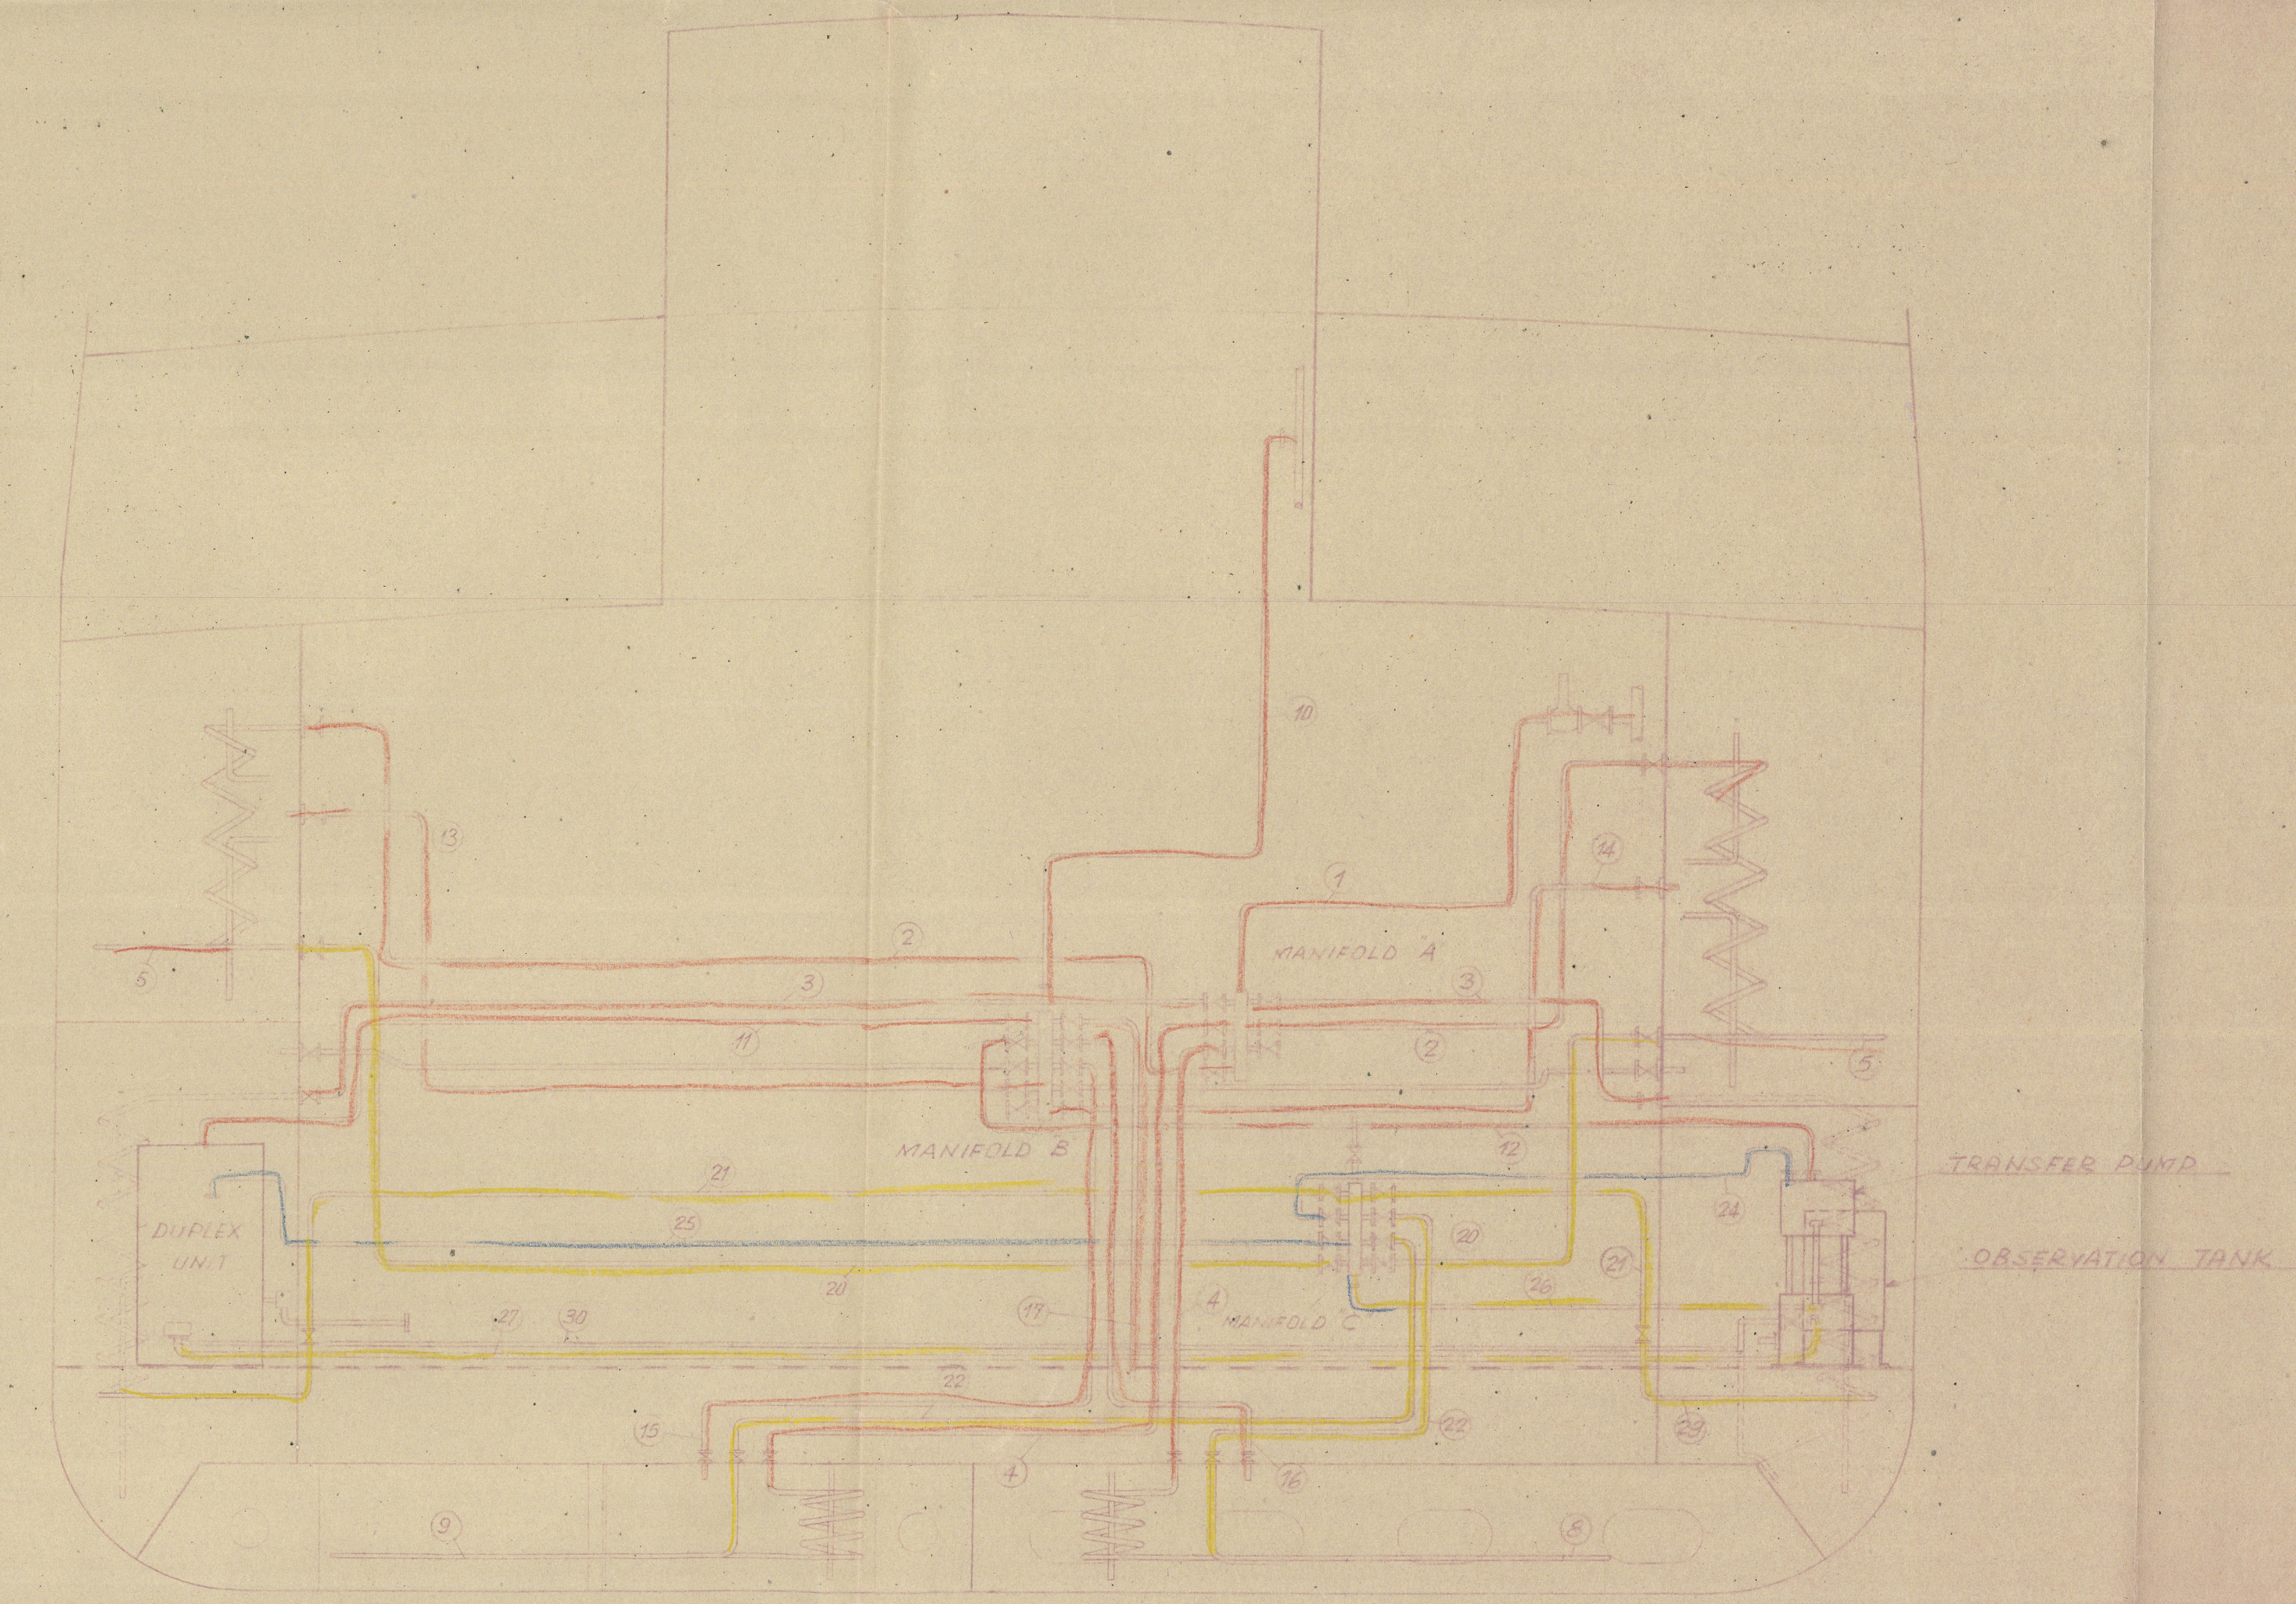

LOOKING AFT AT BULKHEAD
(SECTION AT FRAME 72)

Steaming out connections to tanks and sealing tanks to be fitted with S.O.M.R. valves and spectacle blocks

STEAM PIPES		
NO.	DESCRIPTION	SIZE INCHES
1	STEAM FROM STEAM LINE IN ENGINE ROOM TO MANIFOLD A	2" 14 5.5
2	MANIFOLD A TO HEATING COIL OF P.S. SETTLING TANKS	1 1/2 16 5
3	MANIFOLD A TO HEATING COIL OF P.S. SETTLING TANKS	1 1/2 16 5
4	HEATING COIL OF P.S. SETTLING TANKS 25 FEET LONG	1 1/2 16 5
5	HEATING COIL OF P.S. SETTLING TANK 25 FEET LONG	1 1/2 16 5
6	HEATING COIL OF P.S. SETTLING TANK 25 FEET LONG	1 1/2 16 5
VALVES		
NO.	DESCRIPTION	SIZE INCHES
1	STOP VALVE	2"
2	REDUCING VALVE	2"
3	STOP VALVE ON MANIFOLD A	1 1/2"
4	STOP VALVE ON MANIFOLD B	1 1/2"
5	STOP VALVE ON MANIFOLD C	1 1/2"

- GENERAL NOTES FOR CONVERSION
- Workmanship and all material to conform with rules and regulations of Lloyd Register of Shipping or Bureau Veritas.
 - Pipes seamless mild steel manufactured by the Siemens-Martin process to withstand 20 tons per sq. inch pressure, hydrostatic test.
 - Entire installation will conform with international convention on safety of life at sea 1980.
 - Pipe connection for one inch and larger will be with flanges. Flanges will be forged steel, slipped on pipes and welded.
 - Material of the valve body is to be cast or forged steel. The mountings (valve seat, lift spindle) to be bronze.
 - All valves to prove tight and withstand internal hydrostatic test pressure of 20 lbs. per sq. inch.
 - All valves one inch and larger are to have flanges for joining.

DESIGNED FOR
BY
1ST. 4734
S.S. HUSEYIN
CONVERSION FROM COAL TO
OIL BURNING

STEAM PIPING
ARRANGEMENT
DESIGNED & DRAWN BY T. I. GIRAY
DATE 25 JULY 1957
SCALE 1/4"=1'-0"
FOR OWNER Capt. J. Giray

The remaining requirements of the Rules for Fire Extinguishing Arrangements to be complied with so far as they are applicable.

The remaining requirements of the Rules for Pumping and Piping to be complied with so far as they are applicable.