



L.C. IO & L.C. II.

PROFILE & DECK PLANS.

SCALE: 1/8" = ONE FOOT.

J 4220 & 4224.

DIMENSIONS ~ 180'-0" OVERALL * 39'-0" BEAM * 17'-6" DEPTH.
LLOYD'S NUMERALS ~ L * D = 3150.
L * (B + D) = 10170.
BUILT TO LLOYD'S SURVEY - CLASS 100A. "SALVAGE LIGHTER."

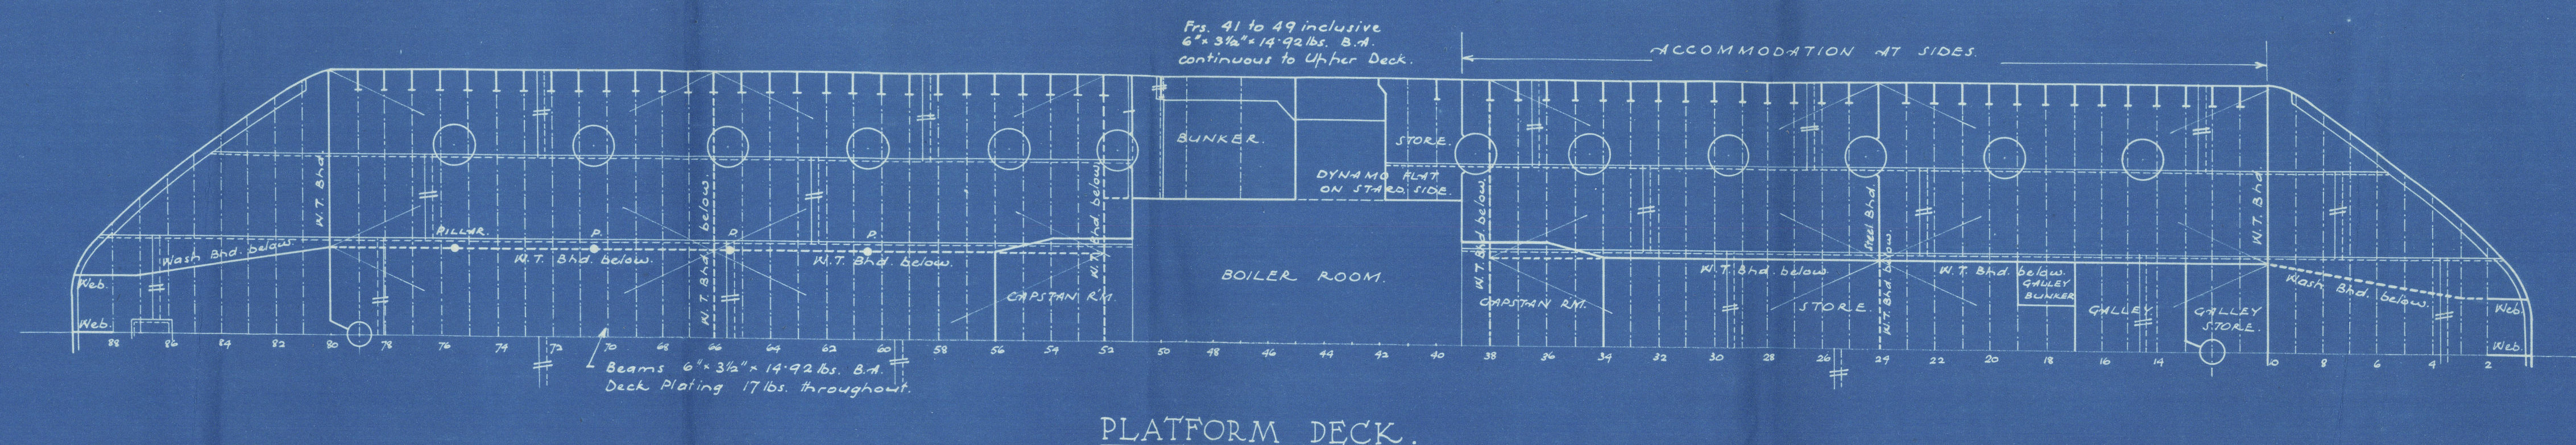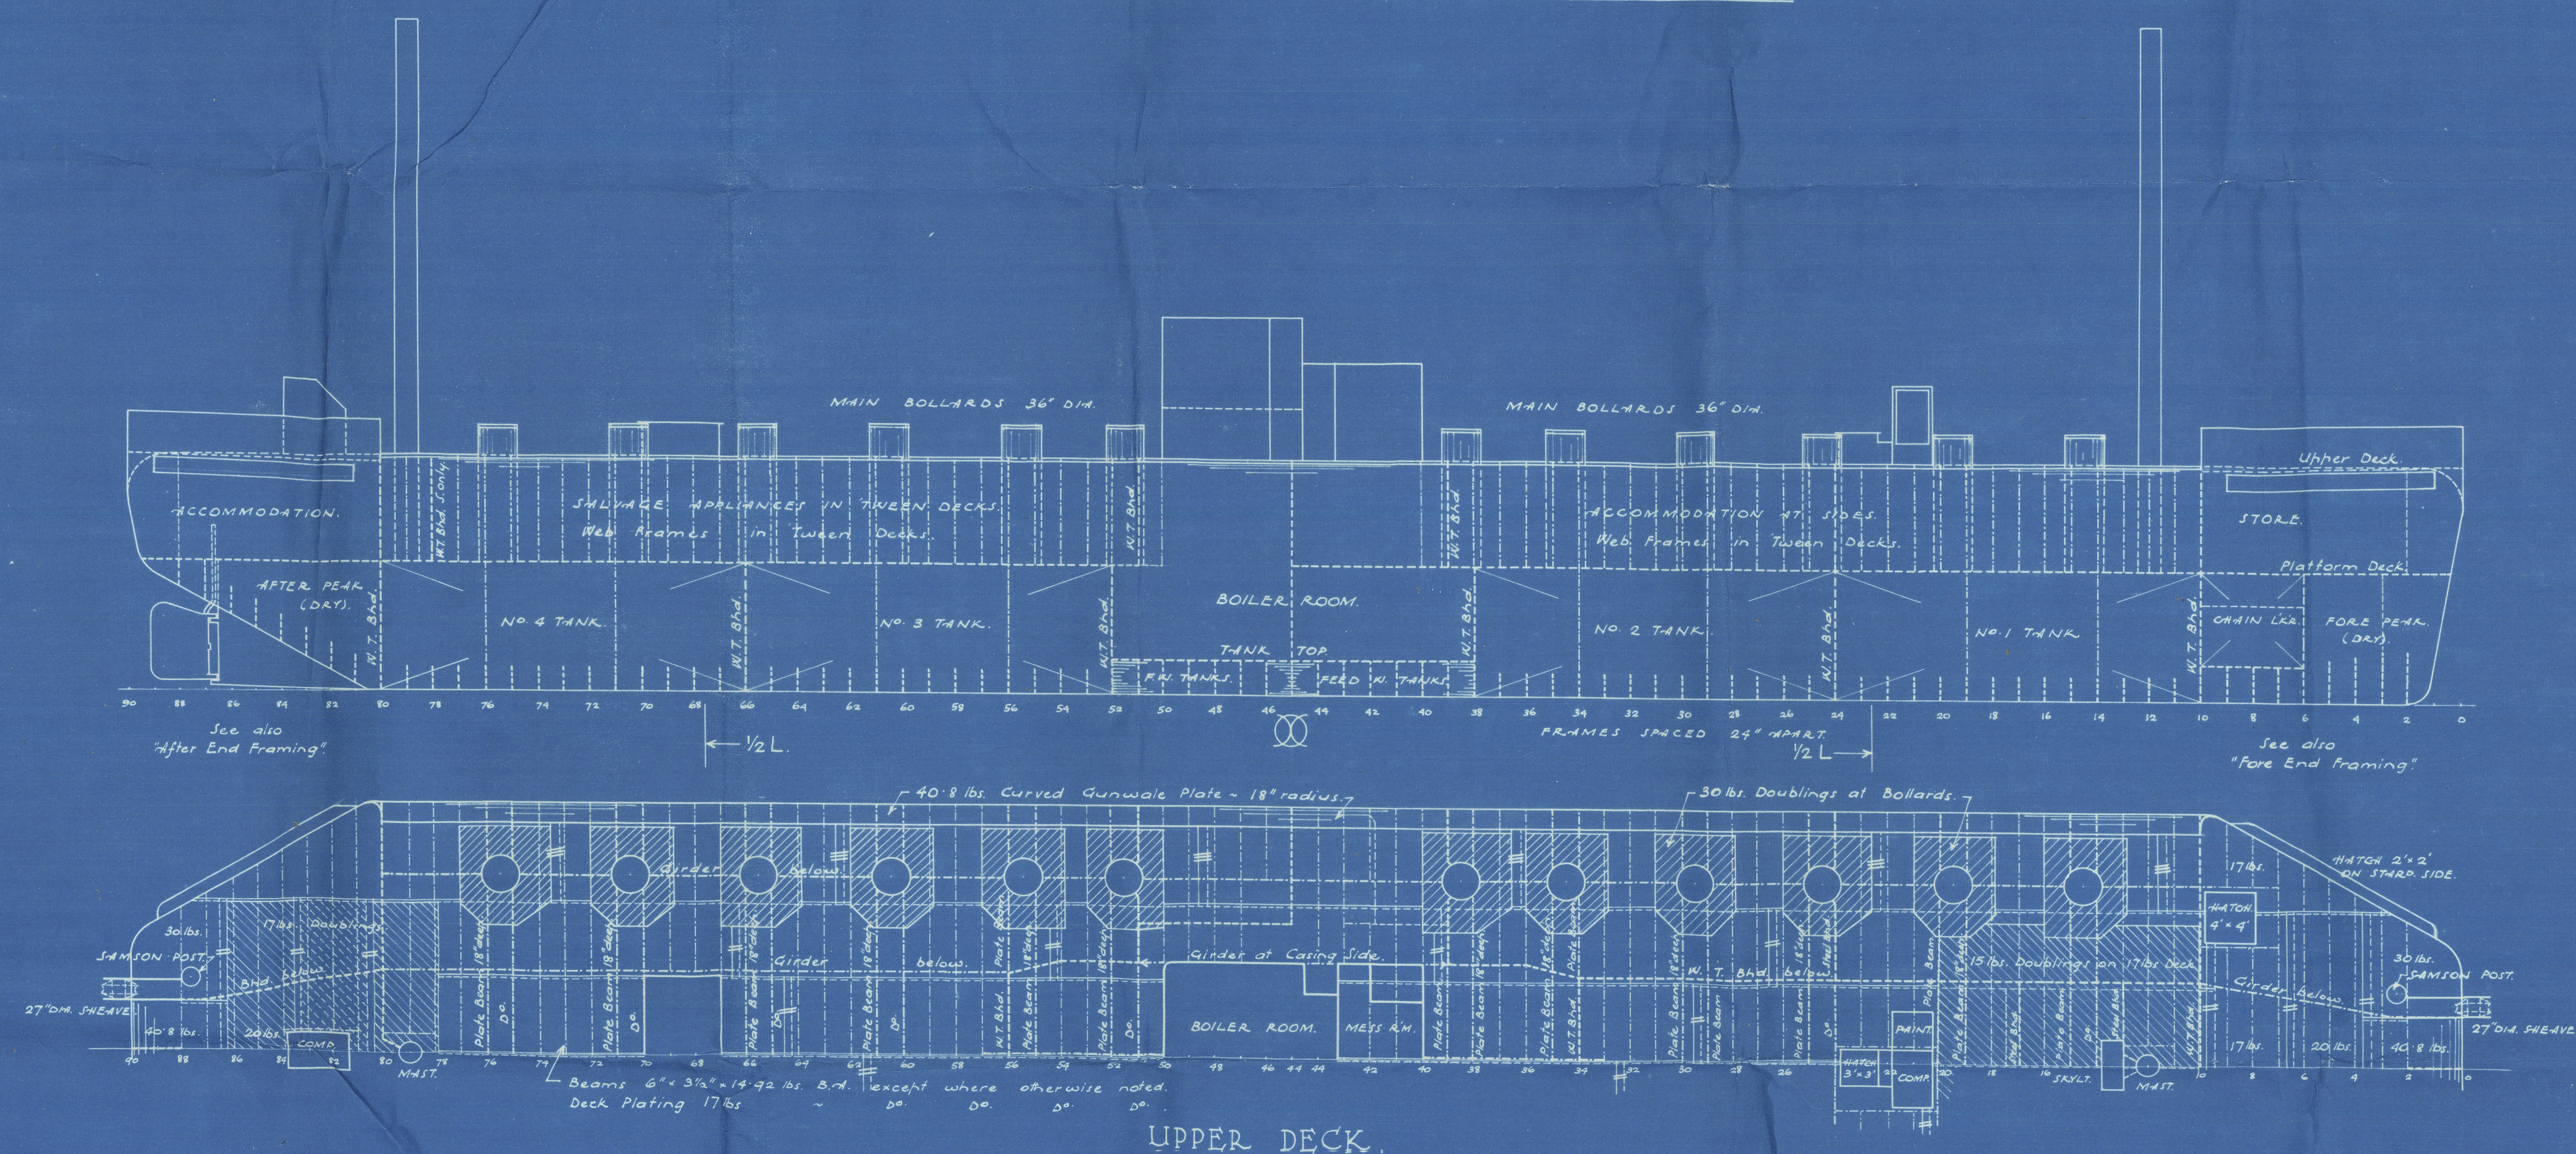


Funness S. B. Co. Sta.

Yard Nos. 336 / 7

★
"L.C. 10" & "L.C. 11"

Profile & deck plan as built.

RECORDS DEPT.
LONDON

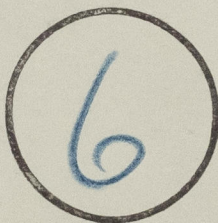

© 2020

008879-008887-0136

Lloyd's Register
Foundation