

PRINCIPAL DIMENSIONS

LENGTH OVER ALL	62.- M.
LENGTH B.P.P.	56.- M.
BREADTH MOULDED	9.30 M.
DEPTH	4.05 M.
DRAUGHT	± 3.51 M.


CLASS LLOYD'S 100 A 1

EQUIPMENT


3 STOCKLESS BOWERS EACH 810 KG.
 385 M. STUD CHAIN CABLE 3 1/2" DIAM.
 165 M. TOWLINE 76" CIRCUMF. (6x12)
 110 M. STREAM WIRE 70" CIRCUMF.
 2x165 M. HAWSERS & WARPS 45" CIRCUMF. (6x12)

HATCH END BEAMS FRAME NO 46-54-80

SECTION A-B

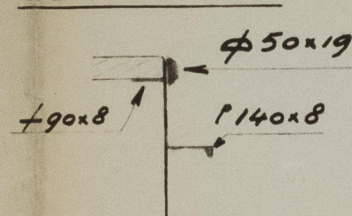


FOR SLIDING BEAMS
 SEE APART PLAN

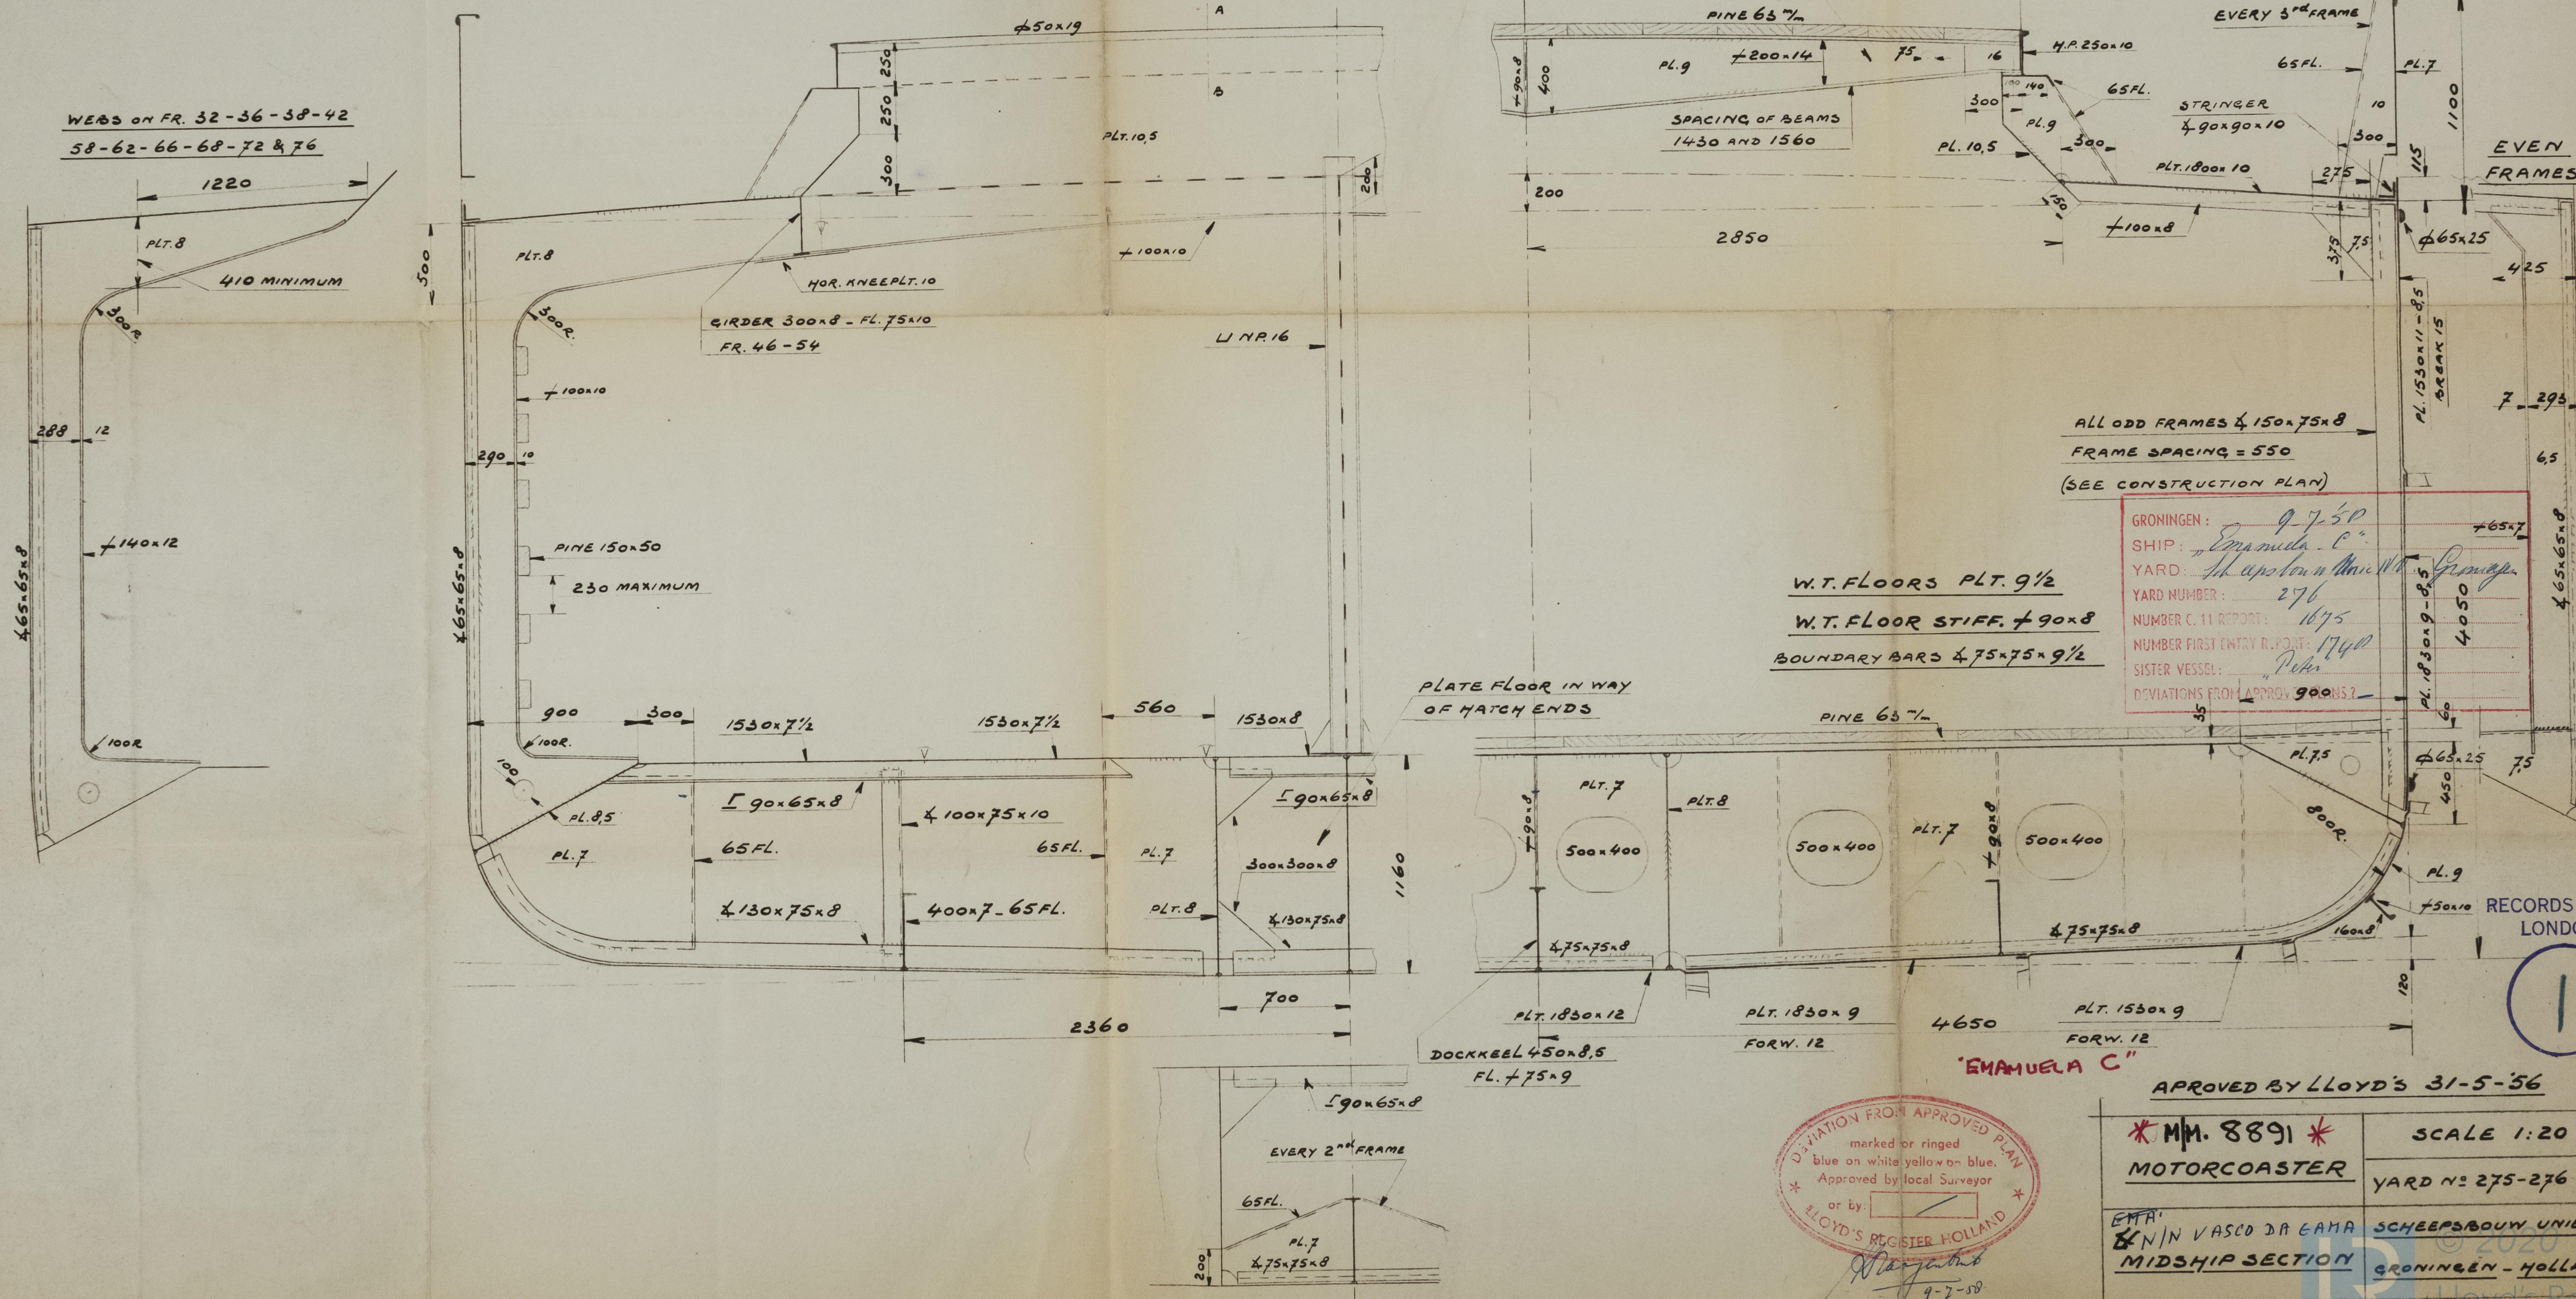

RECORDS DEPT.
 LONDON.

1

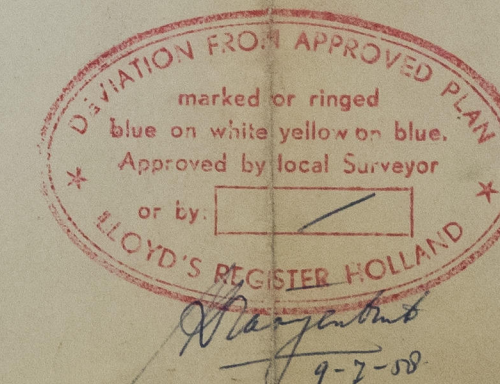

MM. 8891	SCALE 1:20
MOTORCOASTER	YARD N: 275-276
EMANUEL C	SCHIEPBOUW UNIE N.V.
MIDSHIP SECTION	GRONINGEN - HOLLAND

D/S 665
 008888-008894-0076