

11.11.36


No. 243.

PROFILE - DECK PLAN.

Scale 1/4" = 1 Foot.

To Class Lloyd's N.I. for "Service in Gulf of Guinea"

Overall Dimensions: 136'0" x 24'0" x 9'6" 1/2"

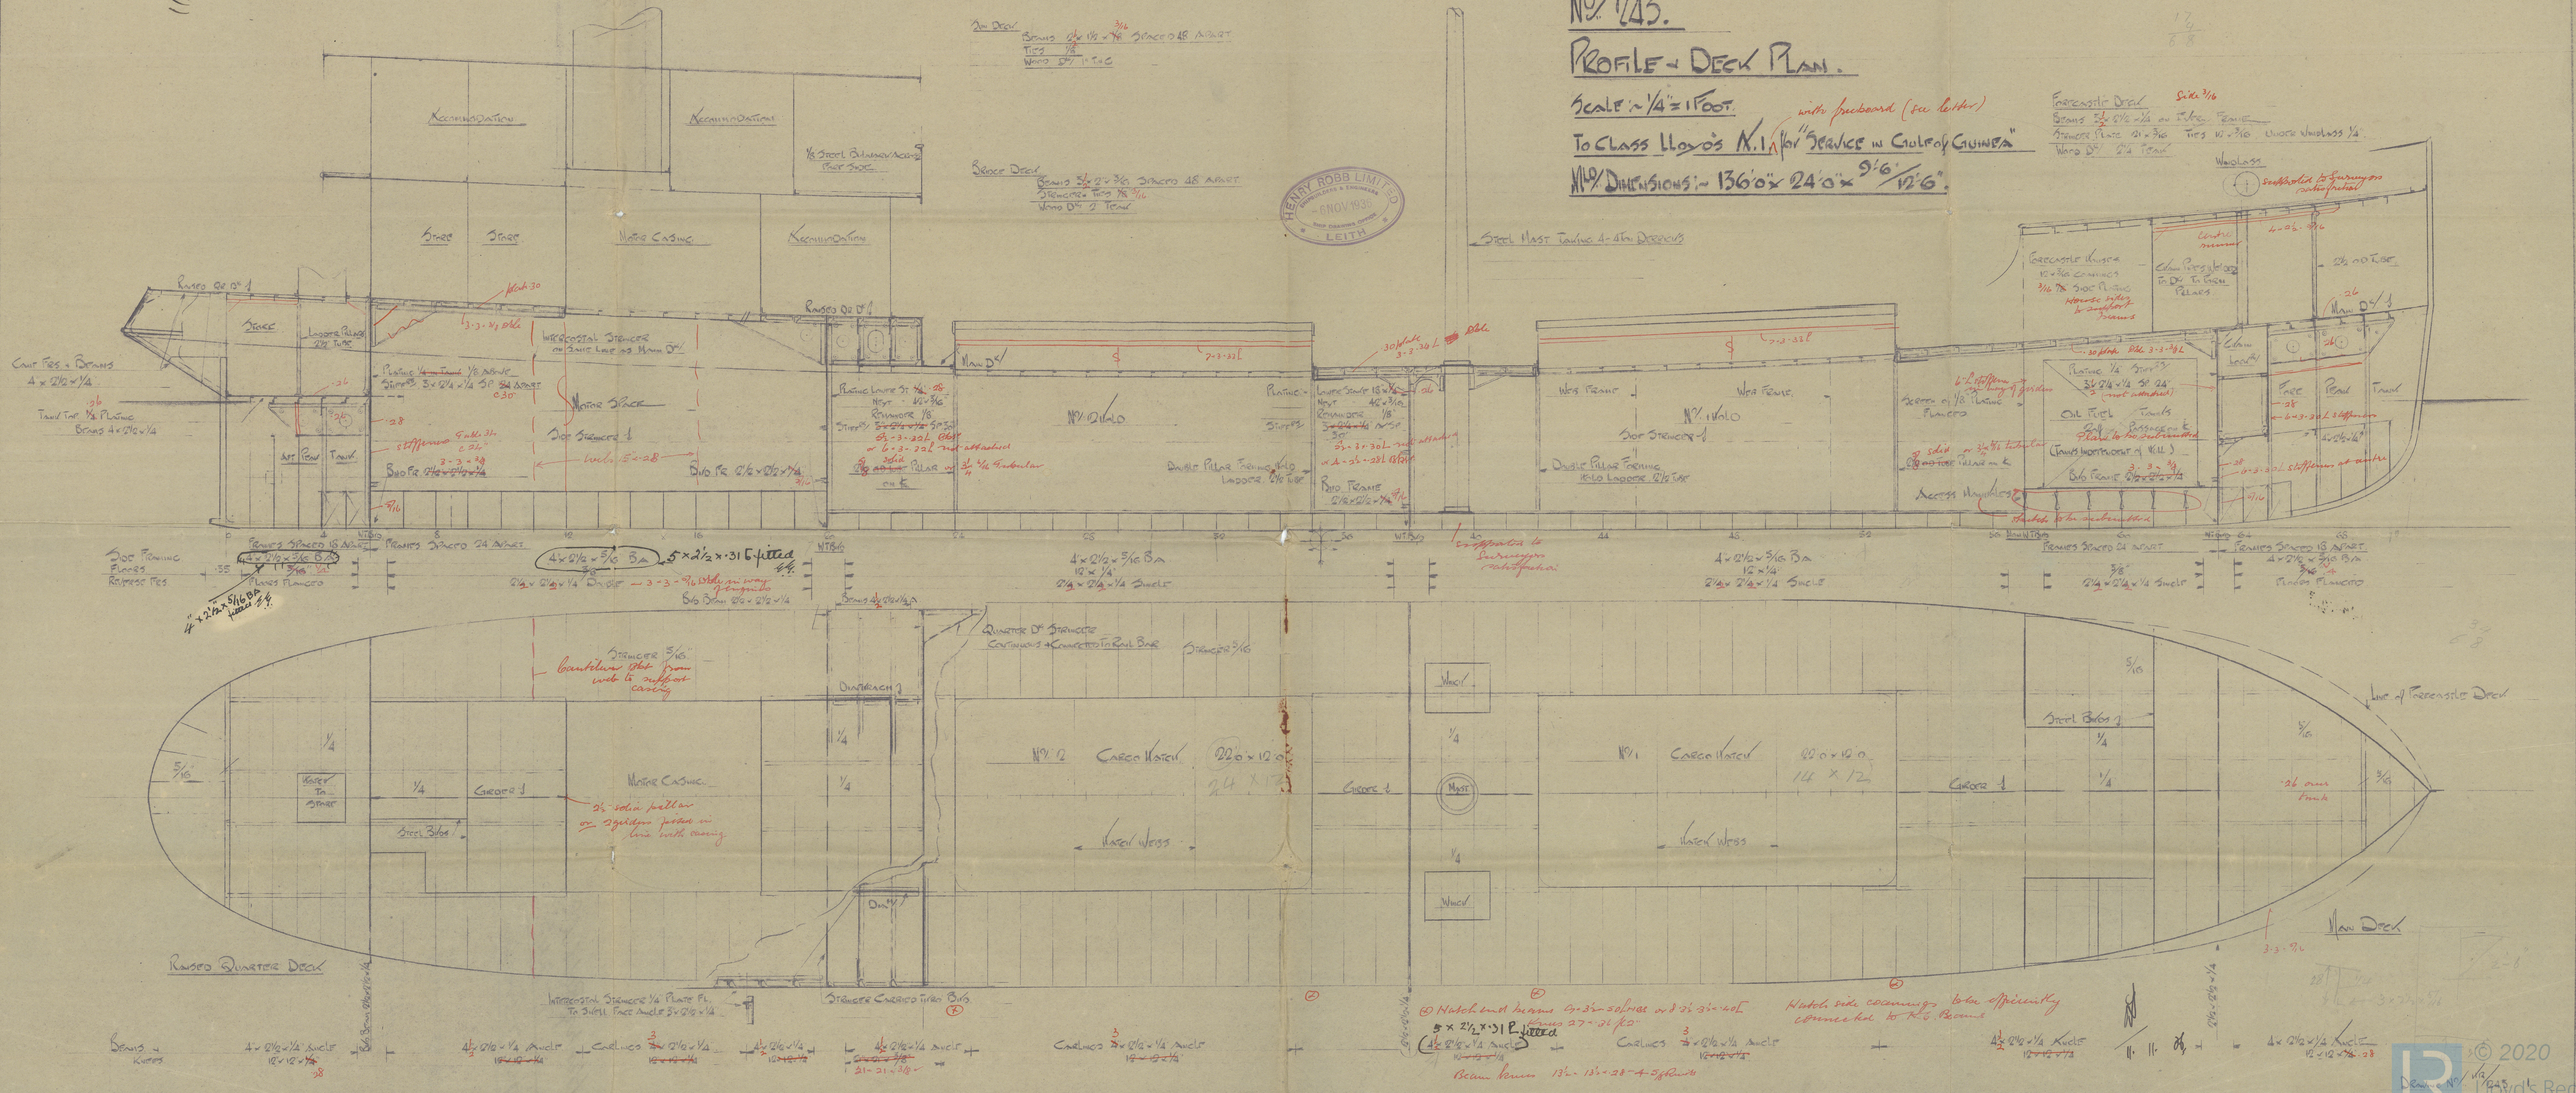

Henry Robt L^d
N^o 243

Profile & Decls

Publ. Rpt. No. 19419

m. v. "Joseph Flint"



© 2020

Lloyd's Register
Foundation

008900-008908-0002