


# S.T. "AVOLA"

## SHIPS DISTRIBUTION BOARD.

SCALE 1 1/2" = 1 FOOT.

*Instrument scales to comply with section 3 clause 14.*

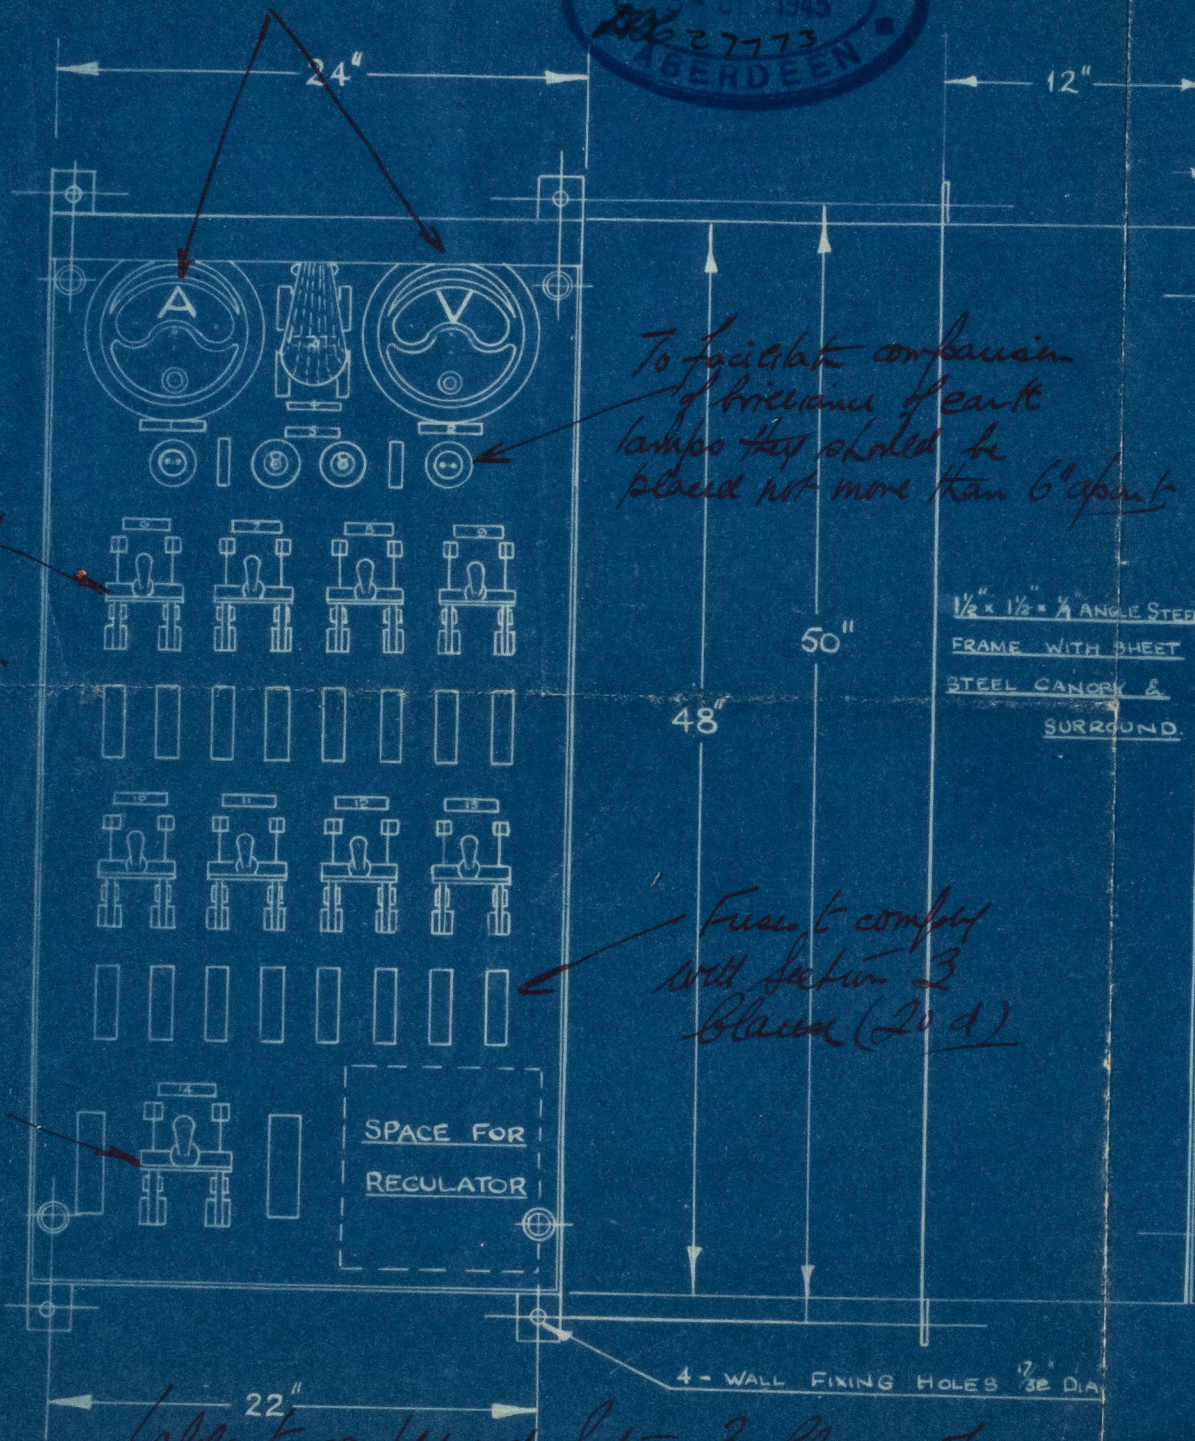


*Switches to comply with section 3 clause 19c.*

*60 Amp Pilot Fuses*

*Labels to comply with section 3 clause 7*

### LABELS

1 GENERATOR AMPERES	2 GENERATOR VOLTS.	3 PILOT LAMP FUSES 38 SWG COPPER	4 VOLTMETER FUSES 35 SWG COPPER	5 EARTH LAMPS- FUSE 38 SWG COPPER	6 CABLE 24 AMPS NAVIGATION FUSES 22 SWG COPPER	7 CABLE 24 AMPS ENGINE ROOM FUSES 22 SWG COPPER
8 CABLE 24 AMPS MIDDLES & FLOOD LIGHTS FUSES 22 SWG COPPER	9 CABLE 15 AMPS FORWARD FUSES 25 SWG COPPER	10 CABLE 24 AMPS W/T & CHARGING FUSES 22 SWG COPPER	11 CABLE 15A SPARE AFT LIGHT FUSES 25 SWG	12 SPARE	13 SPARE	14 CABLE 5A AMPS GENERATOR FUSES 18 SWG COPPER

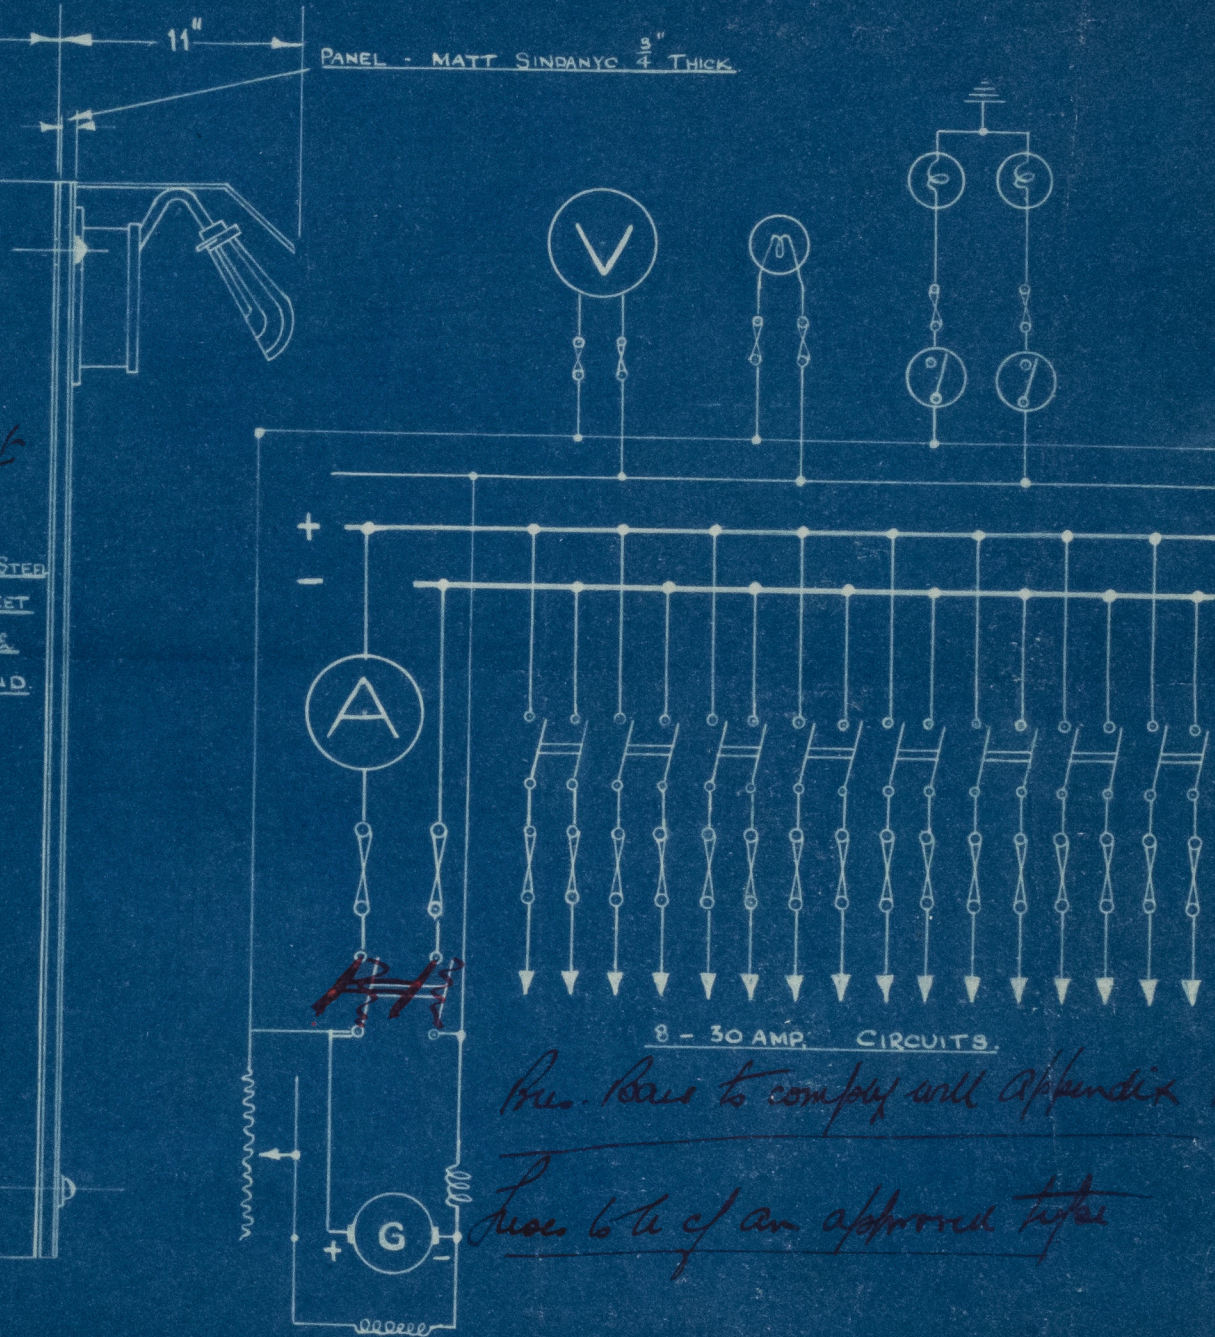

*Pre. Board to comply with Appendix 1*

*Fuses to be of an approved type*

APPROVED

LLOYD'S REGISTER OF SHIPPING

*S.D. Olkilston*



18/12/45

*Noted 2/1/46*

LONDON



"Avola."

Main switchboard.

Abn rept No. 21838.



© 2020

Lloyd's Register  
Foundation

008900-008908-0094