

N^o 427. - 429.

STREAMLINED STERNFRAME

SCALE 1" = 1 FOOT.

DETAILS:- SCALE AS INDICATED

MATERIAL:- BEST QUALITY STEEL CASTING.

DIMENSIONS:-

425'-0" ON L.W.L., 28'-2" MLD TO LOWER D^s, 36'-2" MLD TO UPPER D^s



TO CLASS 100A1 WITH FREEBOARD CORRESPONDING TO THAT OF A COMPLETE SUPERSTRUCTURE VESSEL WITH TONNAGE OPENING.

FIRST LONG^s NUMBER L+D 15372

RULE STERNFRAME 10' 4" x 8'

STERNFRAME DESIGNED TO SUIT DOUBLE PLATE STREAMLINE RUDDER

DIAM OF RUDDER STOCK 11"

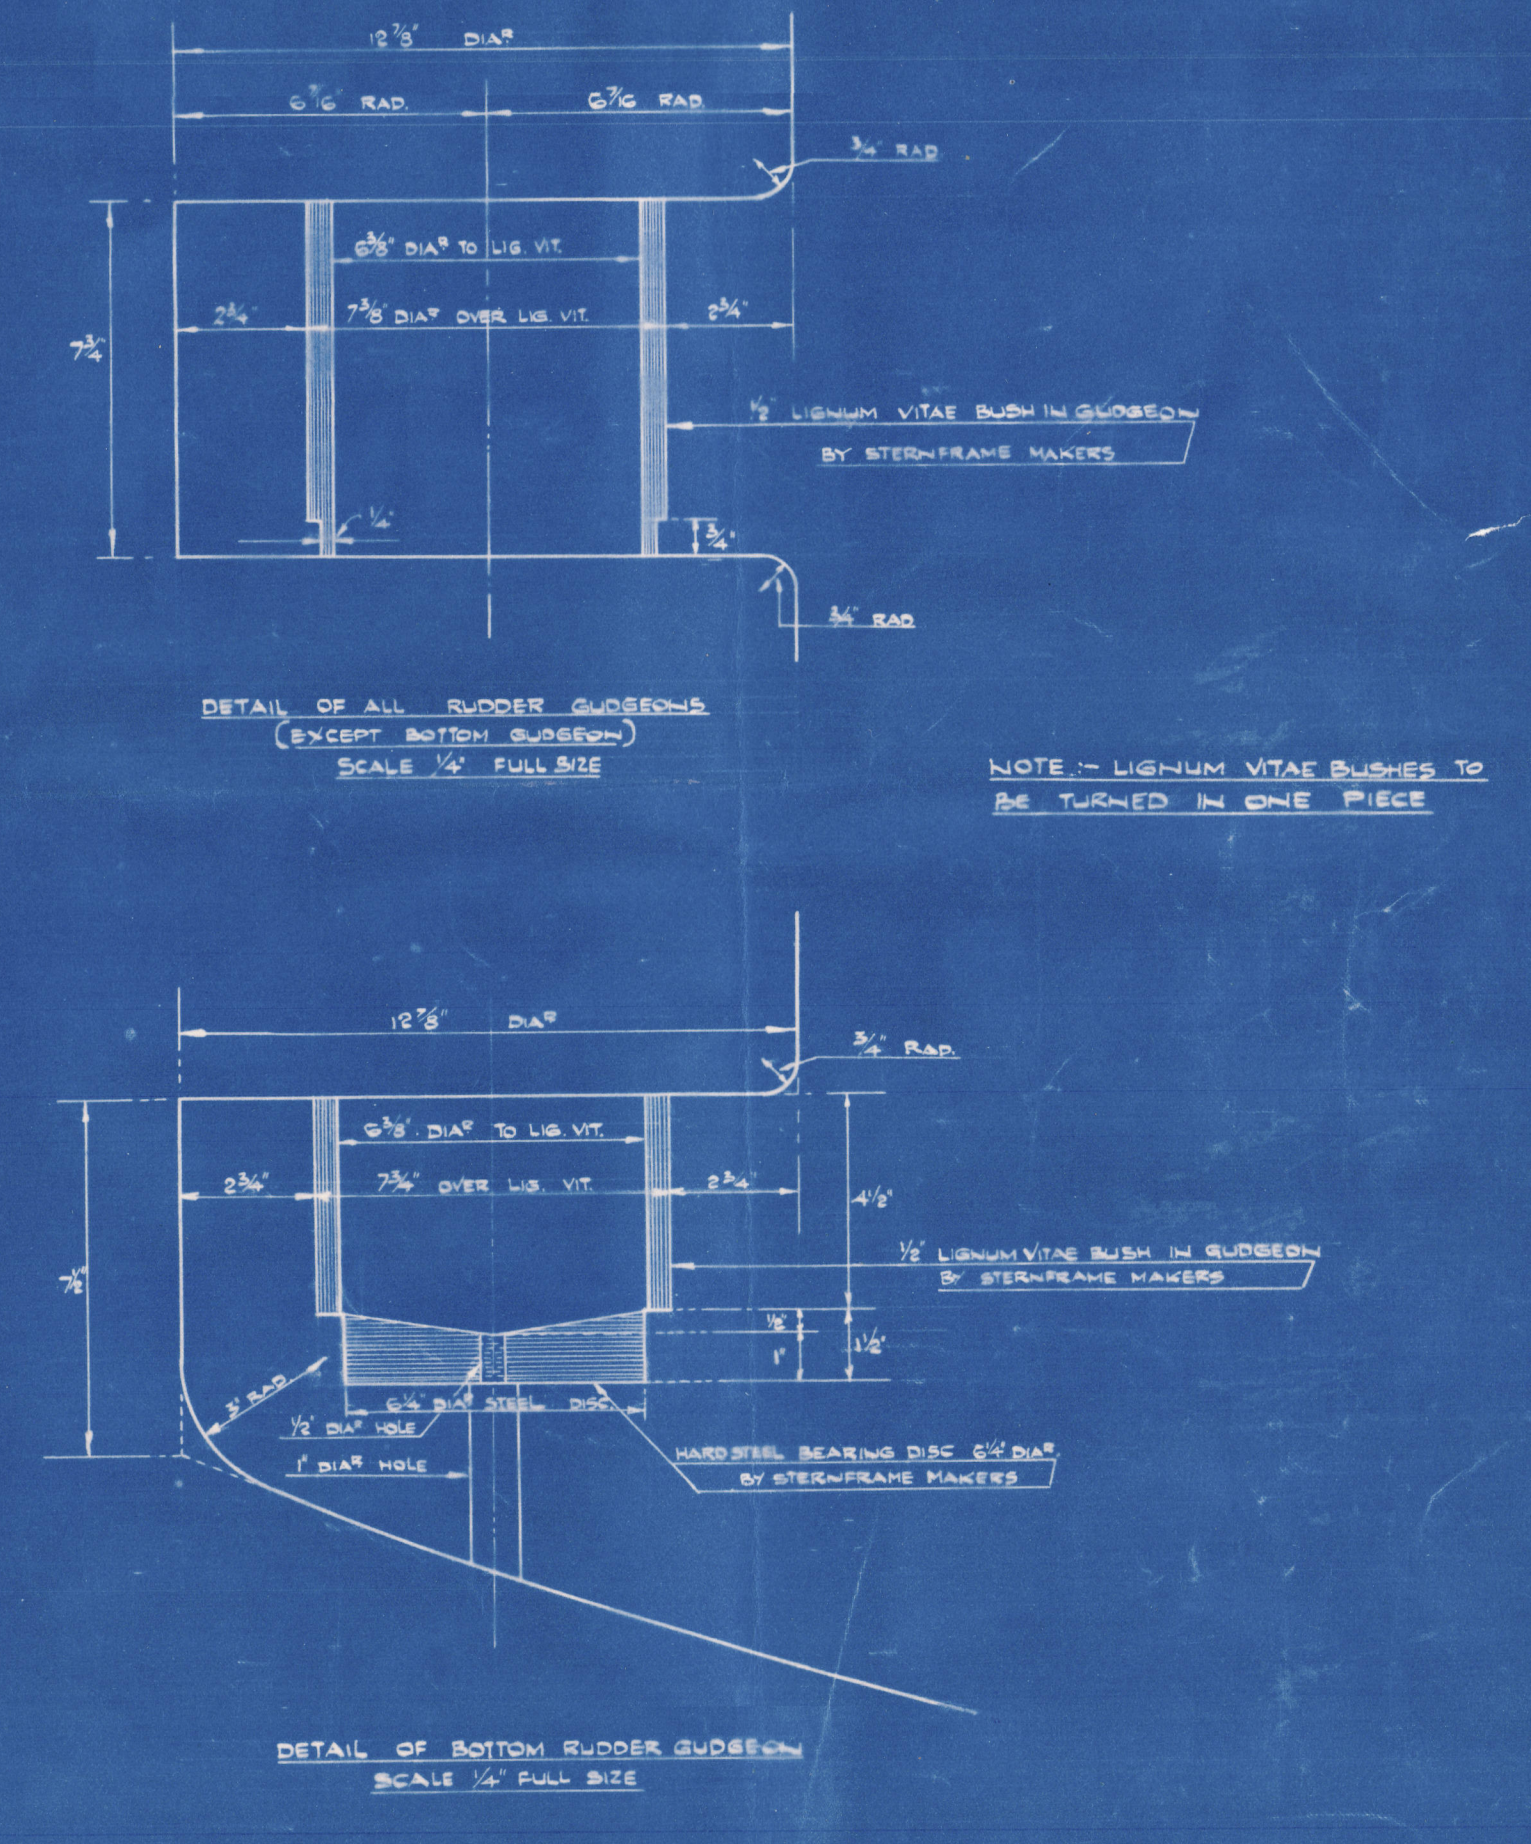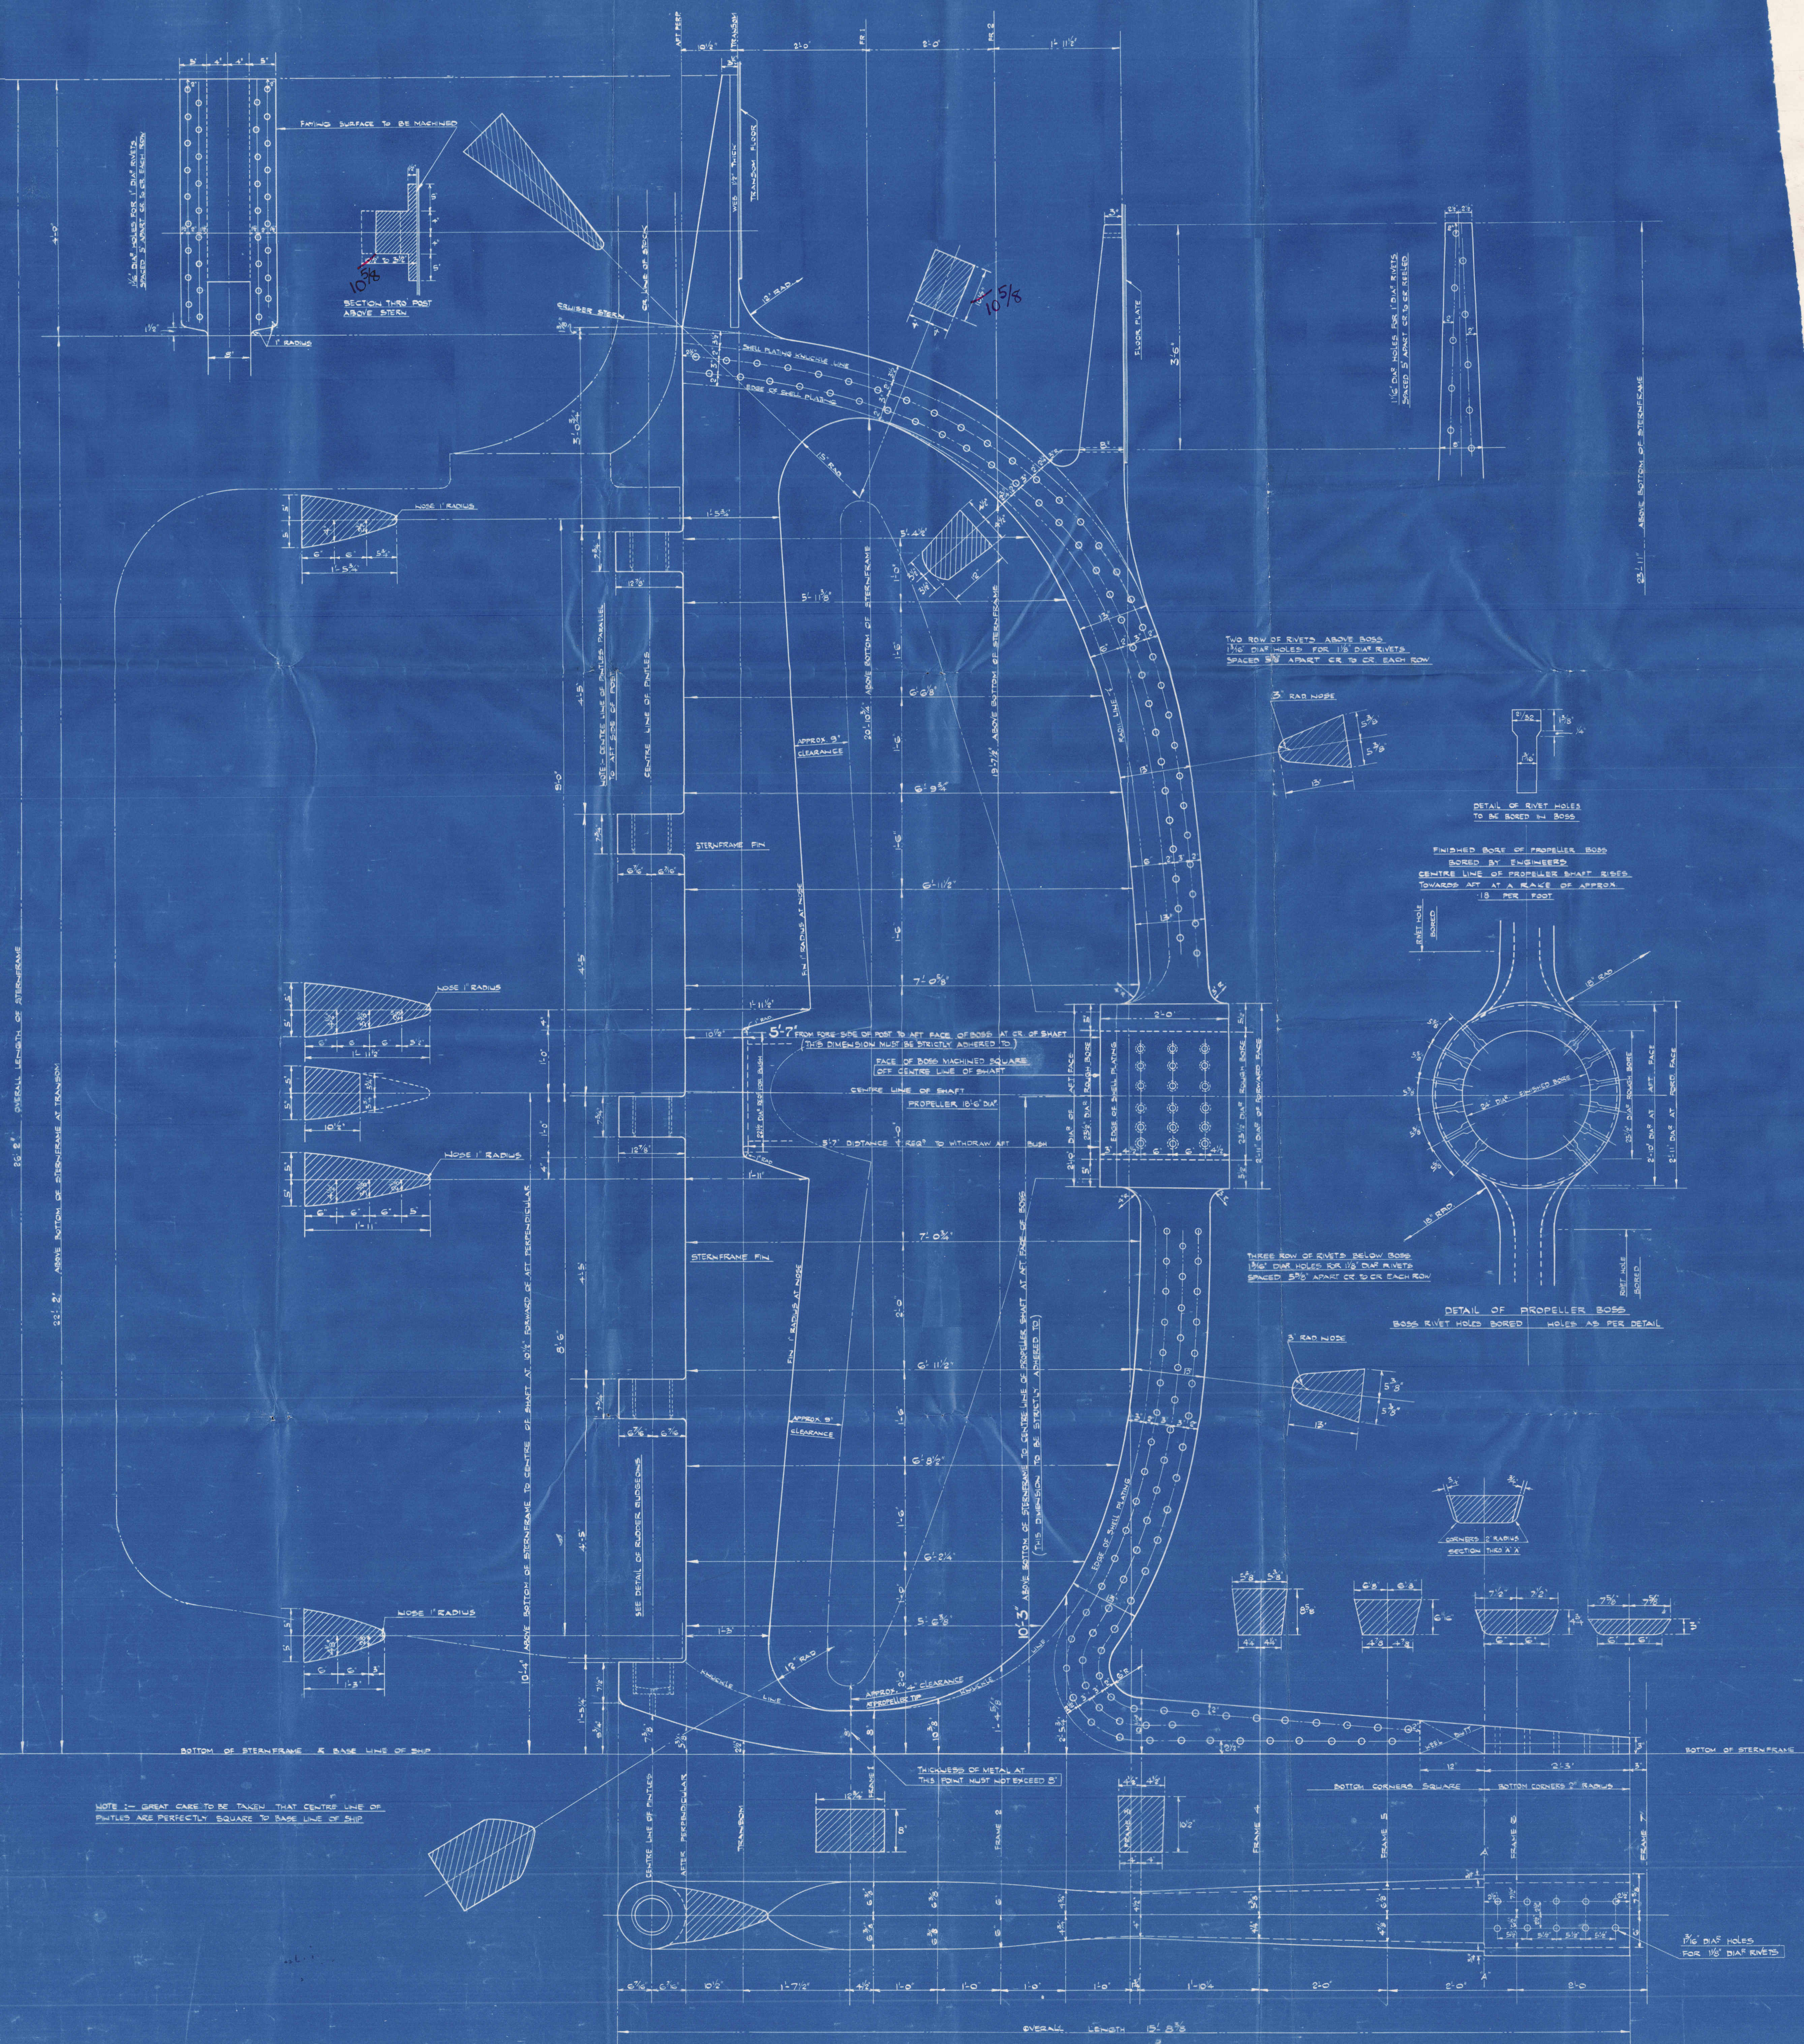

APPROVED
LLOYD'S REGISTER OF SHIPPING
Hickman
DATE 25.1.36

APPROVED *for R 429*
LLOYD'S REGISTER OF SHIPPING
Hickman
DATE 21/1/36



3.

W^m Hamilton & C. L.

Sh. 427. & 429.

Steam lines Steamships

Sh. 427. DARLENY ^W ^{Hoyo} *
7ARU

Gen. 1st E. Rep. N^o 20311.

Sh. 429. NEREUS

Gen. 1st E. Rep. N^o 20439.

^W ^{Hoyo} MARU *
7ARU



© 2021

Lloyd's Register
Foundation

008917-008924-0155