

9 APR 1954


## Lloyd's Register of Shipping.

Ship's Name

M/V. "HAVJARL"

Official No. - -

Memorandum of alterations reported since ship was surveyed for assignment of Load Lines  
in \_\_\_\_\_

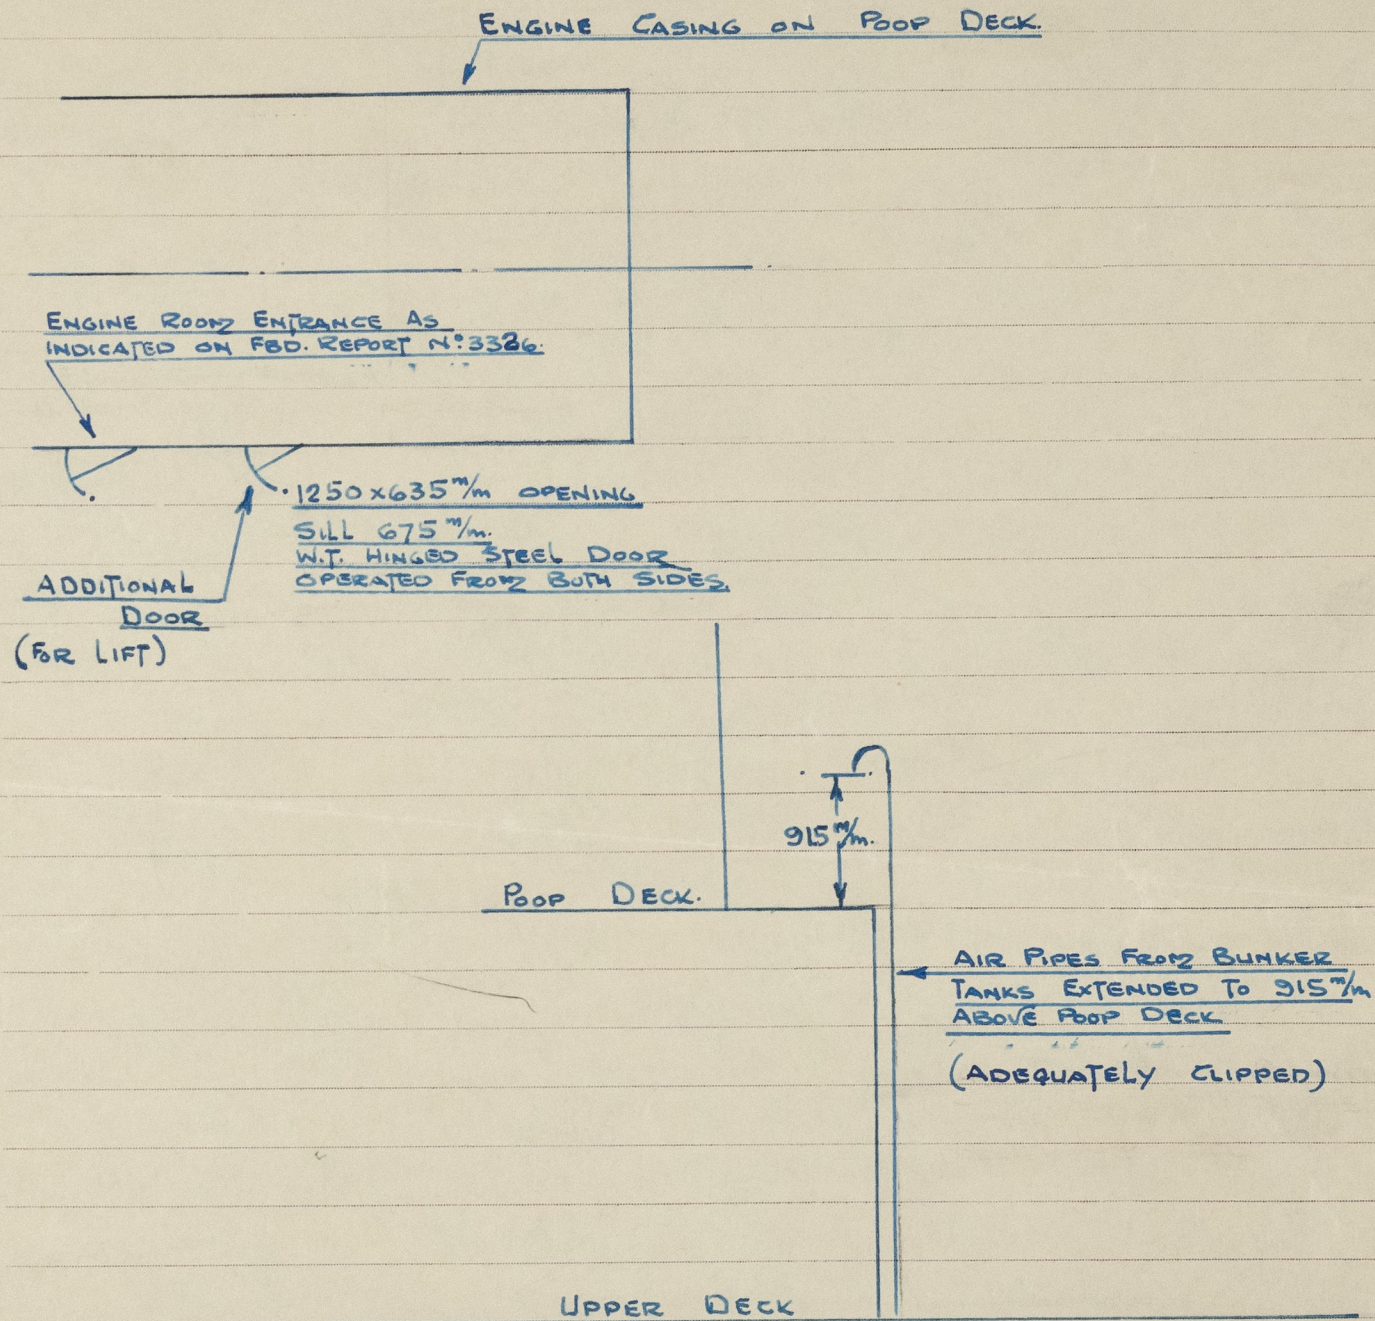

*Princely*

*Noted  
14.4.54*



© 2021

Lloyd's Register  
Foundation