

N<sup>os</sup> 1243-4

MIDSHIP SECTION

COCHRANE & SONS LTD.

SHIPBUILDERS, SELBY

PLAN N<sup>o</sup> 1243/2

DRAWN BY E.T.

MIDSHIP SECTION

N<sup>os</sup> 1243-4

105'-0" B.P. x 26'-6" MLD. x 13'-0" MLD.

TO CLASS  $\nabla$  100A.1. FOR TOWING SERVICES

SCALE  $\frac{1}{2}$  IN = 1 FT.

N<sup>os</sup> 1243-4


MIDSHIP SECTION

COCHRANE & SONS LTD.

SHIPBUILDERS, SELBY

PLAN N<sup>o</sup> 1243/2

DRAWN BY E.T.

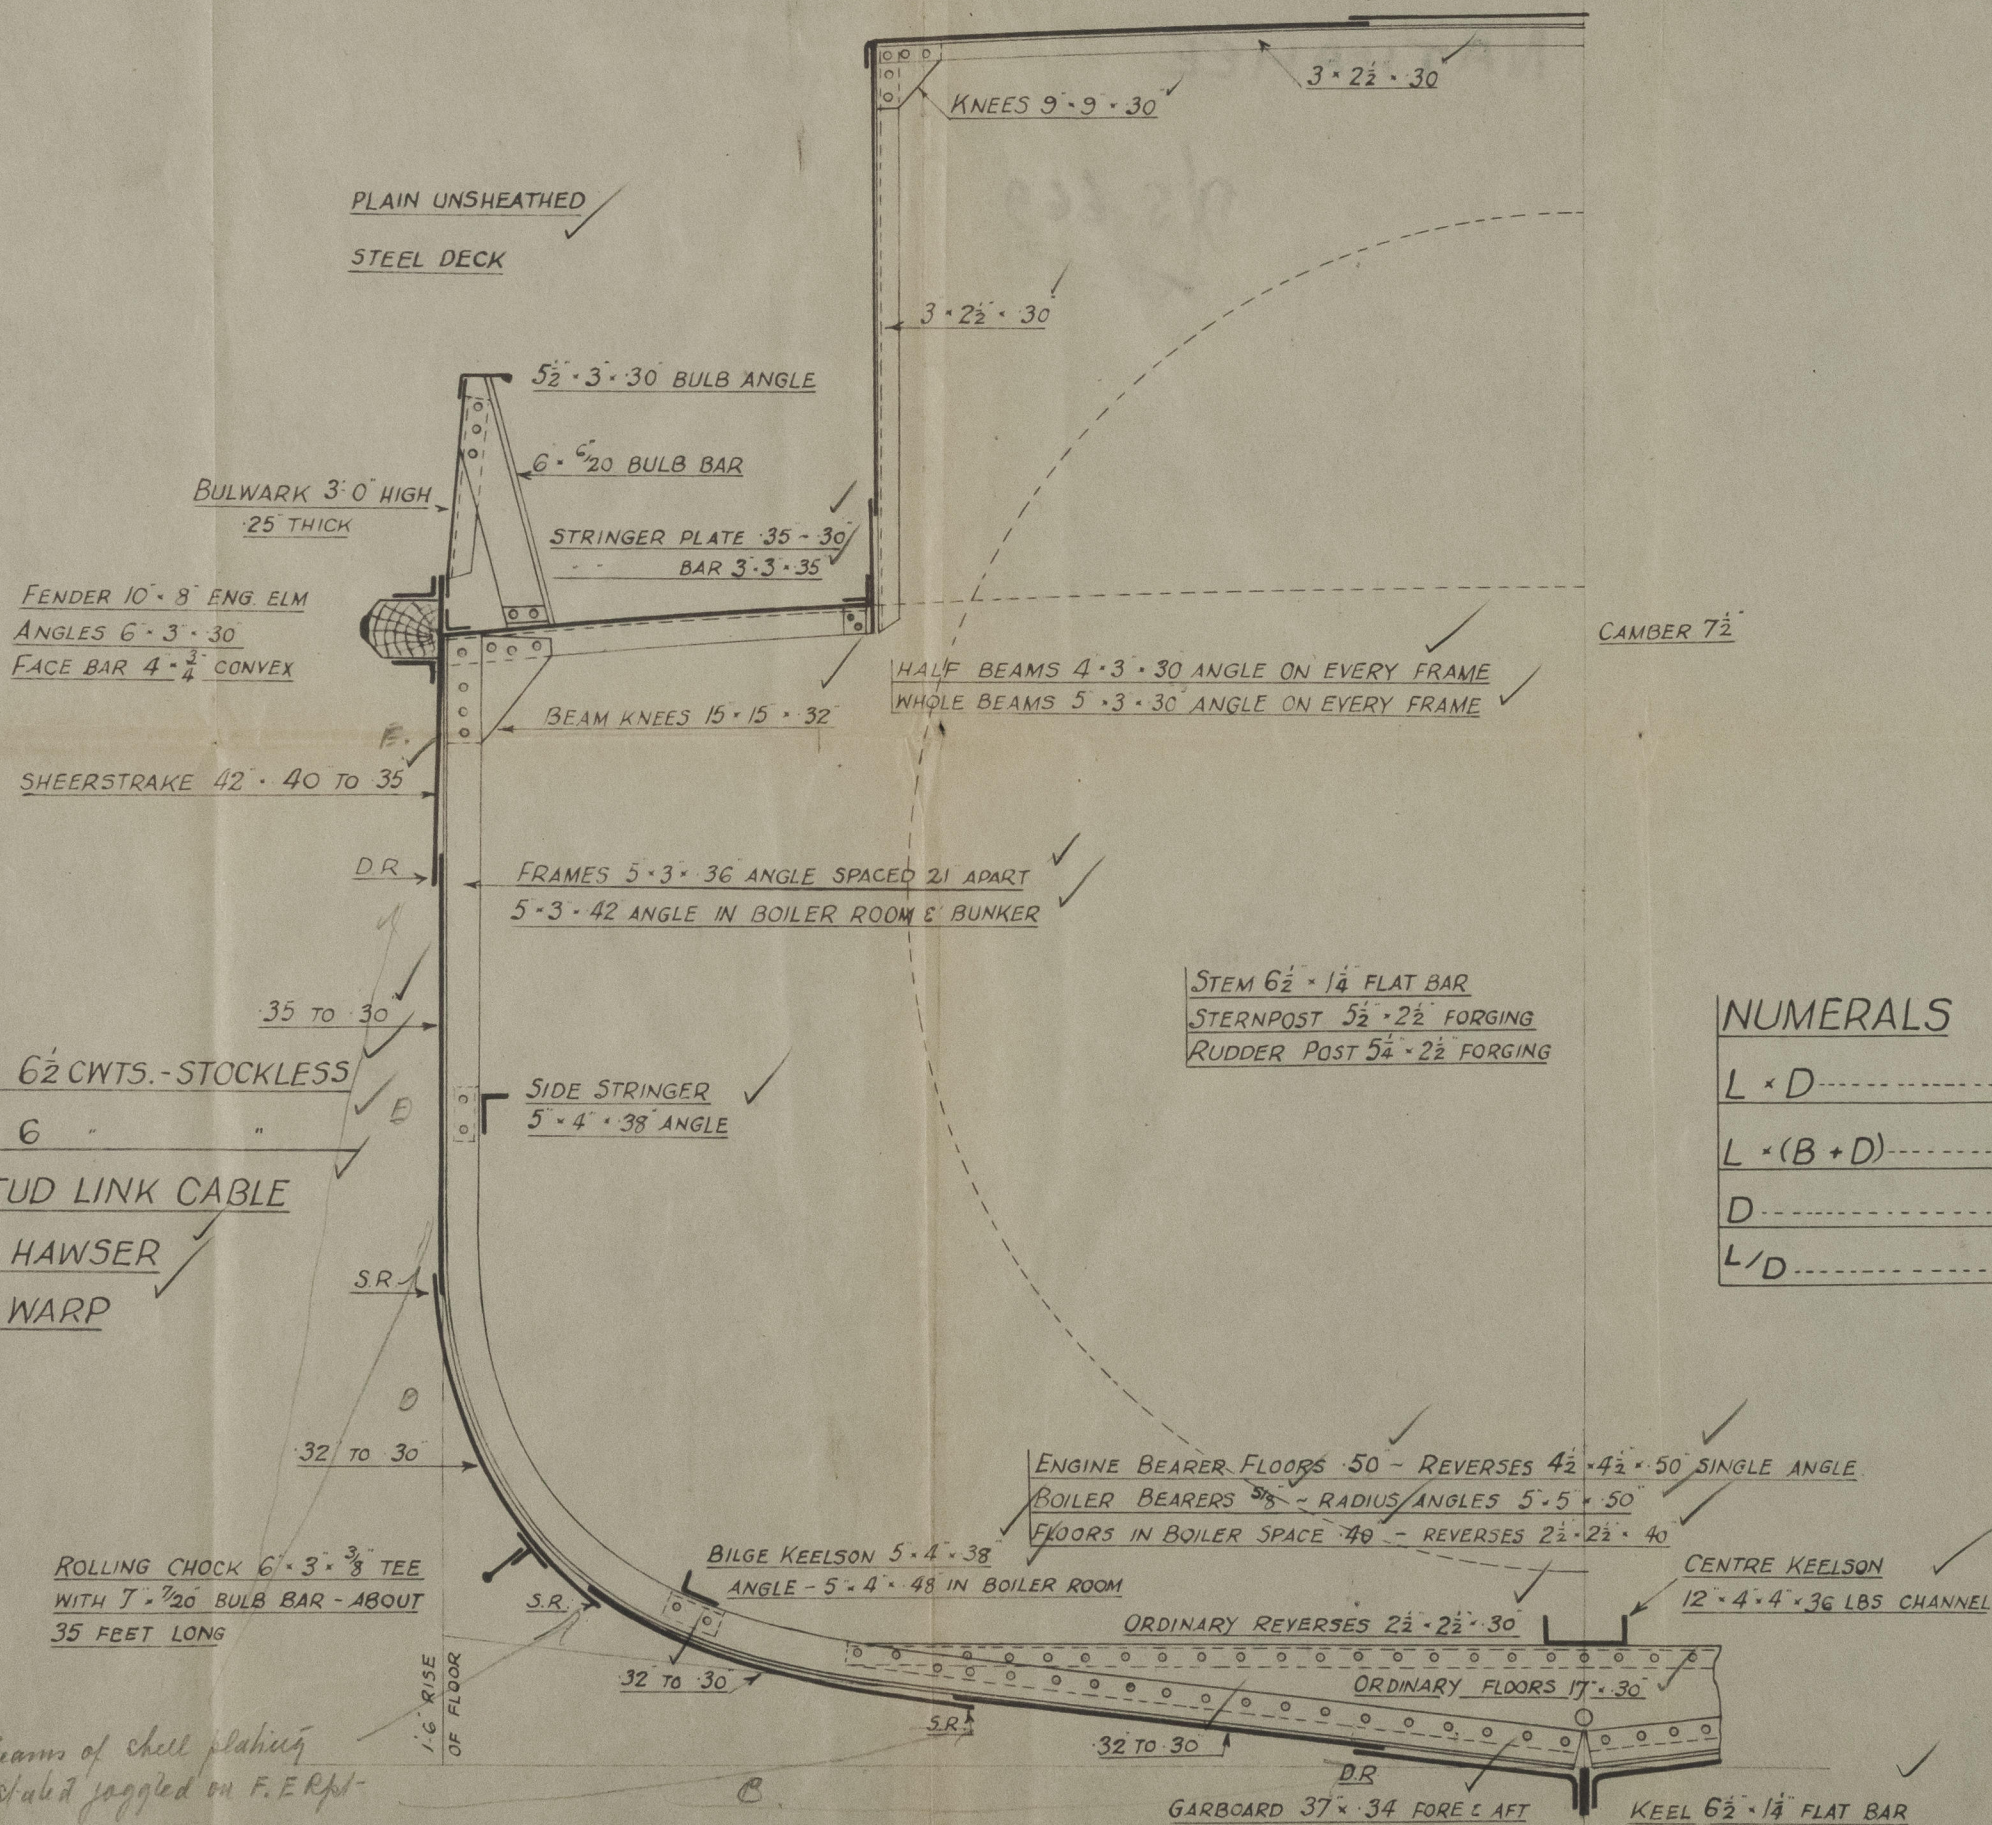

EQUIPMENT

1<sup>ST</sup> BOWER ANCHOR 62 CWTs. - STOCKLESS

2<sup>ND</sup> " " 6 " "

90 FMS. 1" DIA. STUD LINK CABLE

60 FMS. 6" HEMP HAWSER

60 FMS. 4 1/2" HEMP WARP

NUMERALS

L x D ..... 1365

L x (B + D) ..... 4147.5

D ..... 13

L/D ..... 8.1



© 2020  
25.7.41  
Lloyd's Register  
Foundation



RECORDS DEPT.,  
LONDON

*Midship Section*

*Cochrane 1243/4*

2

HULD

*Messrs Cochrane & Sons. Ltd.*

*Yard No 1243-4.*

*Midship Section*

COMPUTERISED

"NATHAMEE"

*7/s. 669*



© 2020

Lloyd's Register  
Foundation

008925-006937-0003