

- ✓ SCANTLING NOS ✓  
 ✓ B+D = 35.95 TRANSVERSE  
 ✓ L(B+D) = 4673.5 LONGITUDINAL  
 ✓  $\bar{a} = 11.75$   
 ✓ B = 22.87

NUMERAL FOR RUDDER ~~50~~  
 SPEED 10/2 KNOTS

4.10.12


# N<sup>os</sup> 269 A.43 MIDSHIP SECTION

SCALE 1/2" = 1 FOOT ✓

DIMENSIONS:- 130-0 BP x 23-0 EX x 13-1 M<sup>LD</sup> DEPTH 12-5 HOLD ✓

CLASS 100.A1 ✓  
 STEAM TRAWLER ✓  
 STEEL ✓

EQUIPMENT	
✓ 1 ANCHOR	7 1/4 CWT STOCKLESS
✓ 1 "	5 1/4 " EX STOCK
✓ 1 "	3 "
✓ 105 FTHMS	1 1/16" STUD LINK CABLE
✓ 60 "	6" HAWSER
✓ 60 "	5" WARP

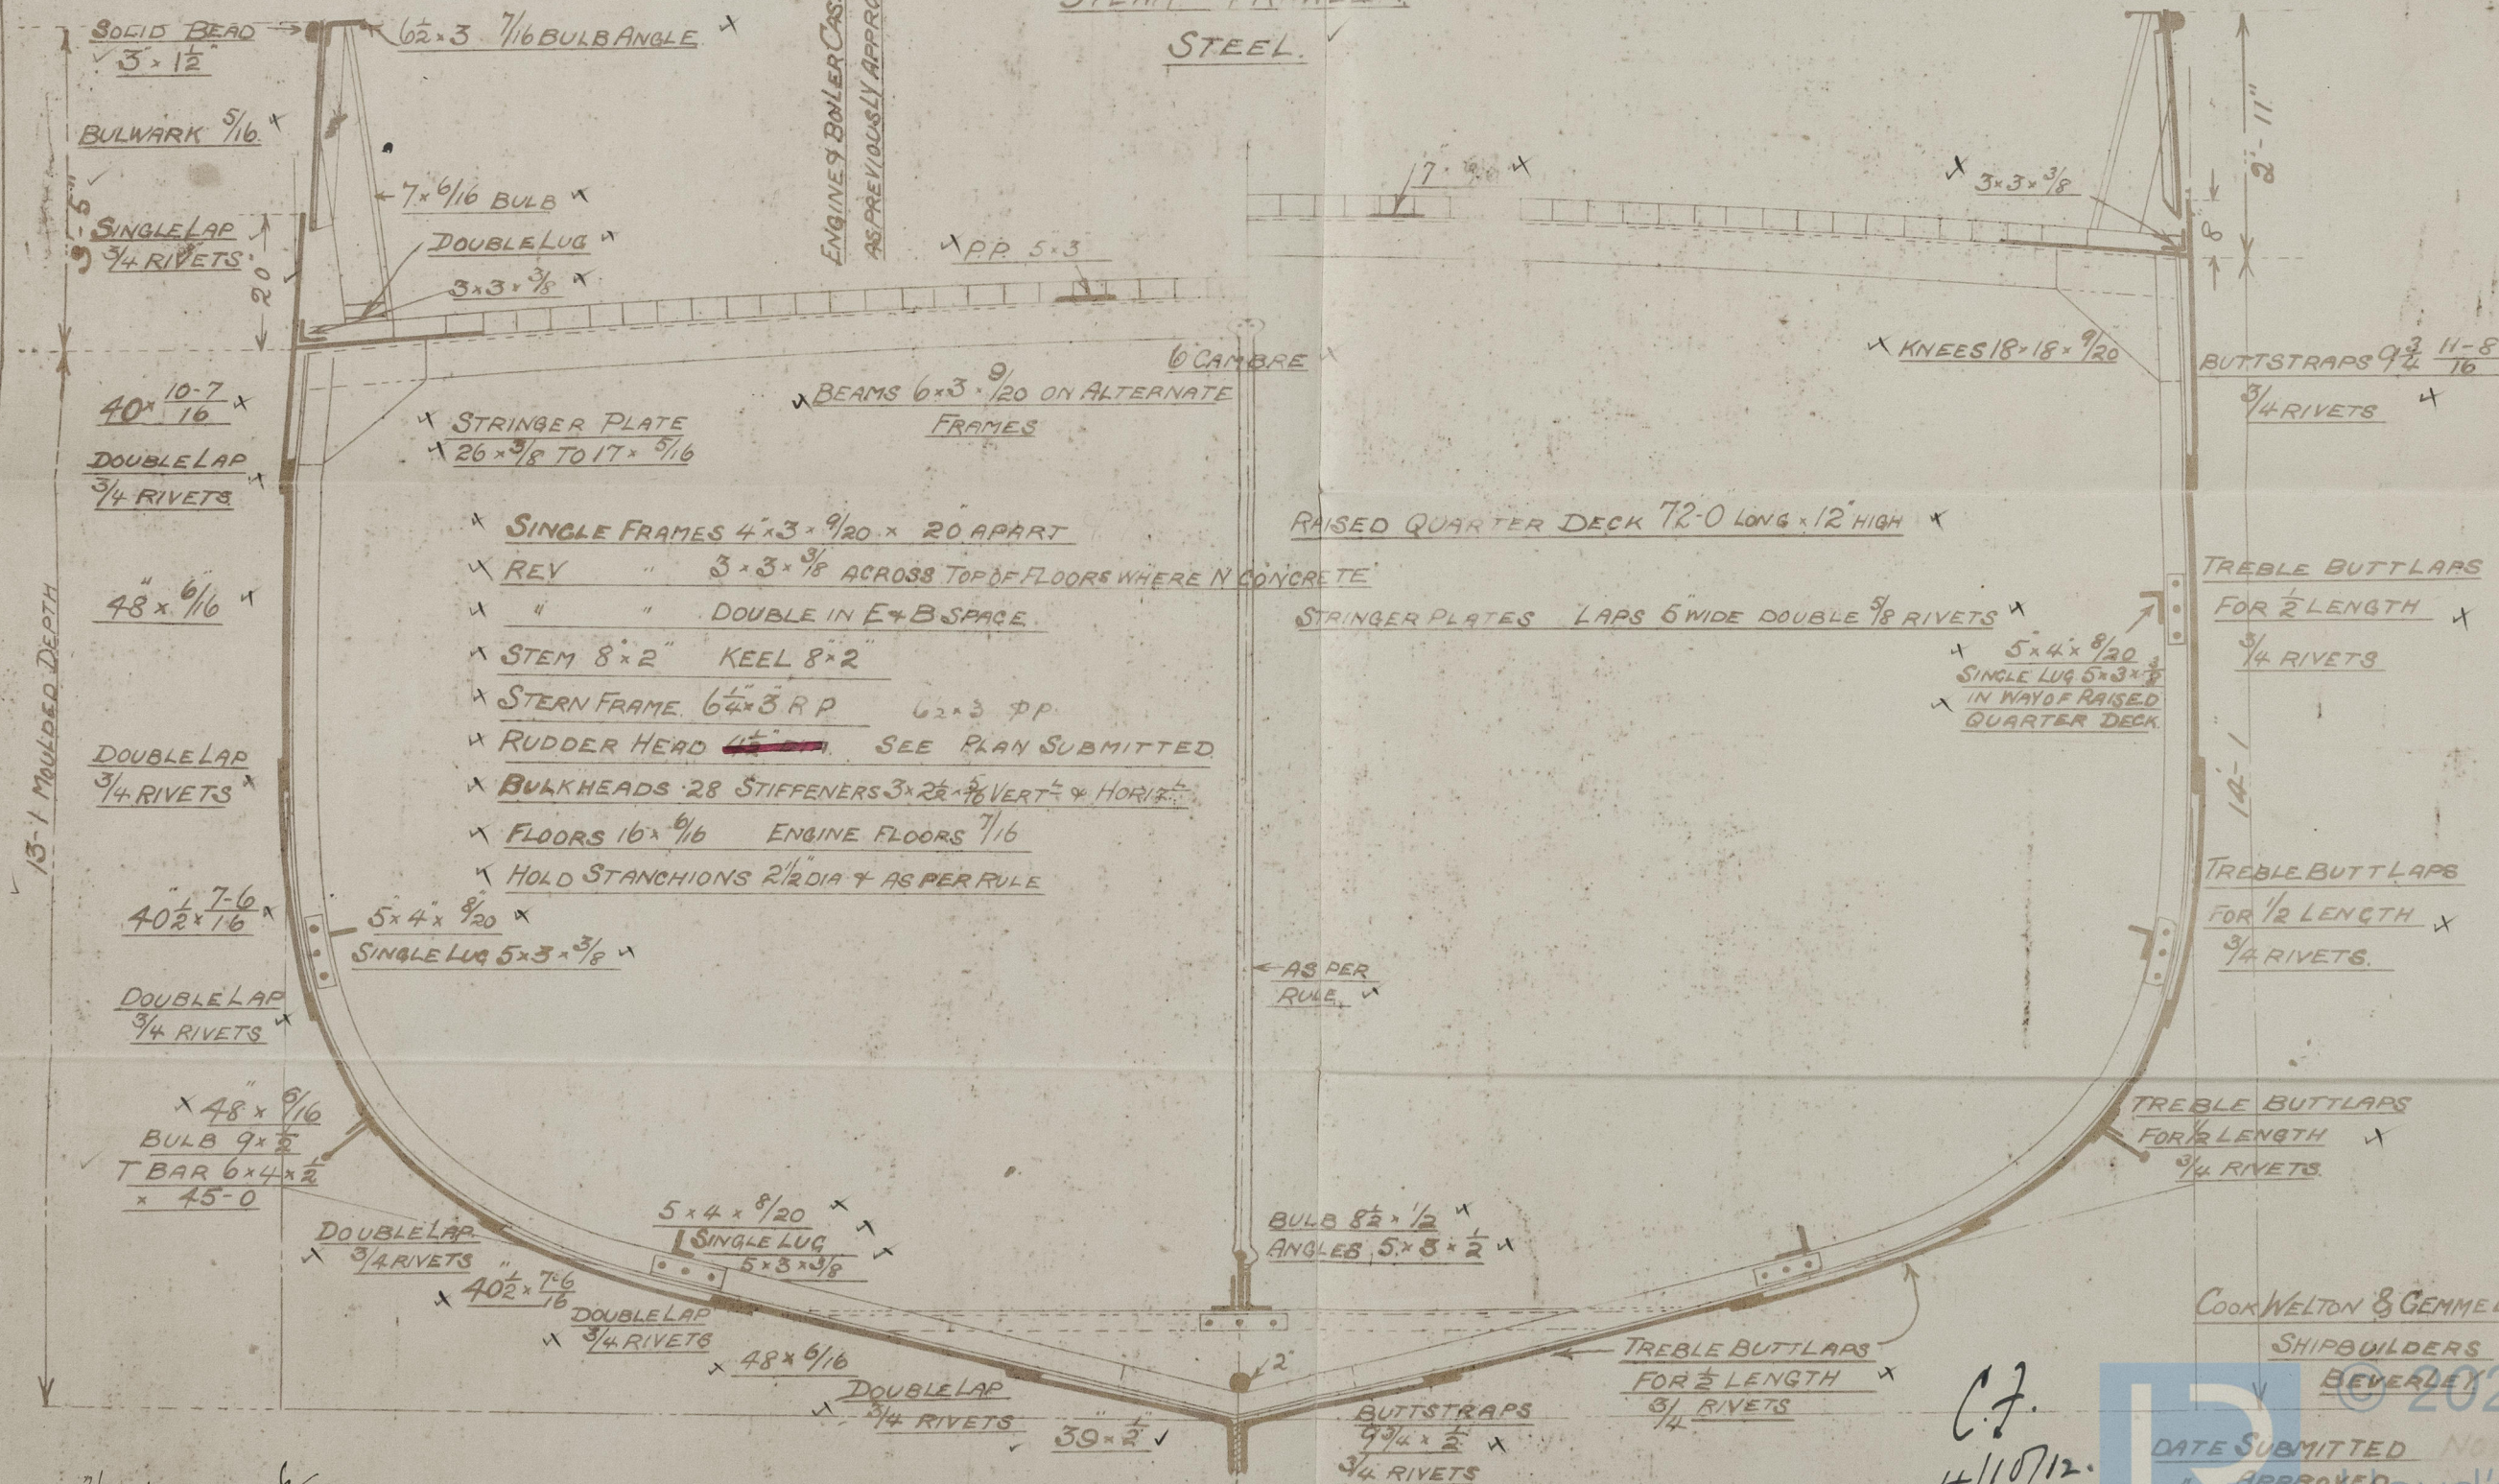

COOK WELTON & GEMMELL LTD


SHIPBUILDERS

BEVERLEY


APPROVED


C.F.  
4/10/12

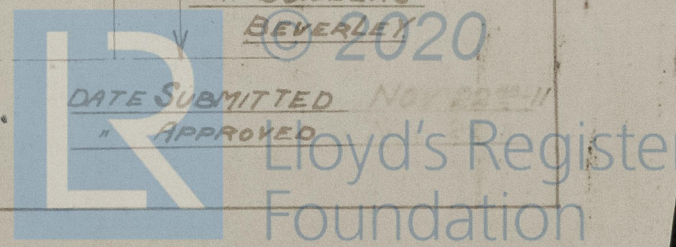




Cook, Welton & Gemmell  
No. 269-A.

Midship Section

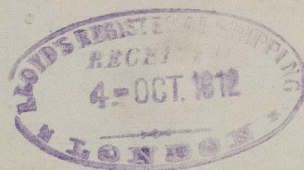

& United

Hull Report No: 26761

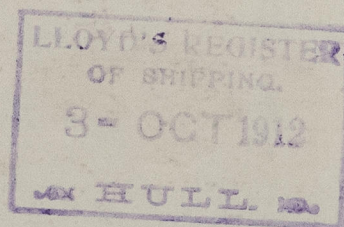

© 2020

Lloyd's Register  
Foundation