
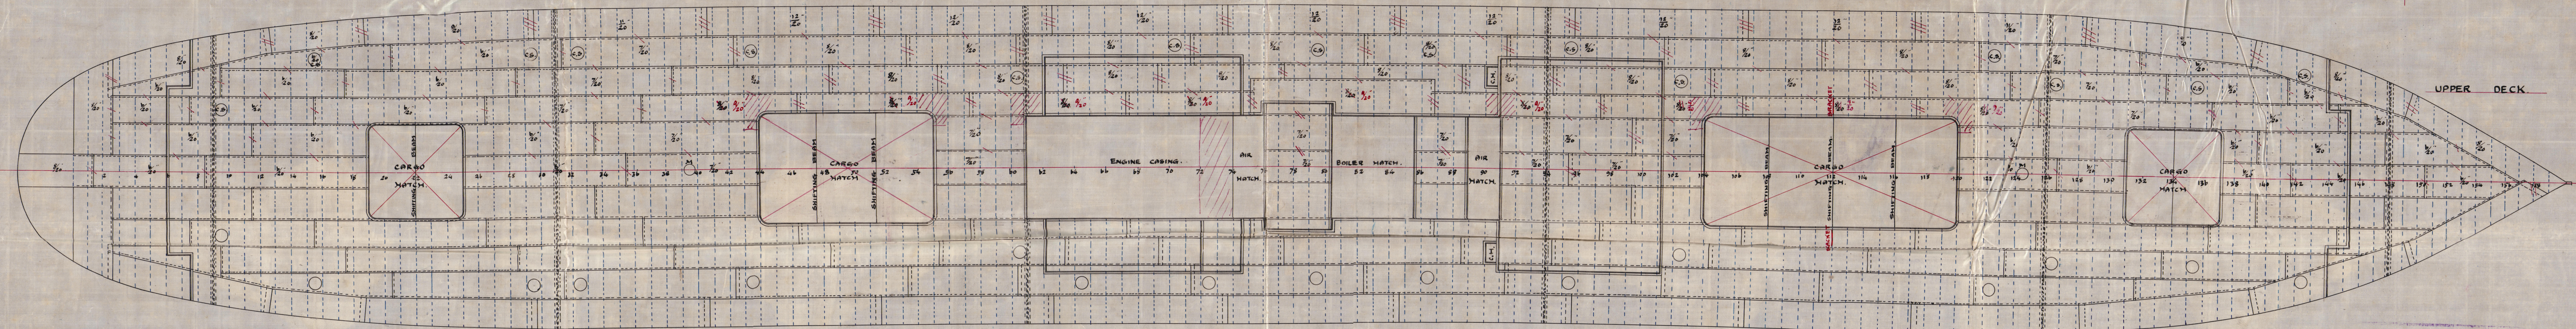


22-3-01

N^{os} 131 & 134. CONSTRUCTION PROFILE. SCALE $\frac{1}{8}$ INCH TO ONE FOOT.

RIVETING NOTE.
 MARK
 // SINGLE RIVETING.
 /// DOUBLE RIVETING.
 /// TREBLE RIVETING.

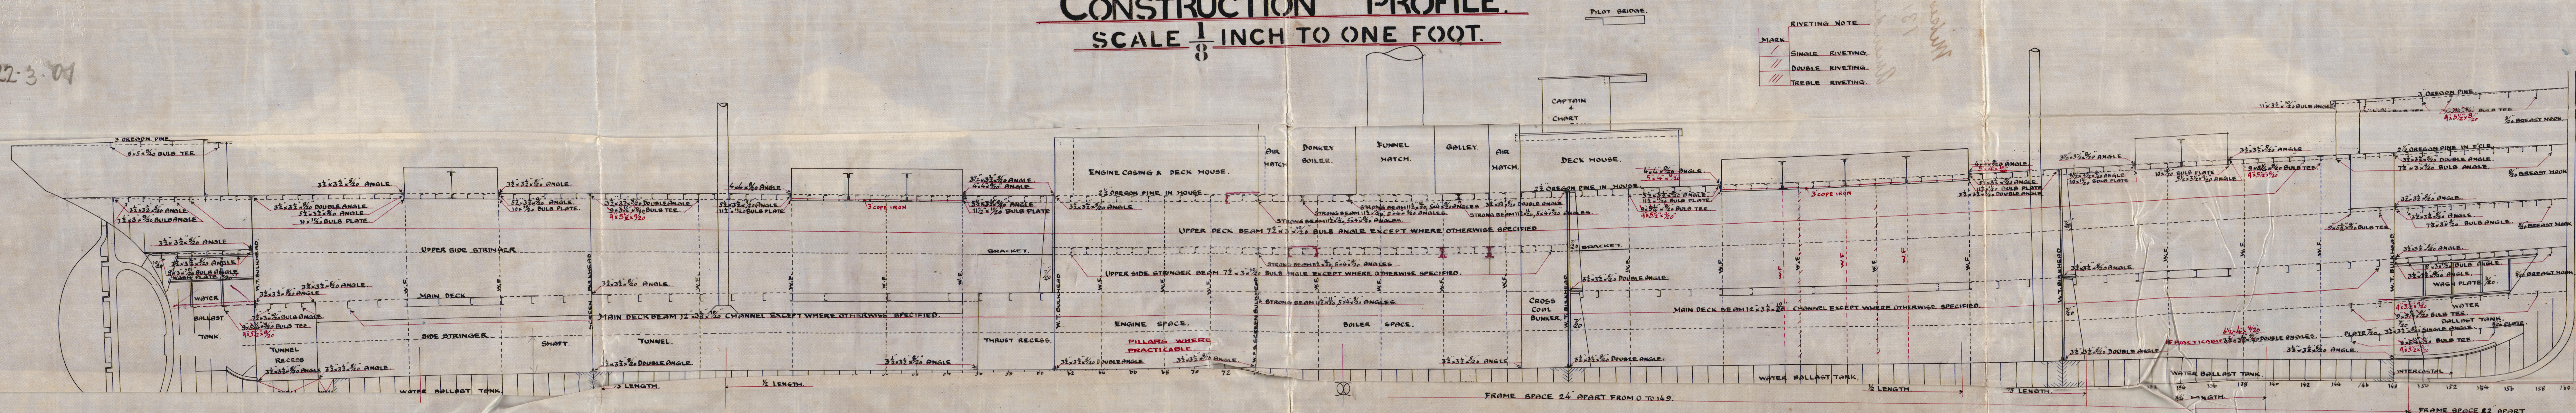

DECK PLAN.

A.L. Jones

22-3-01

MITSUBISHI
 SHIPYARD & ENGINE WORKS
 NAGASAKI

Y. Sugitani
 K. Honda. © 2020

4th Feb 1901

Lloyd's Register
 Foundation

Wakamatsu Inaru Kay. 245
Daiya Inara Kay. 249.



© 2020

Lloyd's Register
Foundation

008925-008937-0248