


LOYD'S.

DIMENSIONS OF VESSEL.	
LENGTH	318.21 FT.
BREADTH	42.00 FT.
DEPTH	26.00 FT.
MEAN DRAUGHT	18.11 FT.
FRAMING NUMBER	84.25
DISPLACEMENT	5497
GROSS TONNAGE ABOUT	2600.
SPEED	10 KNOTS.

N^o 134 **CAST STEEL STERN FRAME &** **BUILT UP BALANCED RUDDER**

SCALE 1 INCH TO ONE FOOT.

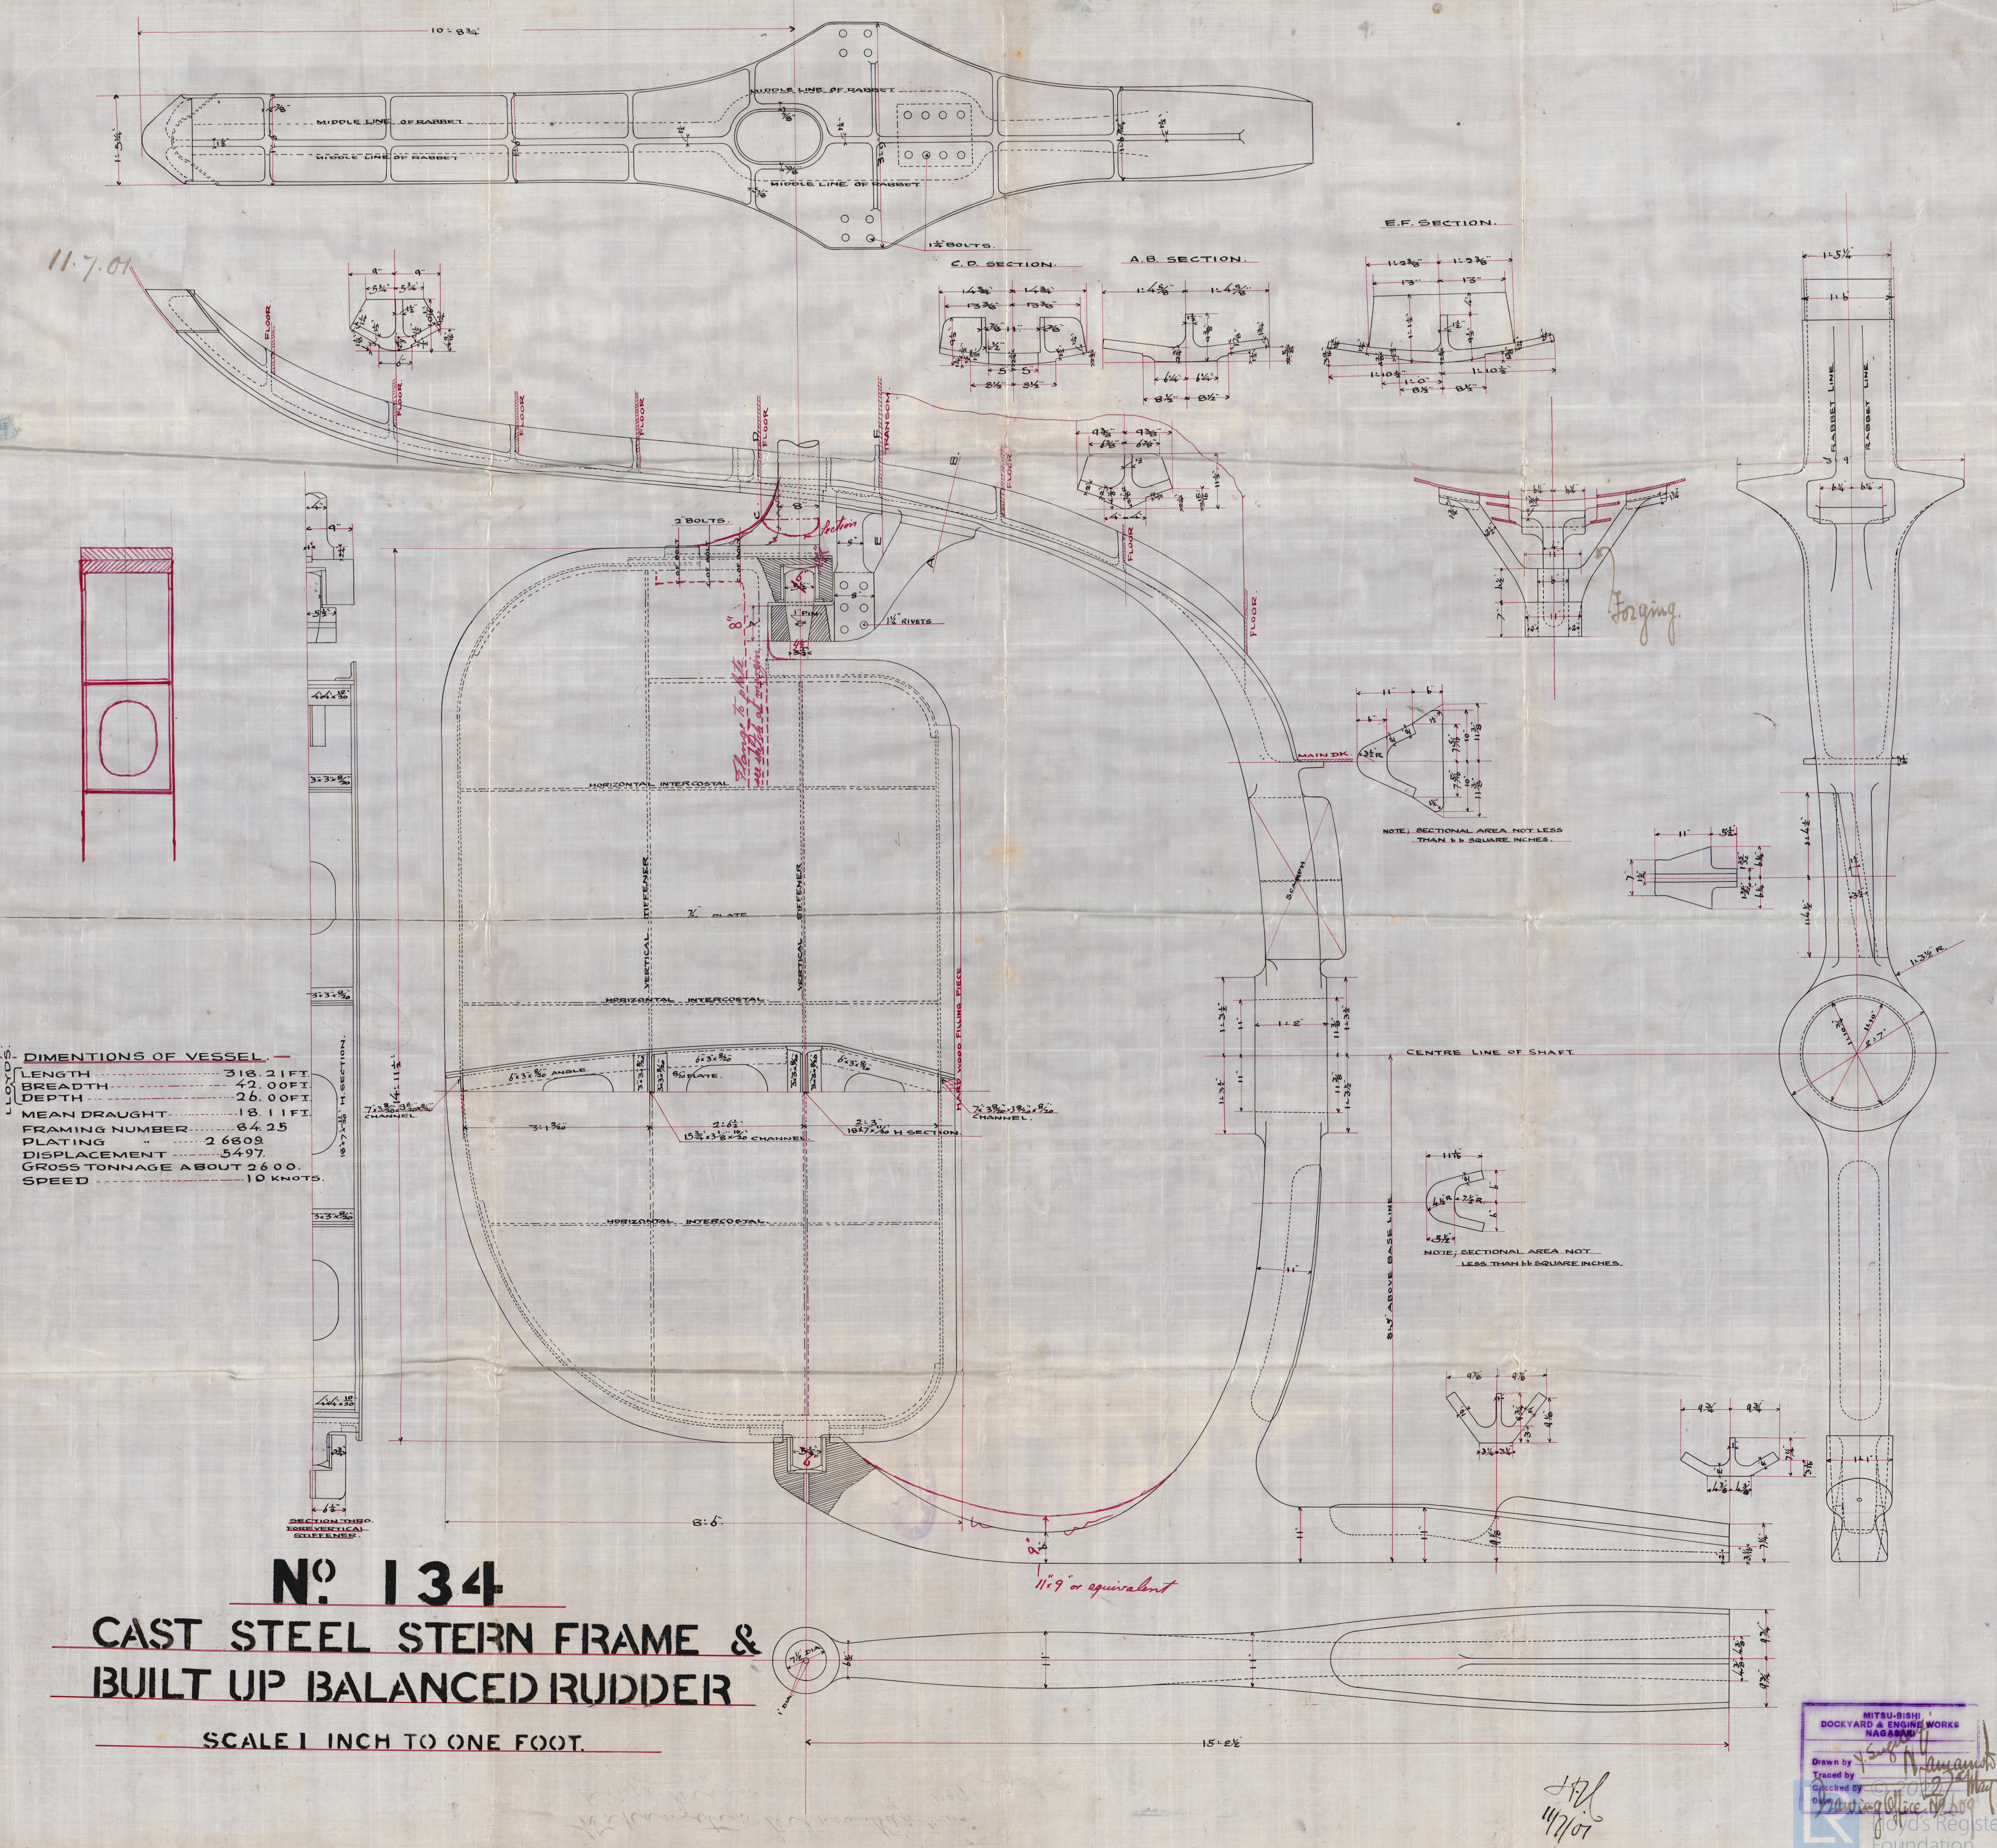



FOOT



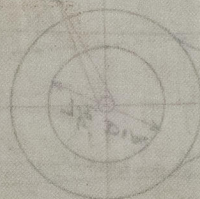

© 2020

Lloyd's Register
Foundation

008925-008937-0250