






№ 933 S.S. TOTAL MARU. STRUCTURAL ARRANGEMENT SCALE 1/8 IN TO ONE FT.

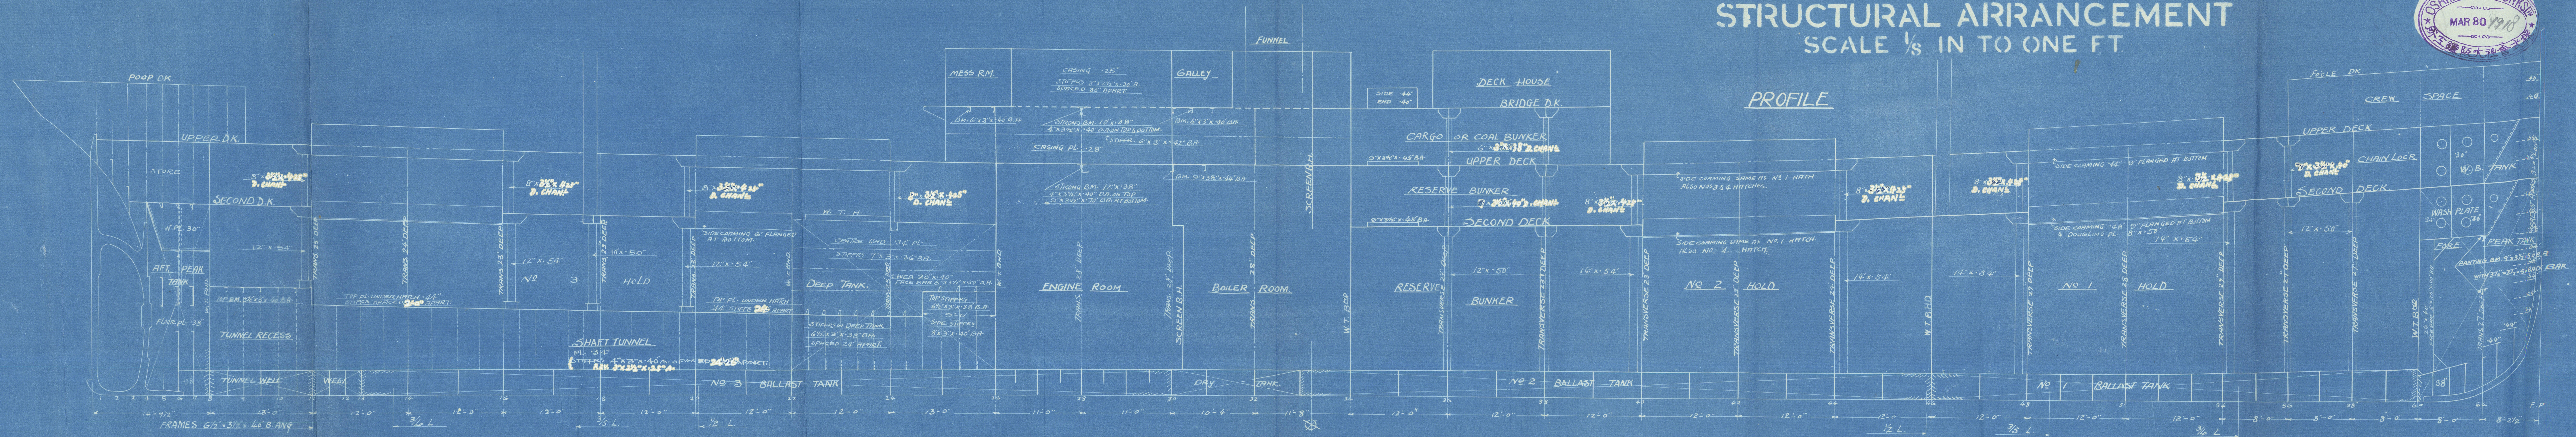

PROFILE

BRIDGE DECK

FORECASTLE DECK

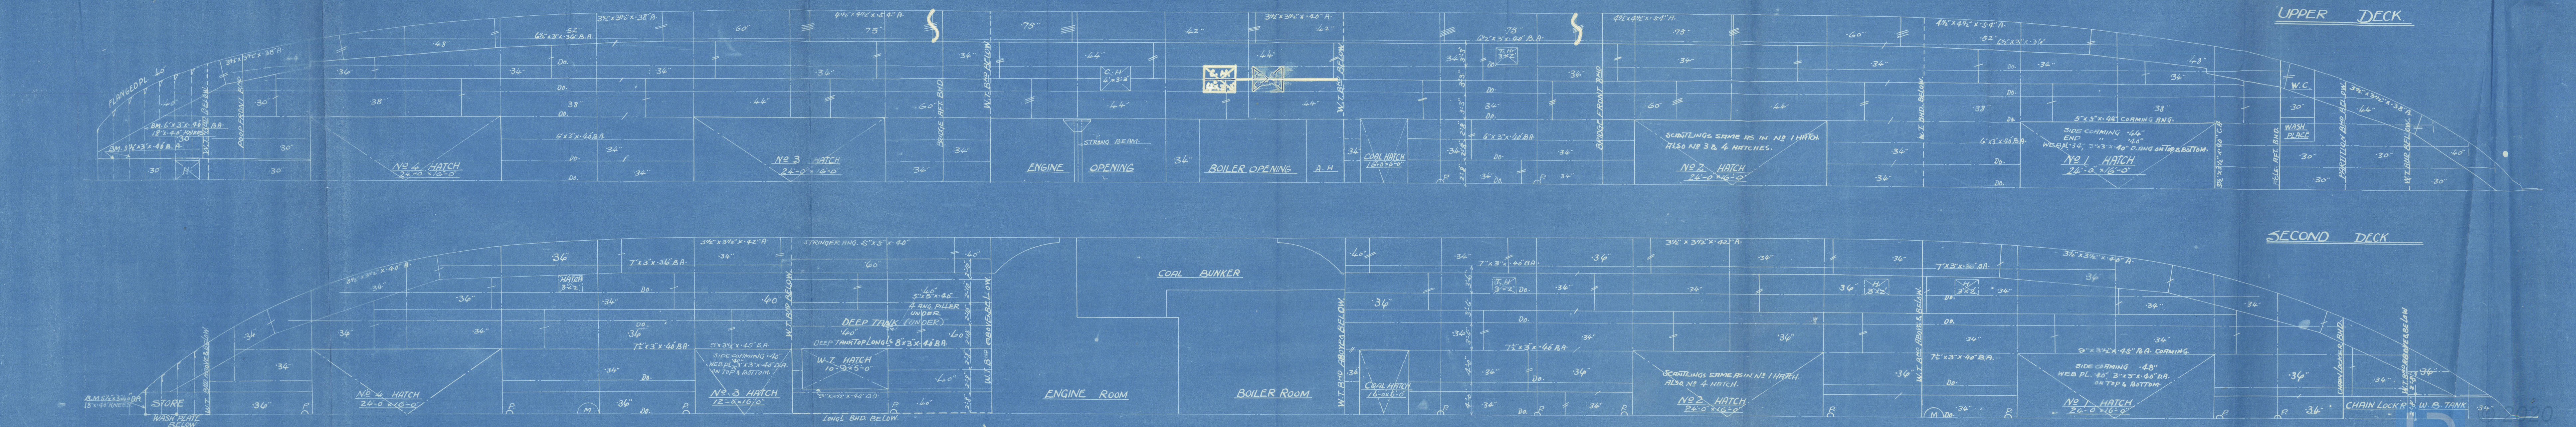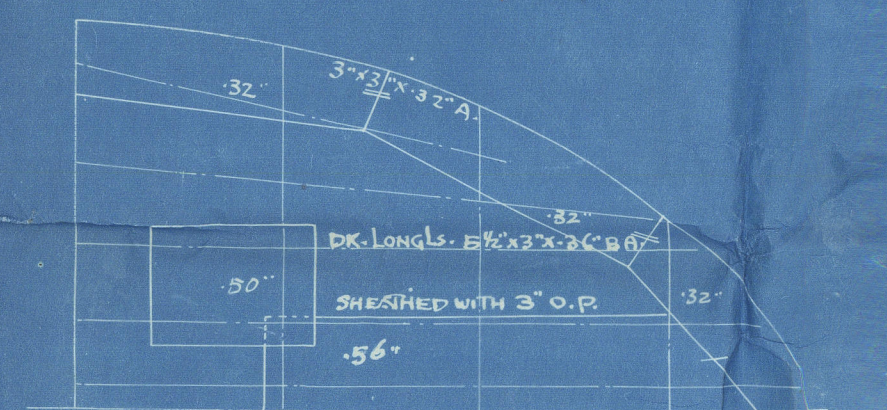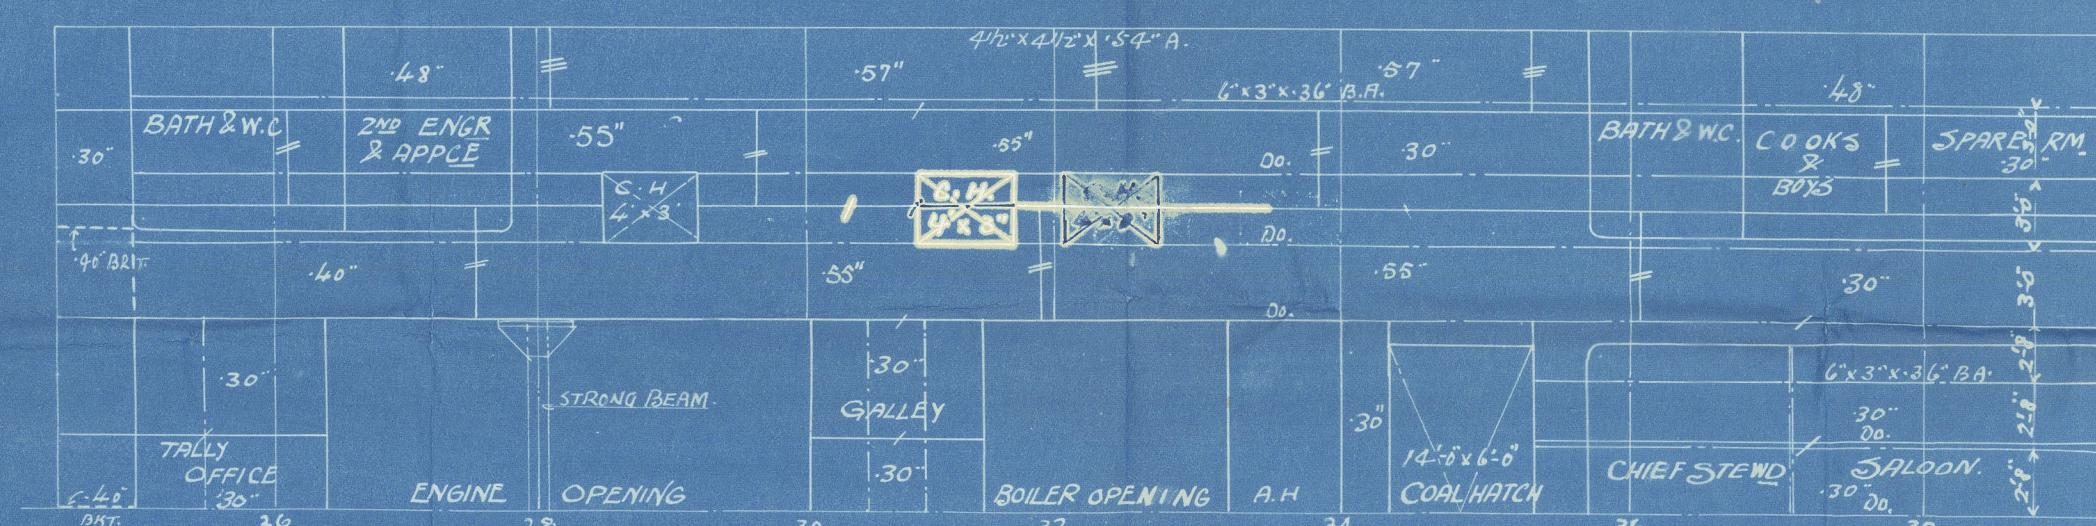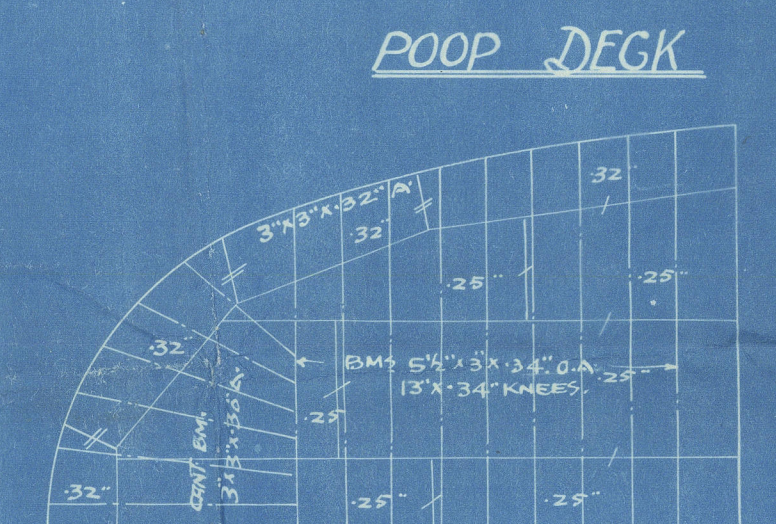

O. I. W.
L. P. No 933
Totai Maru.

Profile.

Nob. Rpt No 2248



© 2020

Lloyd's Register

Foundation 00893840089520092