
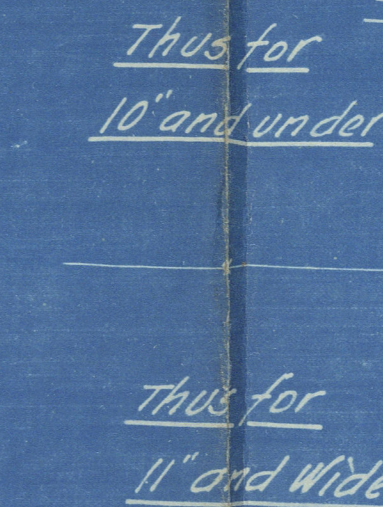



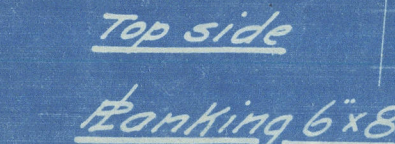

- ① Treenails.
- + spikes.
- Butt Bolts. clinched
- " " drifted.


① Drift Bolts Driven from inside.
 ② " " " " " outside.
 ③ $\frac{1}{4}$ " Edge Bolts $2\frac{1}{2}$ " stroke Length.

Length o.a.	250' - 0"
Length on deck B.P.	231' - 0"
" " " LWL	227' - 0"
" " " Keel	208' - 0"
Breadth extreme	45' - 1 1/2"
" Moulded	44' - 0"
Depth	21' - 0"

J.H.PRICE SHIPBUILDING Co
SEATTLE WA

July 1917 CD MEYER DR. NO. 1	ALTERED MAY 1919 <i>H. J. Gandy</i>
------------------------------------	--

J. H. Price Shipbuilding Coy.
~~late Sandstrom Shipbuilding Coy.~~
4 masted wood sailing schooner
"Blaetind" Yard no. 7.

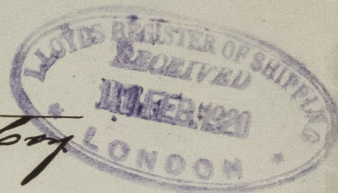

Dimensions

L.W.L. 228' 0" x 45' 0" (bet.) x 21' 4" (md.)

Midship section & portering plan