


PROPOSED · TWIN · SCREW · FERRY · STEAMER FOR THE FLEETWOOD · URBAN · DISTRICT · COUNCIL .

SECTION AT N° 16.

SCALE. 1" = 1 FOOT.

MIDSHIP SECTION :

10/3/24.

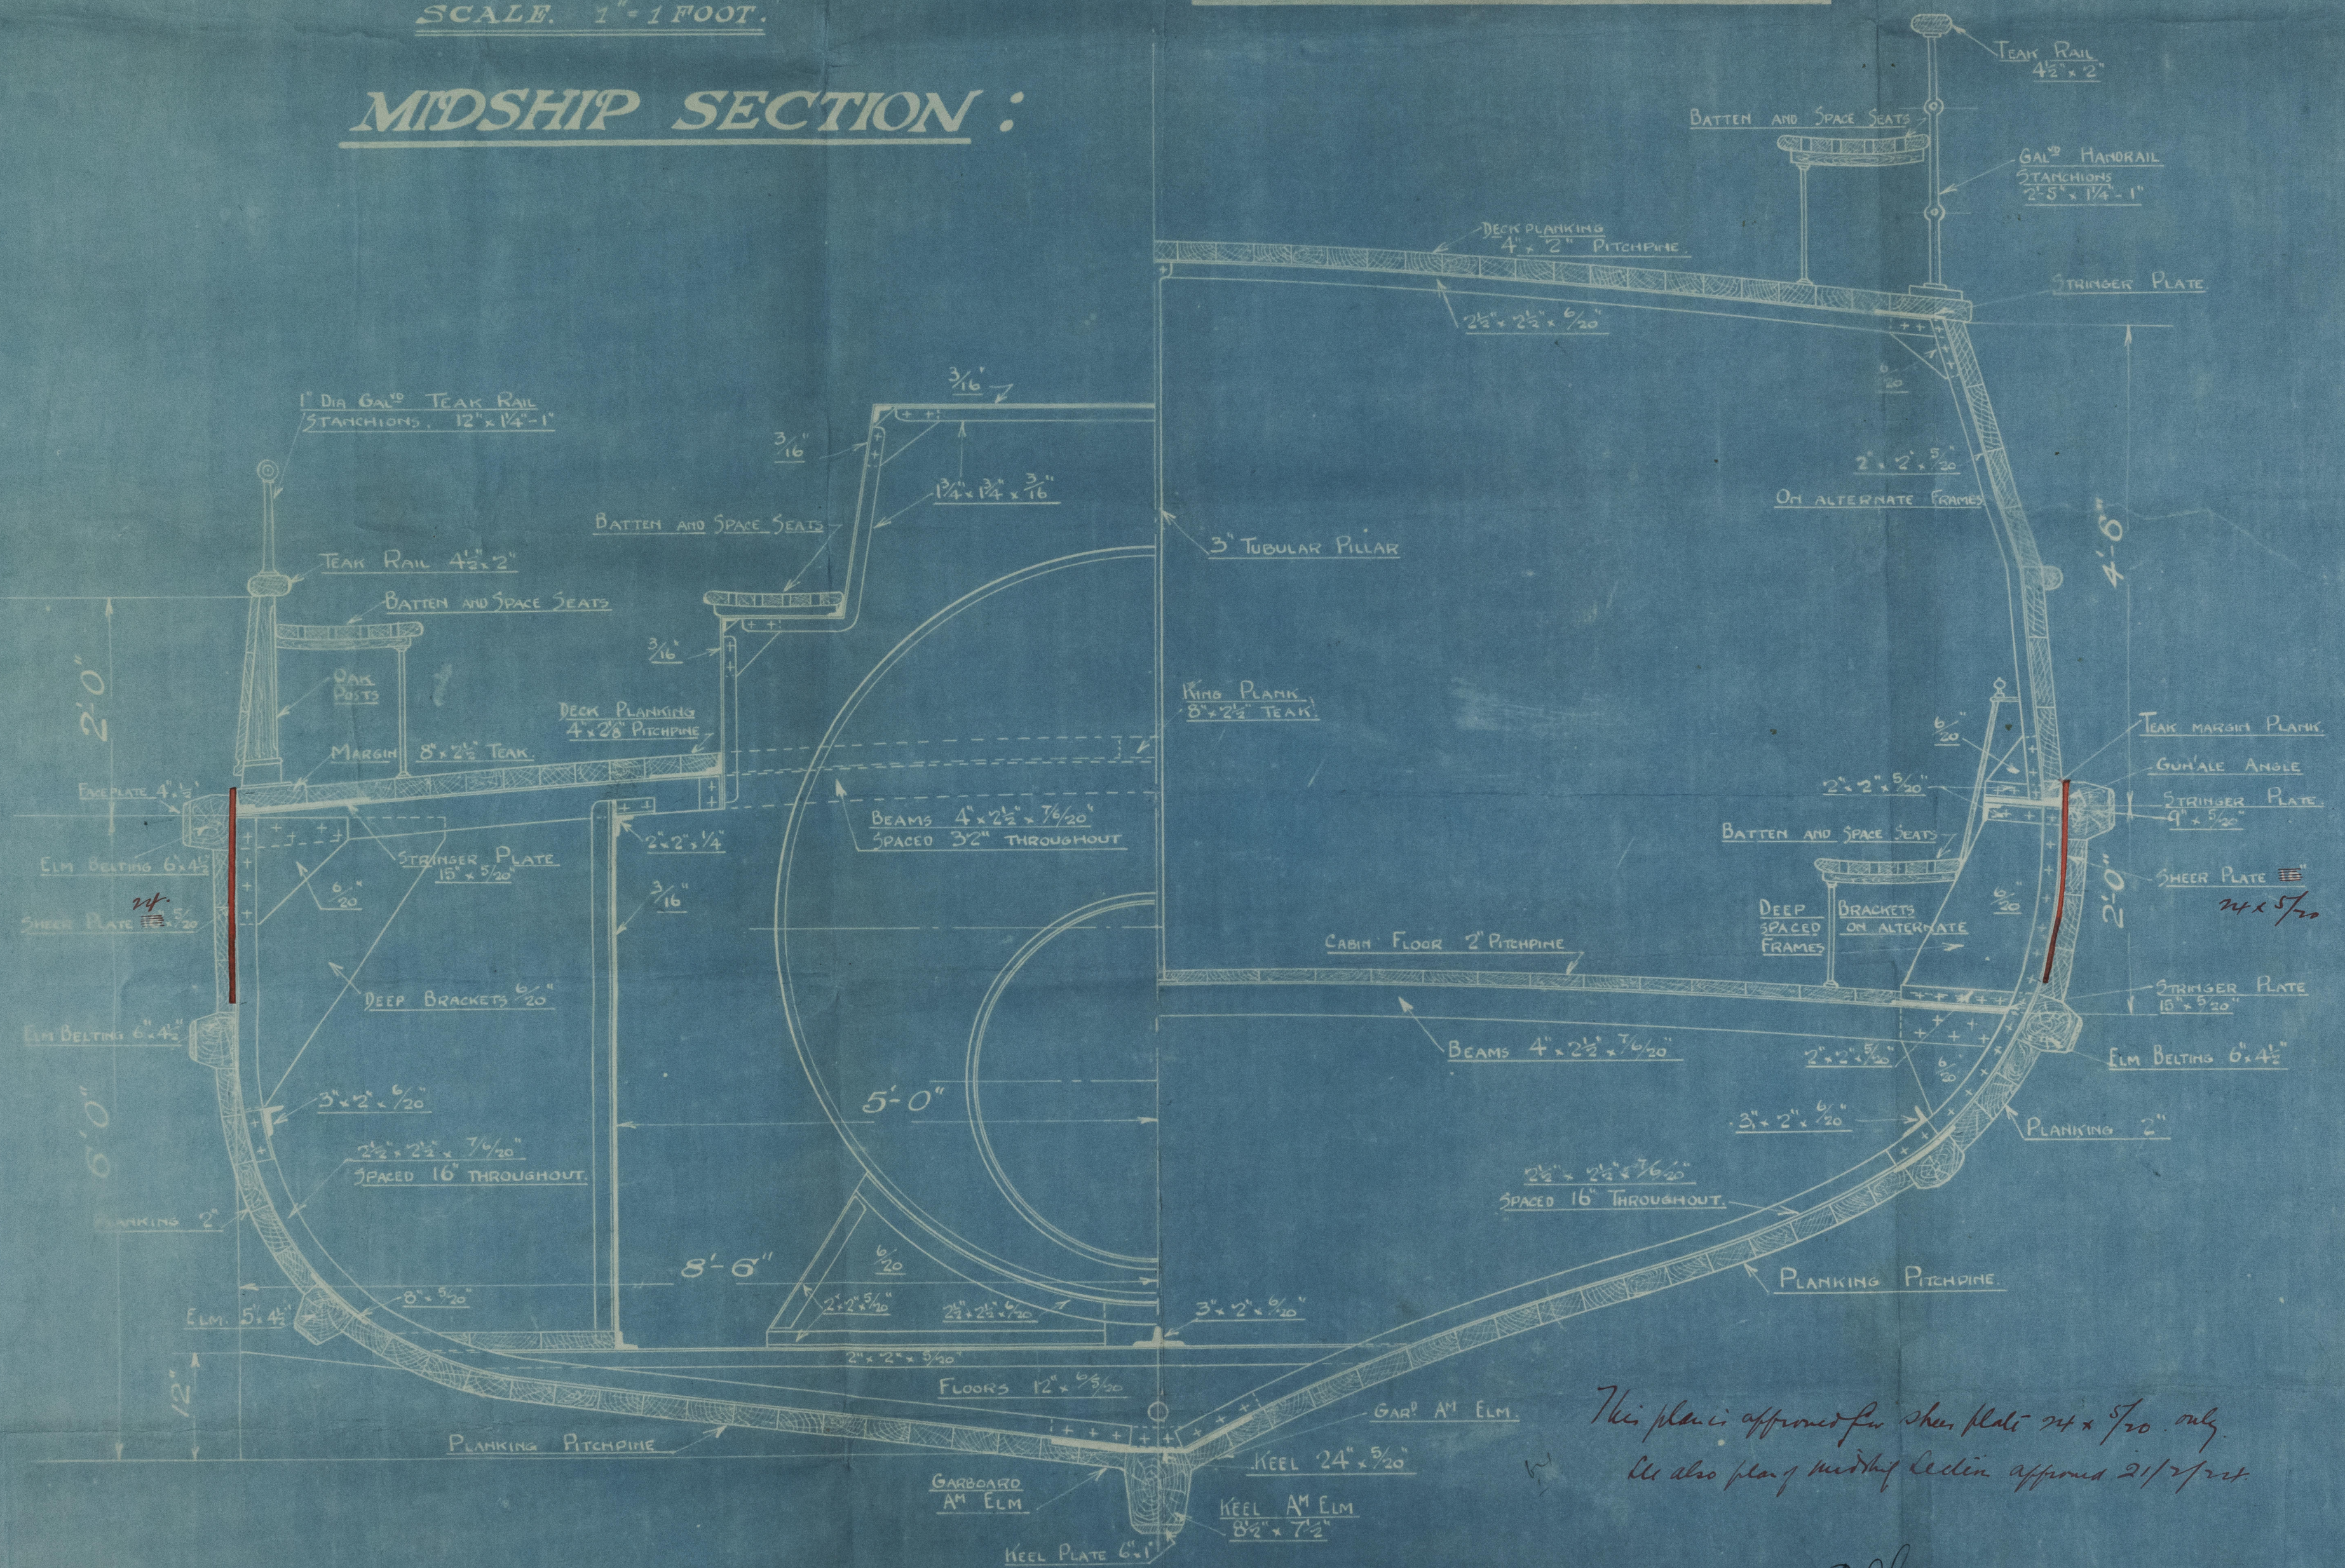

This plan is approved for shear plate 24 x 5/20 only.
 It also plans midship section approved 21/2/24.

BCL
 10/3/24