

26 MAR 1948

SS SOUTHERN ISLAND

SKETCH PLAN
STERN FRAME & RUDDER

SCALE 1" = 1 FT


DWG. NO. 12

STATED SPEED = 8 1/2 KNOTS


A x D = 260

KEYWAY 1 7/8" x 3/4"

5 BOLTS : 2" DIA
10" PITCH CIRCLE

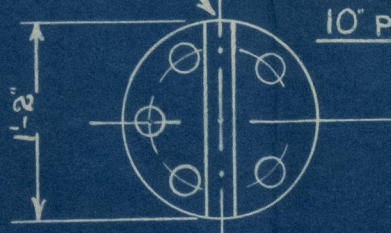

PLAN OF COUPLING

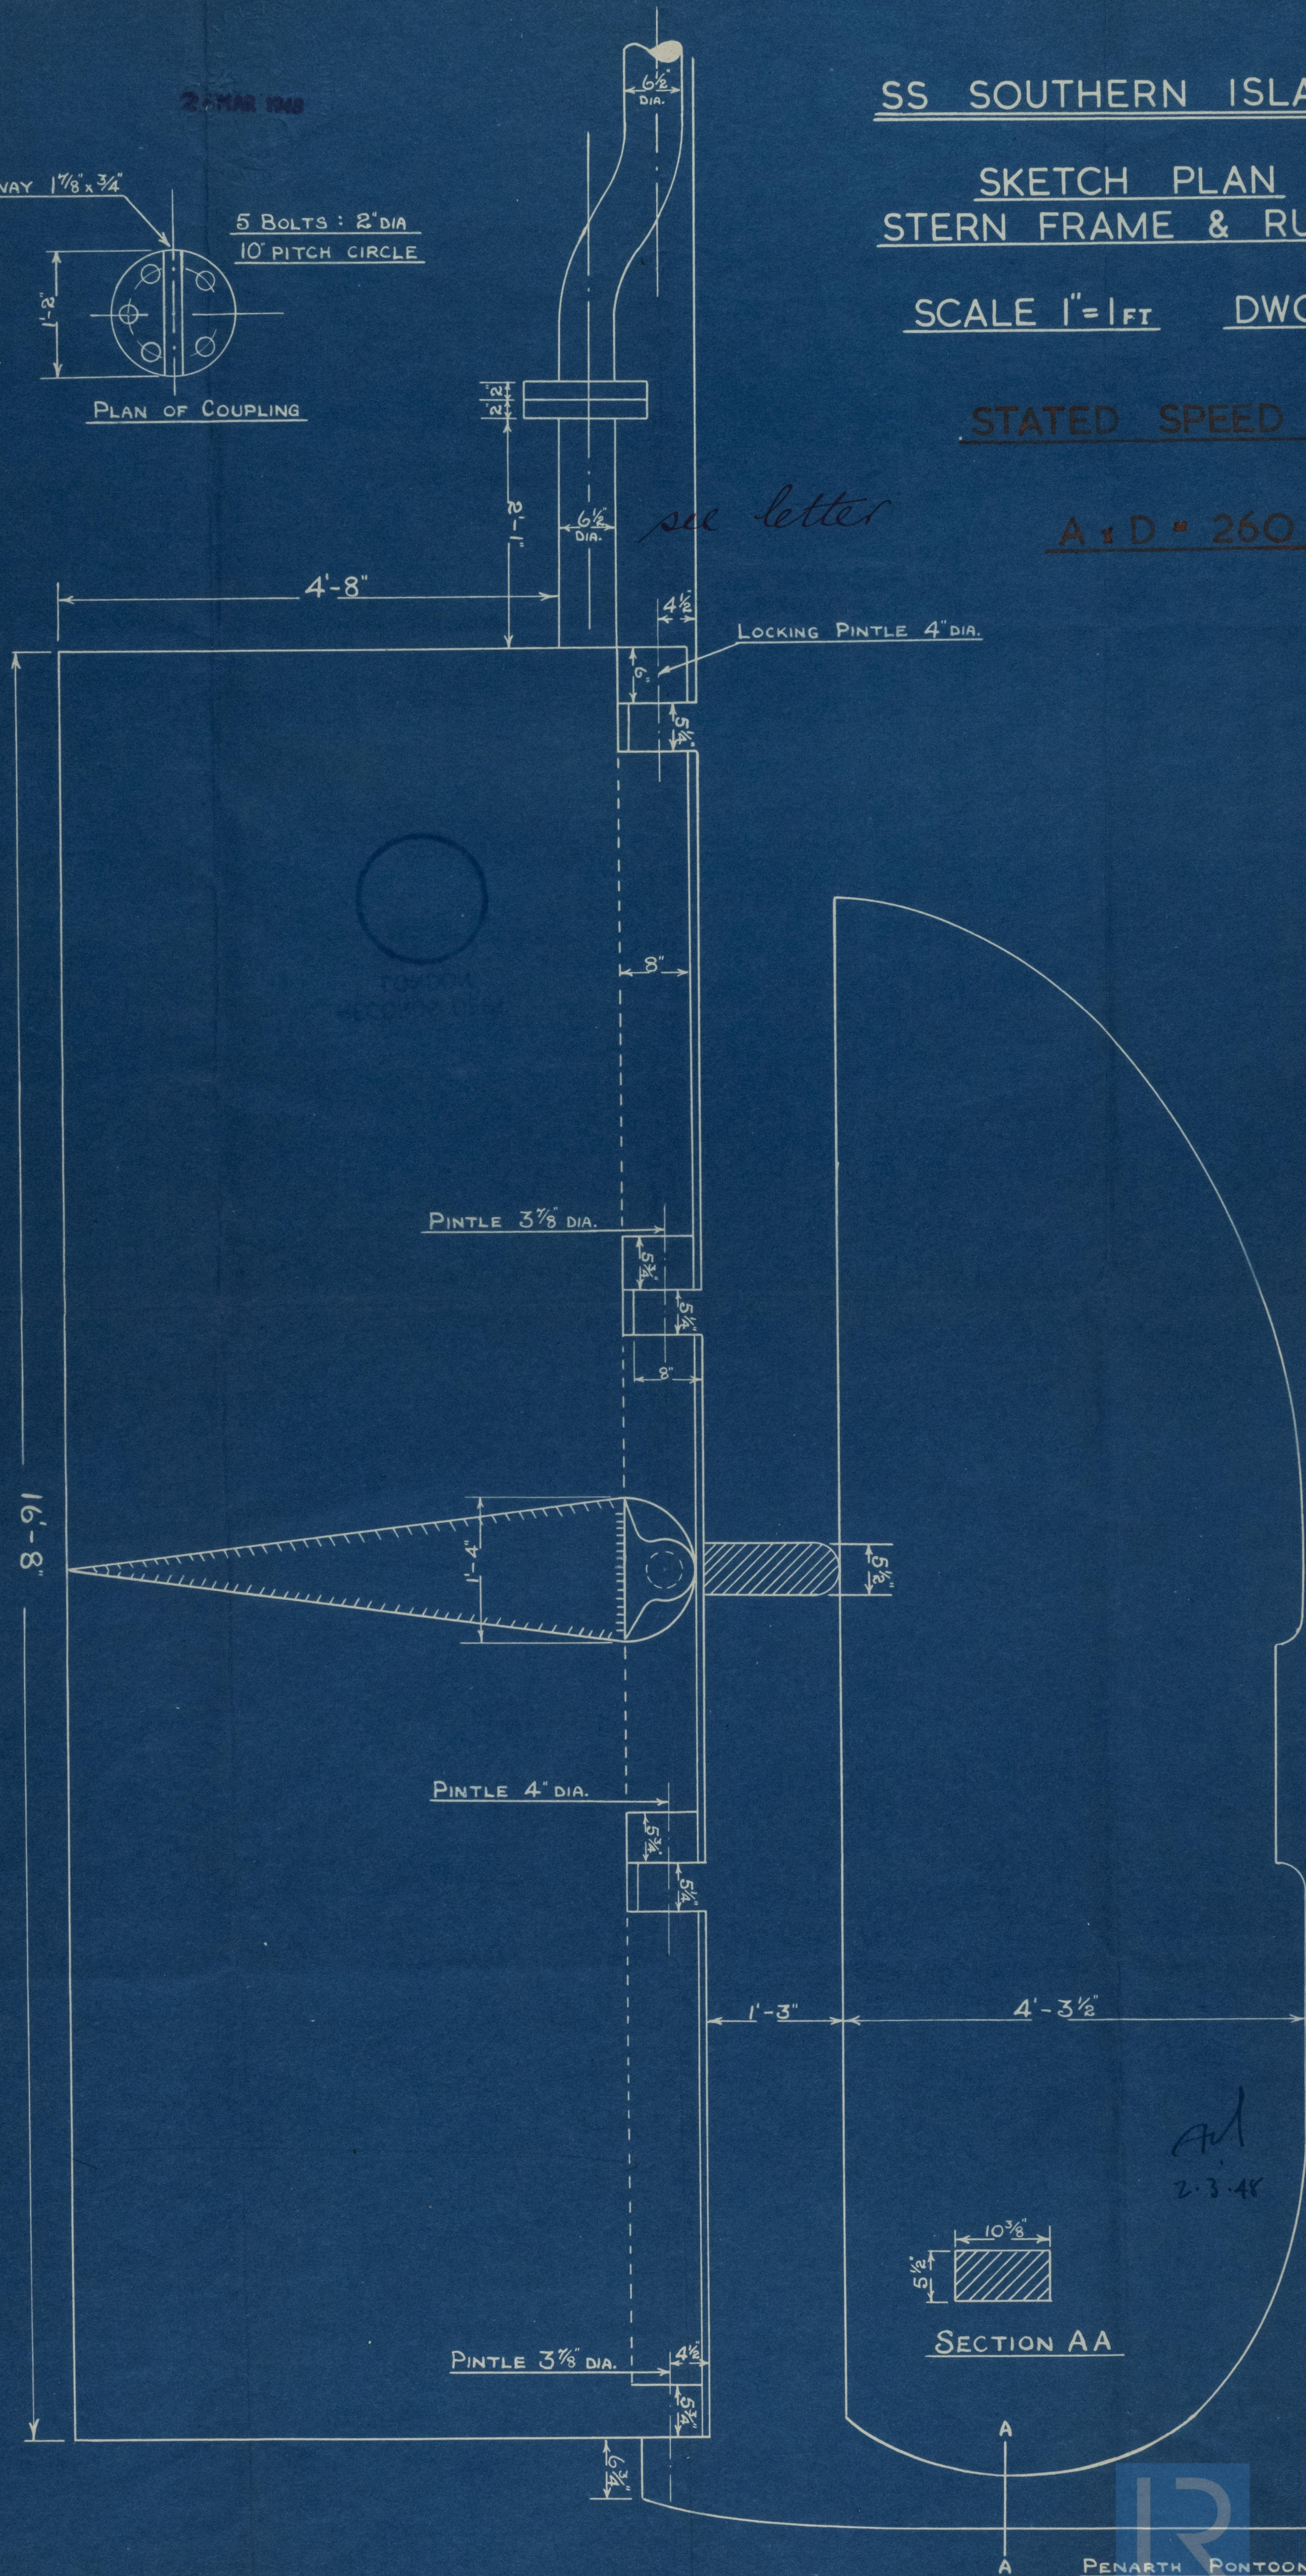


SECTION AA

★ SOUTHERN ISLAND

SKETCH OF RUDDER

AND STERNFRAME

RECORDS DEPT.,
LONDON

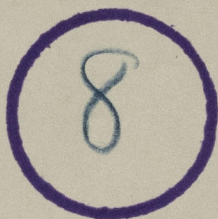

© 2020

Lloyd's Register
Foundation

008964-008972-0045