

# RUDDER & STERNFRAME.

QUADRANT TILLER.

FORGED RON


SCALES 1" & 1 1/2" = 1 FOOT.

## To LLOYDS TESTS & REQUIREMENTS

RIVETS IN RUDDER ARMS 1" DIA - 4 1/2" APART - C.S.K.

STERN FRAME 1" DIA 5" APART

Speed not exceeding  
10 knots

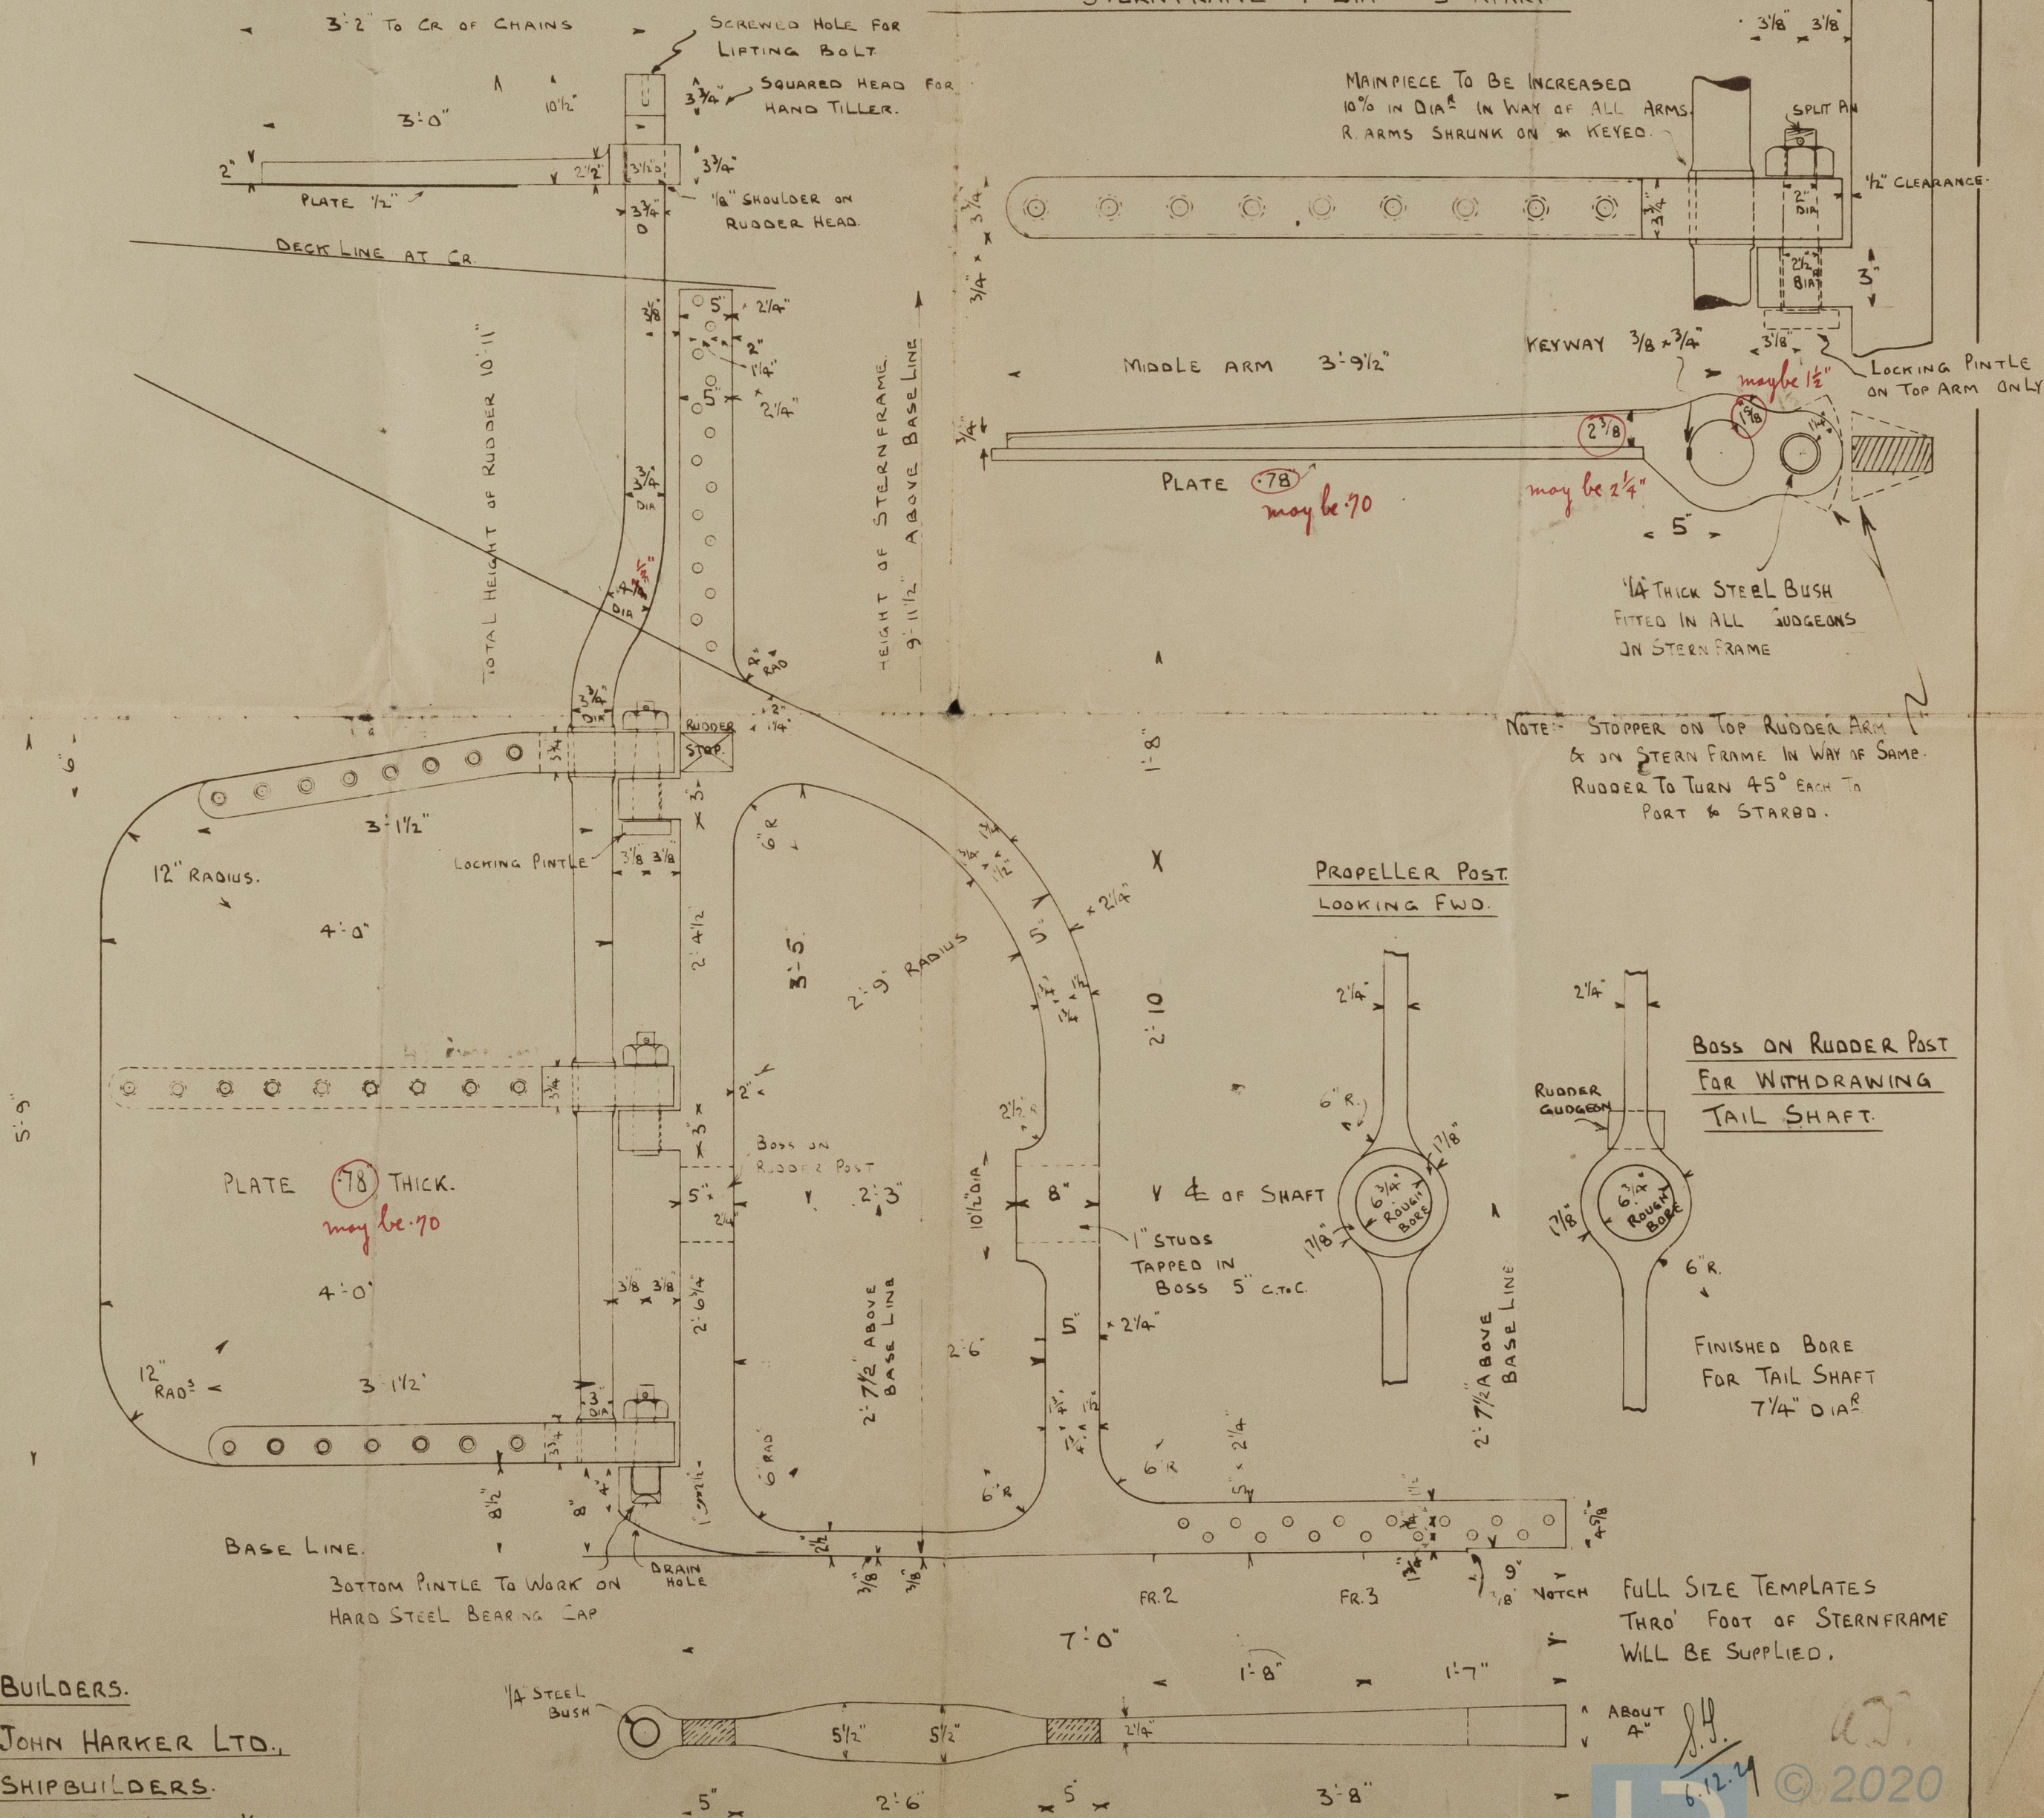

BUILDERS.

JOHN HARKER LTD.

SHIPBUILDERS.

KNOTTINGLEY. YORKS.

FULL SIZE TEMPLATES  
THRO' FOOT OF STERN FRAME  
WILL BE SUPPLIED.

ABOU-  
A"

6.12.2

Lloyd's Register  
Foundation

008964-008972-008



N<sup>o</sup>. 34

Stern Frame & Rudder.

John Starker Es.

S.S. "John Starker"

HULL REPORT No. 41132



© 2020

Lloyd's Register  
Foundation