

Figura N: appross 3080

MIDSHIP SECTION.

Amended Profile + Deck Plan approved 26.2.30

"For boasting Service between"
Worcester Swansea & Bideford
(see letter 19.3.30)

 $5\frac{1}{4}$

2 STOCKLESS ANCHORS EACH ~~4 1/2~~ CWTs.
1 STREAM ANCHOR ~~1 1/2~~ CWTs Ex STOCK
120 FATHOMS ^{1 1/2} " 1/16" STUD LINK CABLE.
45 FATHOMS 2" STEEL WIRE ROPE.
75 " 6 ^{3/4} " HAWSER.
90 " 4 ^{1/2} " WARP.

OIL CARRYING MOTOR TANKER FOR
COASTAL SERVICE TO LLOYDS 100 A.I. + (CARRYING PETROLEUM IN BULK)


DIMENSIONS 105'-0" B.P. x 20'-0" MLD x 8'-0" MLD.

SCALE $\frac{3}{4}" = 1 \text{ FOOT.}$

Special notation: - middle line Bulthead non oiltight.

RIVETING.
 THRO' FRAMES & SHELL EXCEPT OIL COMP^{TS} C TO C.
 & PAINTING FRAMES. 7 DIAS
 " BEAMS & DECK " 7 "
 " FRAMES & SHELL IN OIL COMPARTMENTS. 6 "
 " BEAMS & DECK " " " 6 "
 " FRAMES & FLOORS. 7 "
 " -DO- FWD 1/2 LENGTH. 5 1/2 "
 - FRAMES & BEAMS & O.T. BHDS. ^{BHD OF} SHELL FLANGE 5 DIAS. 2 ROWS
 " DO DO & WT BHDS -DO- 5 " 1 Row.

END LAPS OF KEEL SHELL & DECK } 3 1/2 DIAS C TO C.
 STRINGER. END LAPS OF DECK } IN WAY OF OIL COMP^S.
 DO CLEAR OF OIL COMP^S 4 DIAS ^{ho 3 1/2}

PLATING OF TRANSVERSE BHDS. OIL. 3/4 DIAS WT. 4 DIAS
 " " EXPANSION TRUNK SIDES & TOP 3 1/2 DIAS.

KEEL & DECK STRINGER ANGLES }
 EXPANSION TRUNK CONNECTIONS } 5 DIAS. ^{ca 10}
 MIDDLE LINE BULKHEAD SEAMS & BUTTS }
 SEAMS OF SHELL ALL FORE & AFT. } 3 1/2 DIAS.
 FACE BARS & STIFFENERS GENERALLY.
 IN OIL COMPARTMENTS. 6 DIAS.
 OTHERWISE 7 "

5/8" DIA RIVETS THROUGHOUT EXCEPT.
IN KEEL PLATES WHERE 3/4" DIA RIVETS ARE.
TO BE FITTED IN BUTTS WHERE THICKNESS.
EXCEEDS .36

BUTTS OF SHELL PLATING. D.R. THROUGHOUT.
 " " KELL " ~~D.R. 7/8 DIA OR~~
 TREBLE RIVETED 3/4 DIA FOR 3/5 THS. LENGTH
 BUTTS OF DECK STRINGER D.R. 7/8 THROUGHOUT
 SEAMS. " " " IN WAY OF
 OIL SPACES.

BUILDERS.


JOHN. HARKER LTD.
KNOTTINGLEY.
YORKS.

C OUT
30"-26"

J. J.
 6.12.29

27.3.30

© 2020
Lloyd's Register
Foundation

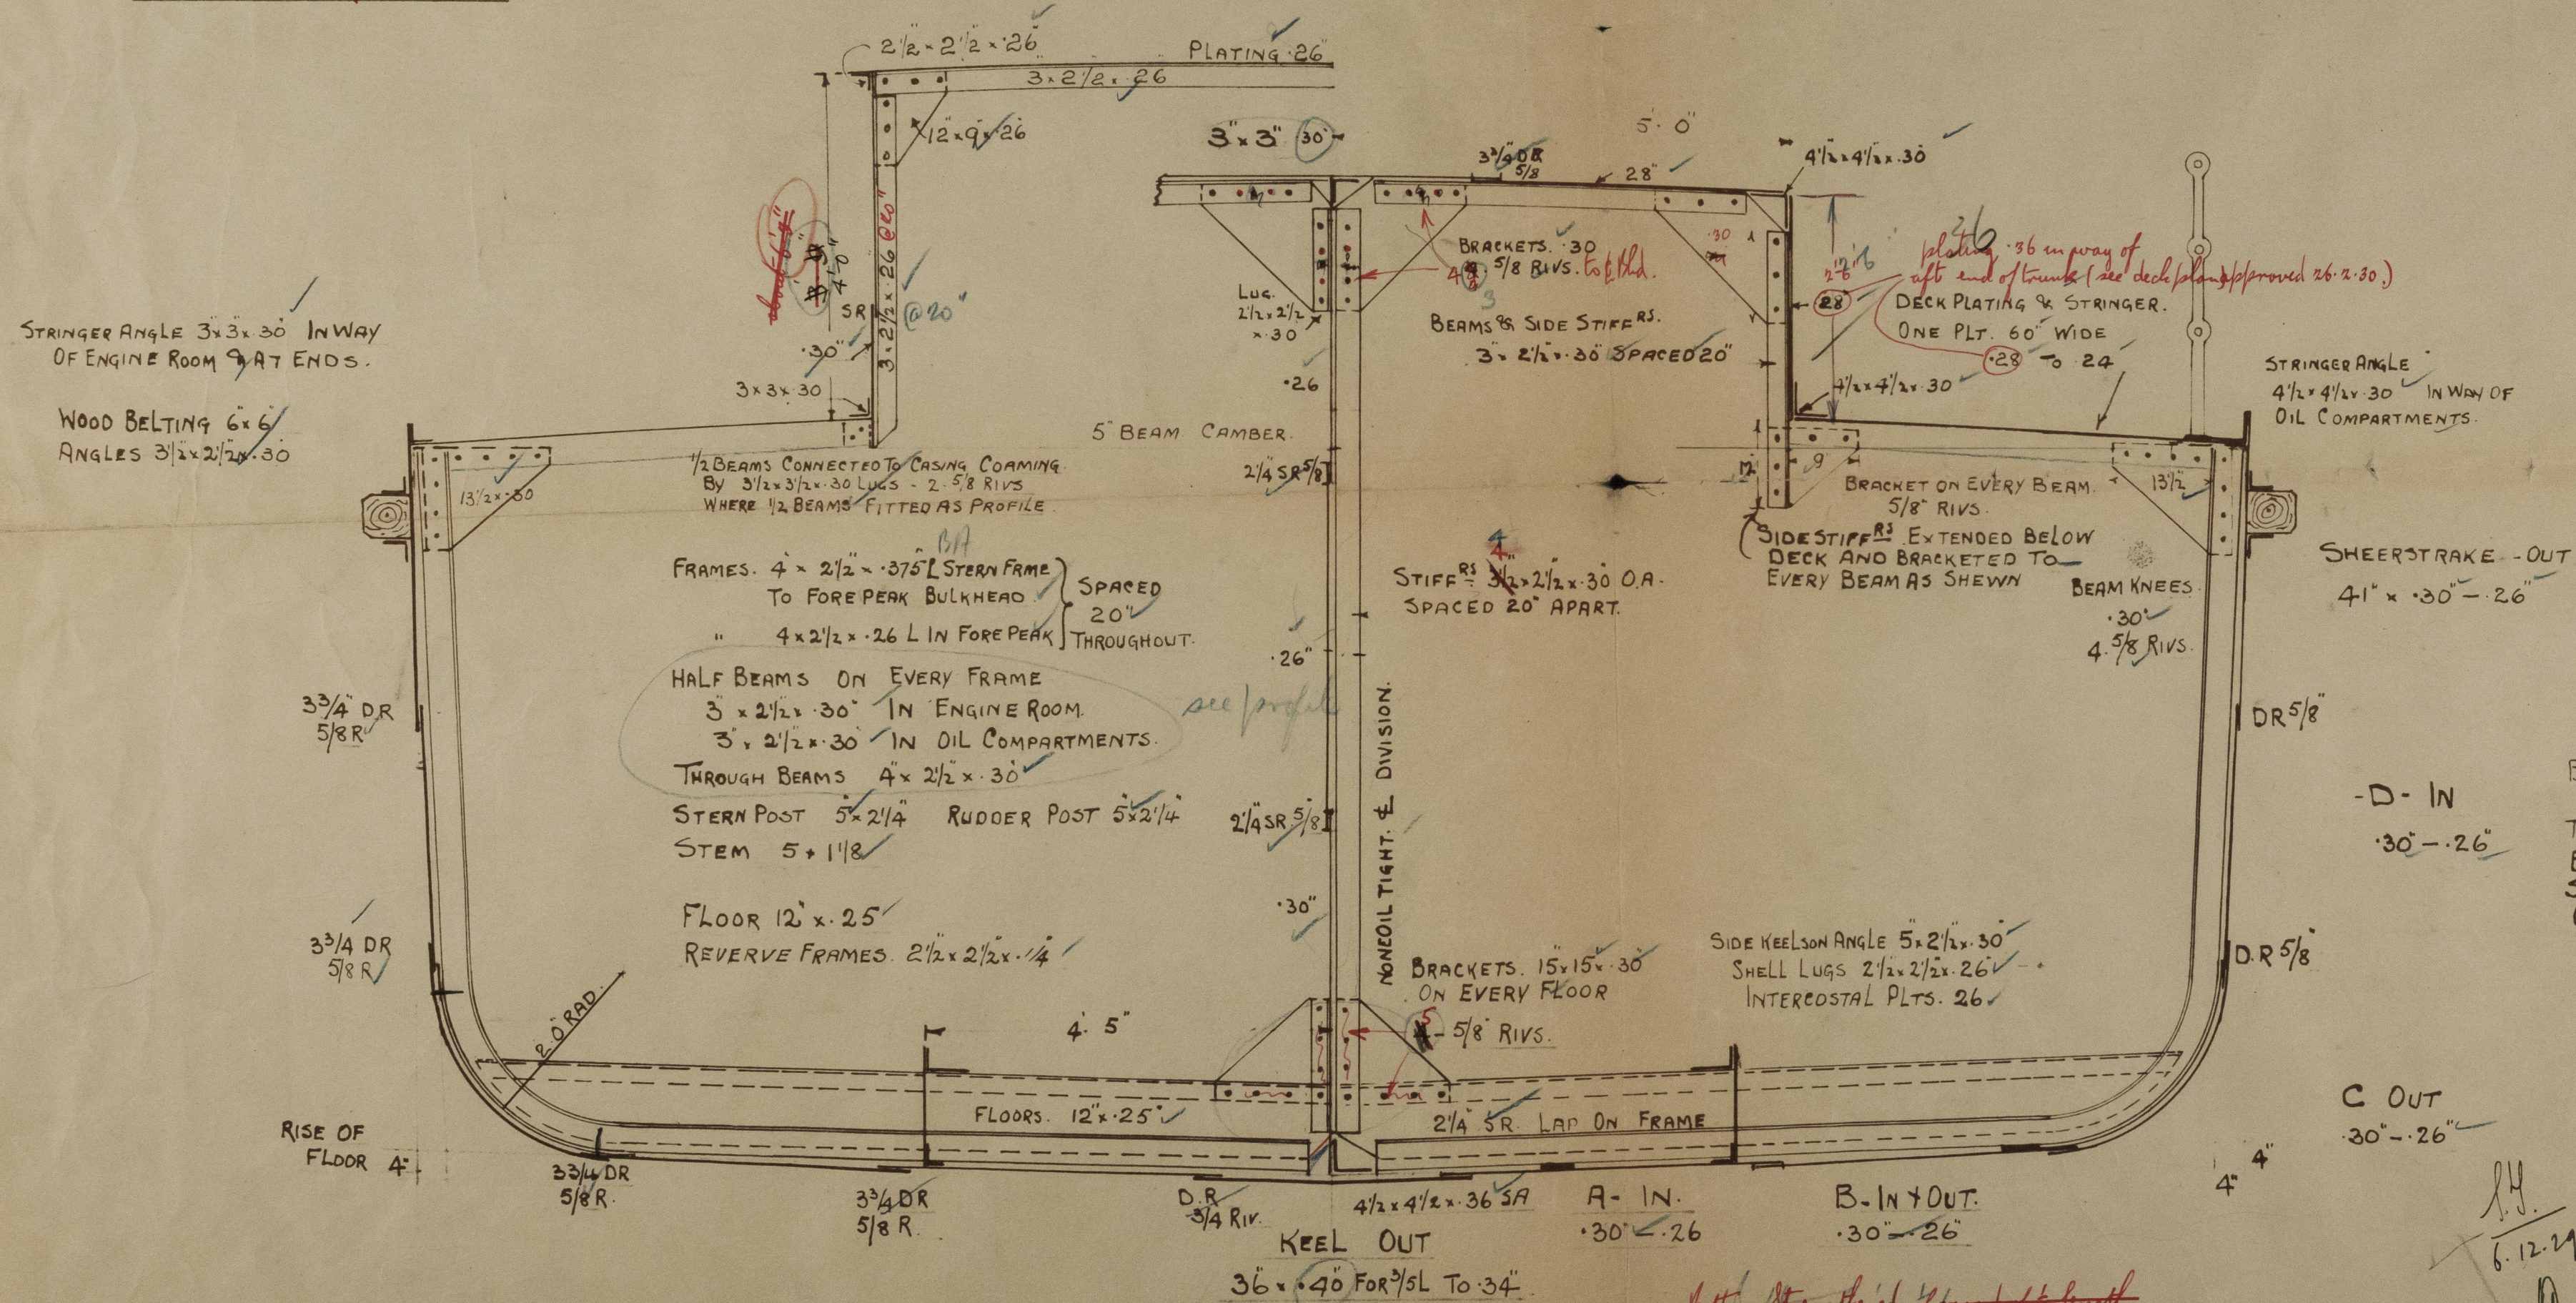

Bottom strengthened forward of $\frac{1}{2}$ length
as per rule.

36 -

Midship Section

John Barker Ltd

OS^o 34

BOX NO 173

"John Barker"

008964-008972-0087



© 2020

Lloyd's Register
Foundation