


SHIP NO 573. LONGITUDINAL PLAN.

DIMENSIONS - 110'-0" B.P. x 34'-0" B.M.P. x 12'-7" D.M.P.

SCALE $\frac{1}{4}" = 1 \text{ FOOT}$

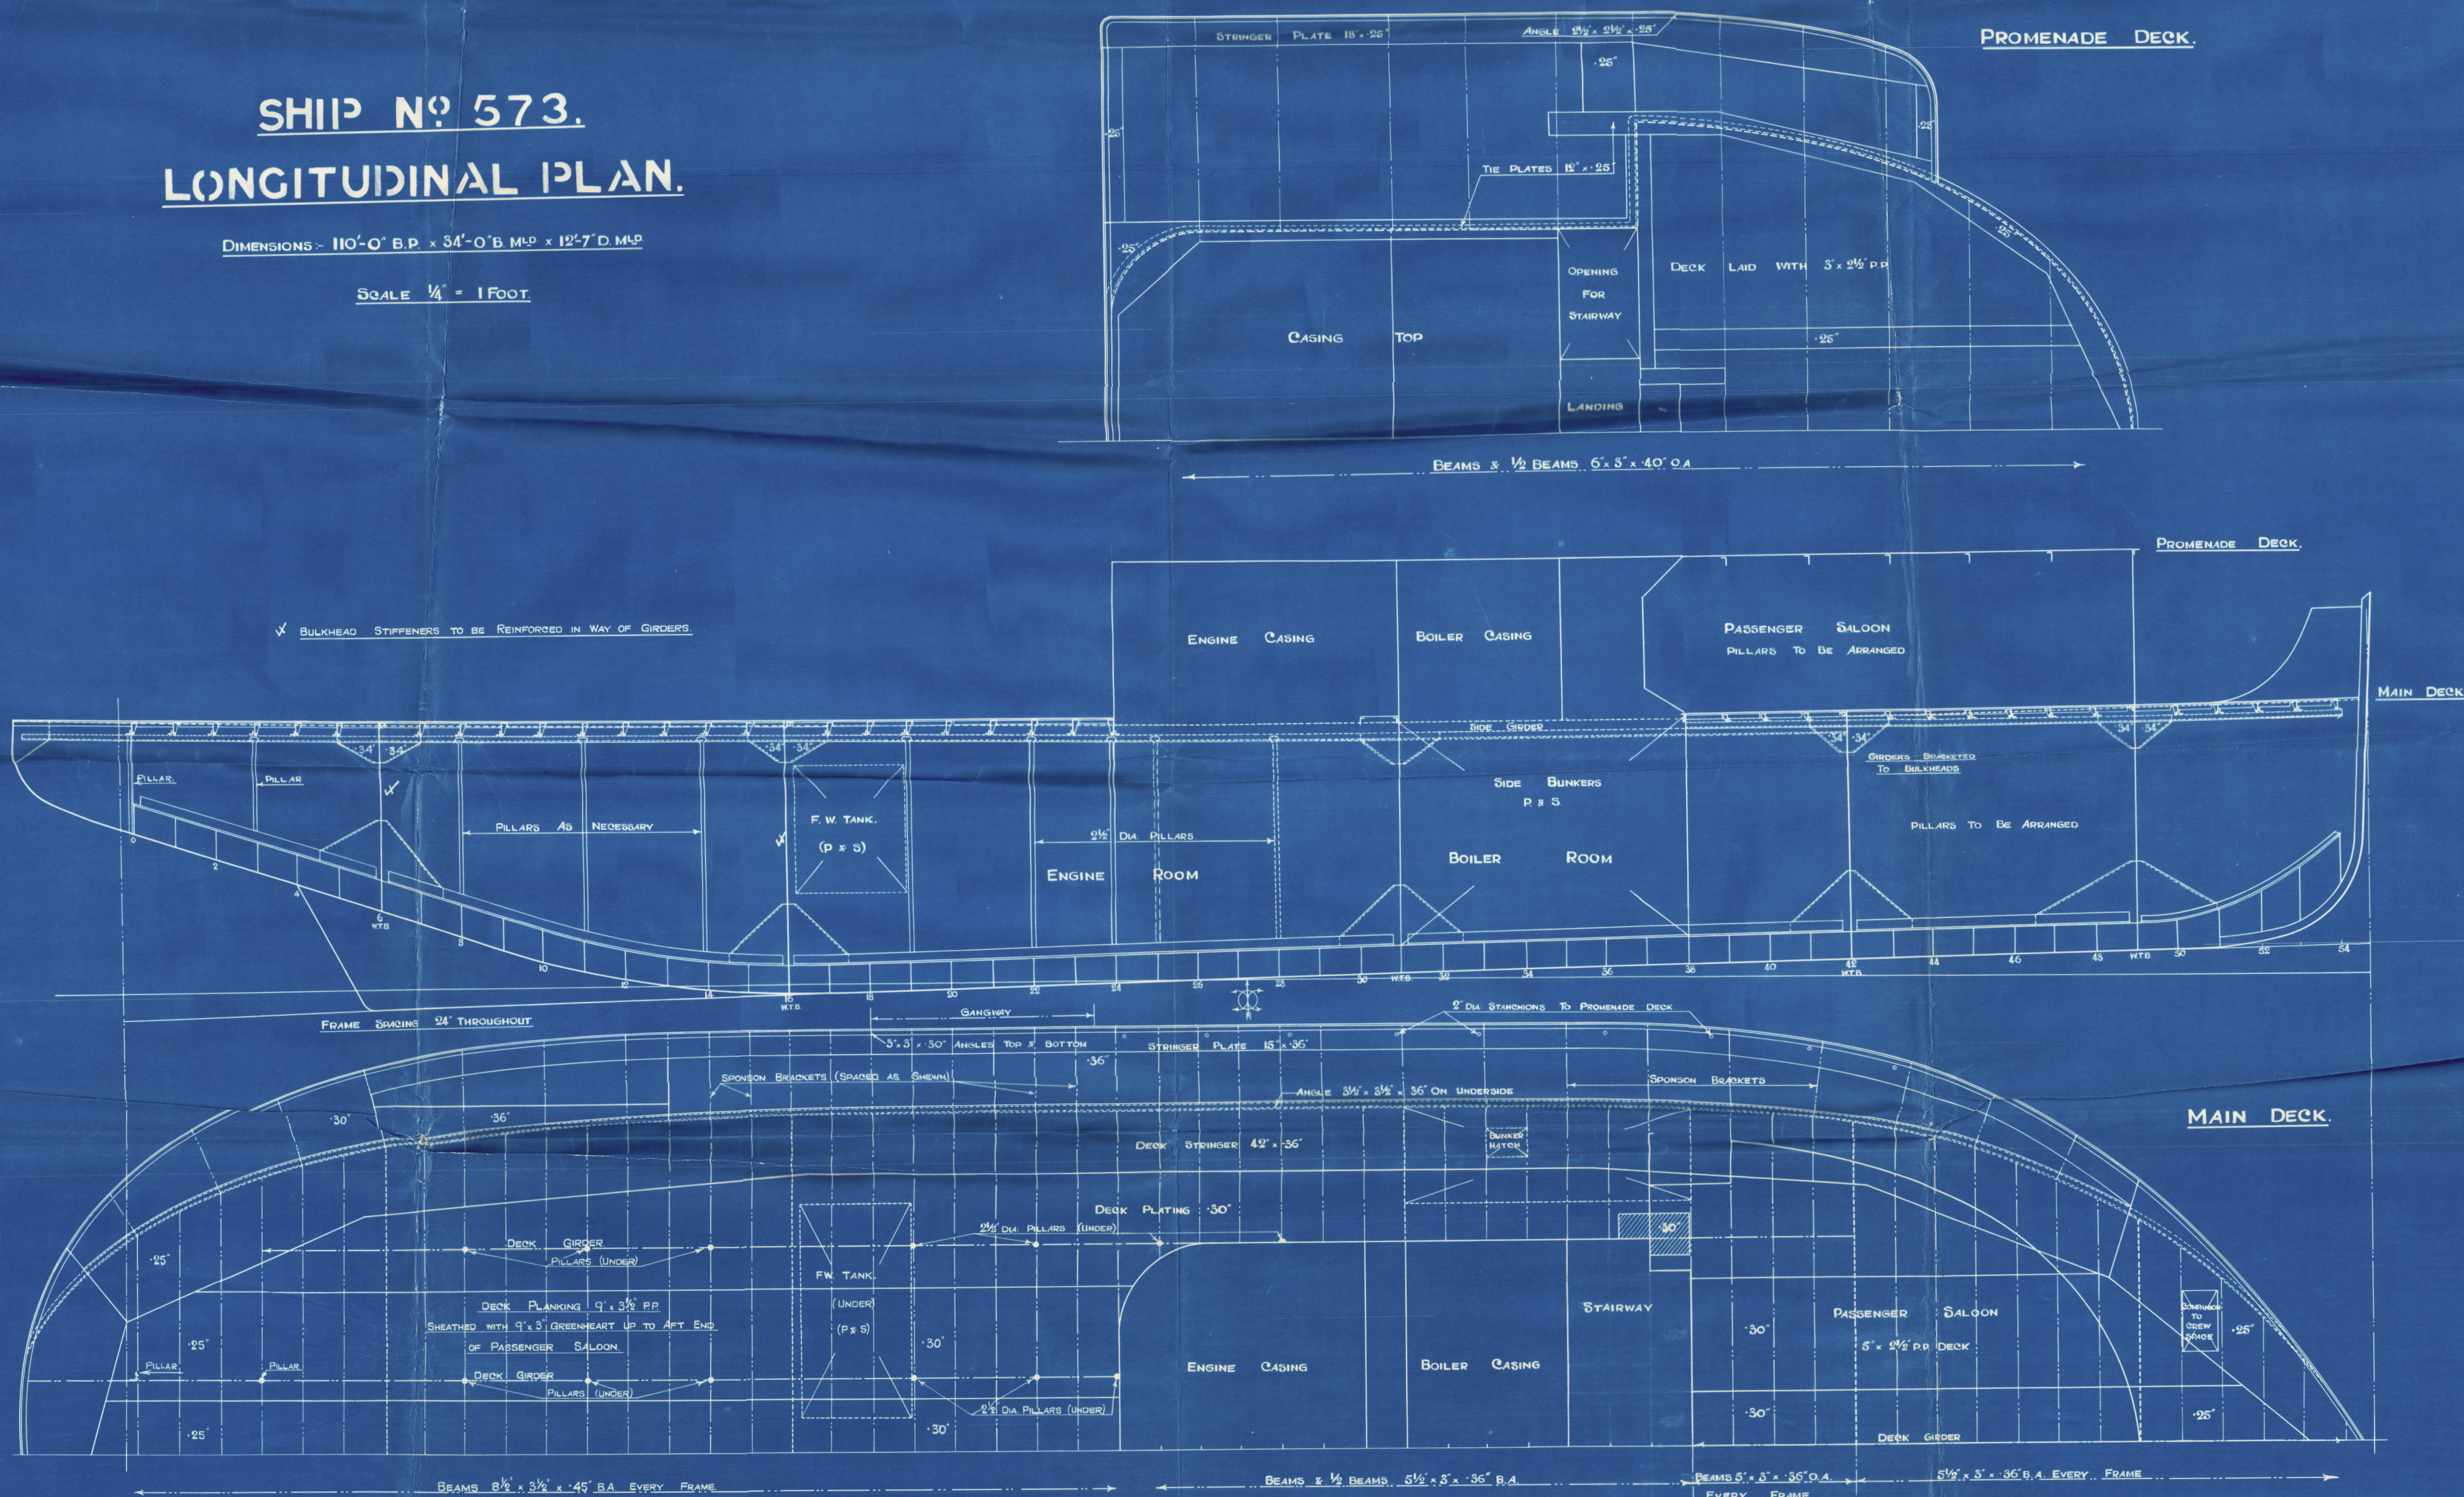

W.P.
4265
5 NOV 1929
7.11.29
LLOYD'S REGISTER
LONDON - GENEVA - ANTWERP - BRISTOL - LIVERPOOL - NEWCASTLE - ON - TYNE

ENCLOSURE TO

LLOYDS.

34/02742.

FROM R. & W. HAWTHORN, LESLIE & CO. LTD.,
HEBBURN-ON-TYNE.

008964-008972-0164 1/2

Hawthorn Beebe's 5/15.
Longitudinal Plan

4.

543

Amended Paper & duck

S/S. "NORTHUMBRIAN"

NEWCASTLE ON TYNE.

Report No. 85624.



© 2020
008964-008972-0164

Lloyd's Register
Foundation