

M. S. N^o 642

SCALE $\frac{1}{4}'' = 1'-0''$ $\frac{1}{2}'' = 1'-0''$

CLASS. LLOYDS REGISTER +. 100. A.I.



EQUIPMENT NUMBER.	
L x [B + D]	4882 4885
FORECASTLE 0.75 x 14.50 x 6.50 =	64 111
POOP DECK 11.72 x 33.0 x 7 =	231 24
CASING 0.50 x 13 x 3.75 =	24 26
	5206 5213 (Letter 2, not exceeding) 5200

PRINCIPAL DIMENSIONS

LENGTH BETWEEN P.P.	137.0'
LENGTH OVERALL	144.0'
RULE LENGTH .96 x 144	138.24
BREADTH MOULDED	24.2'
DEPTH TO UPPER DECK	11.2'
HEIGHT OF FORECASTLE ABOVE UPPER DECK	6.6'
HEIGHT OF POOP DECK ABOVE UPPER DECK	7.0'

LLOYDS NUMERALS

L x D = 138.24 x 11.16	1542.144
D = 11.16	11.16
B = 138.24 x 11.16	12.38
d = 11.16 - 2.41	8.75

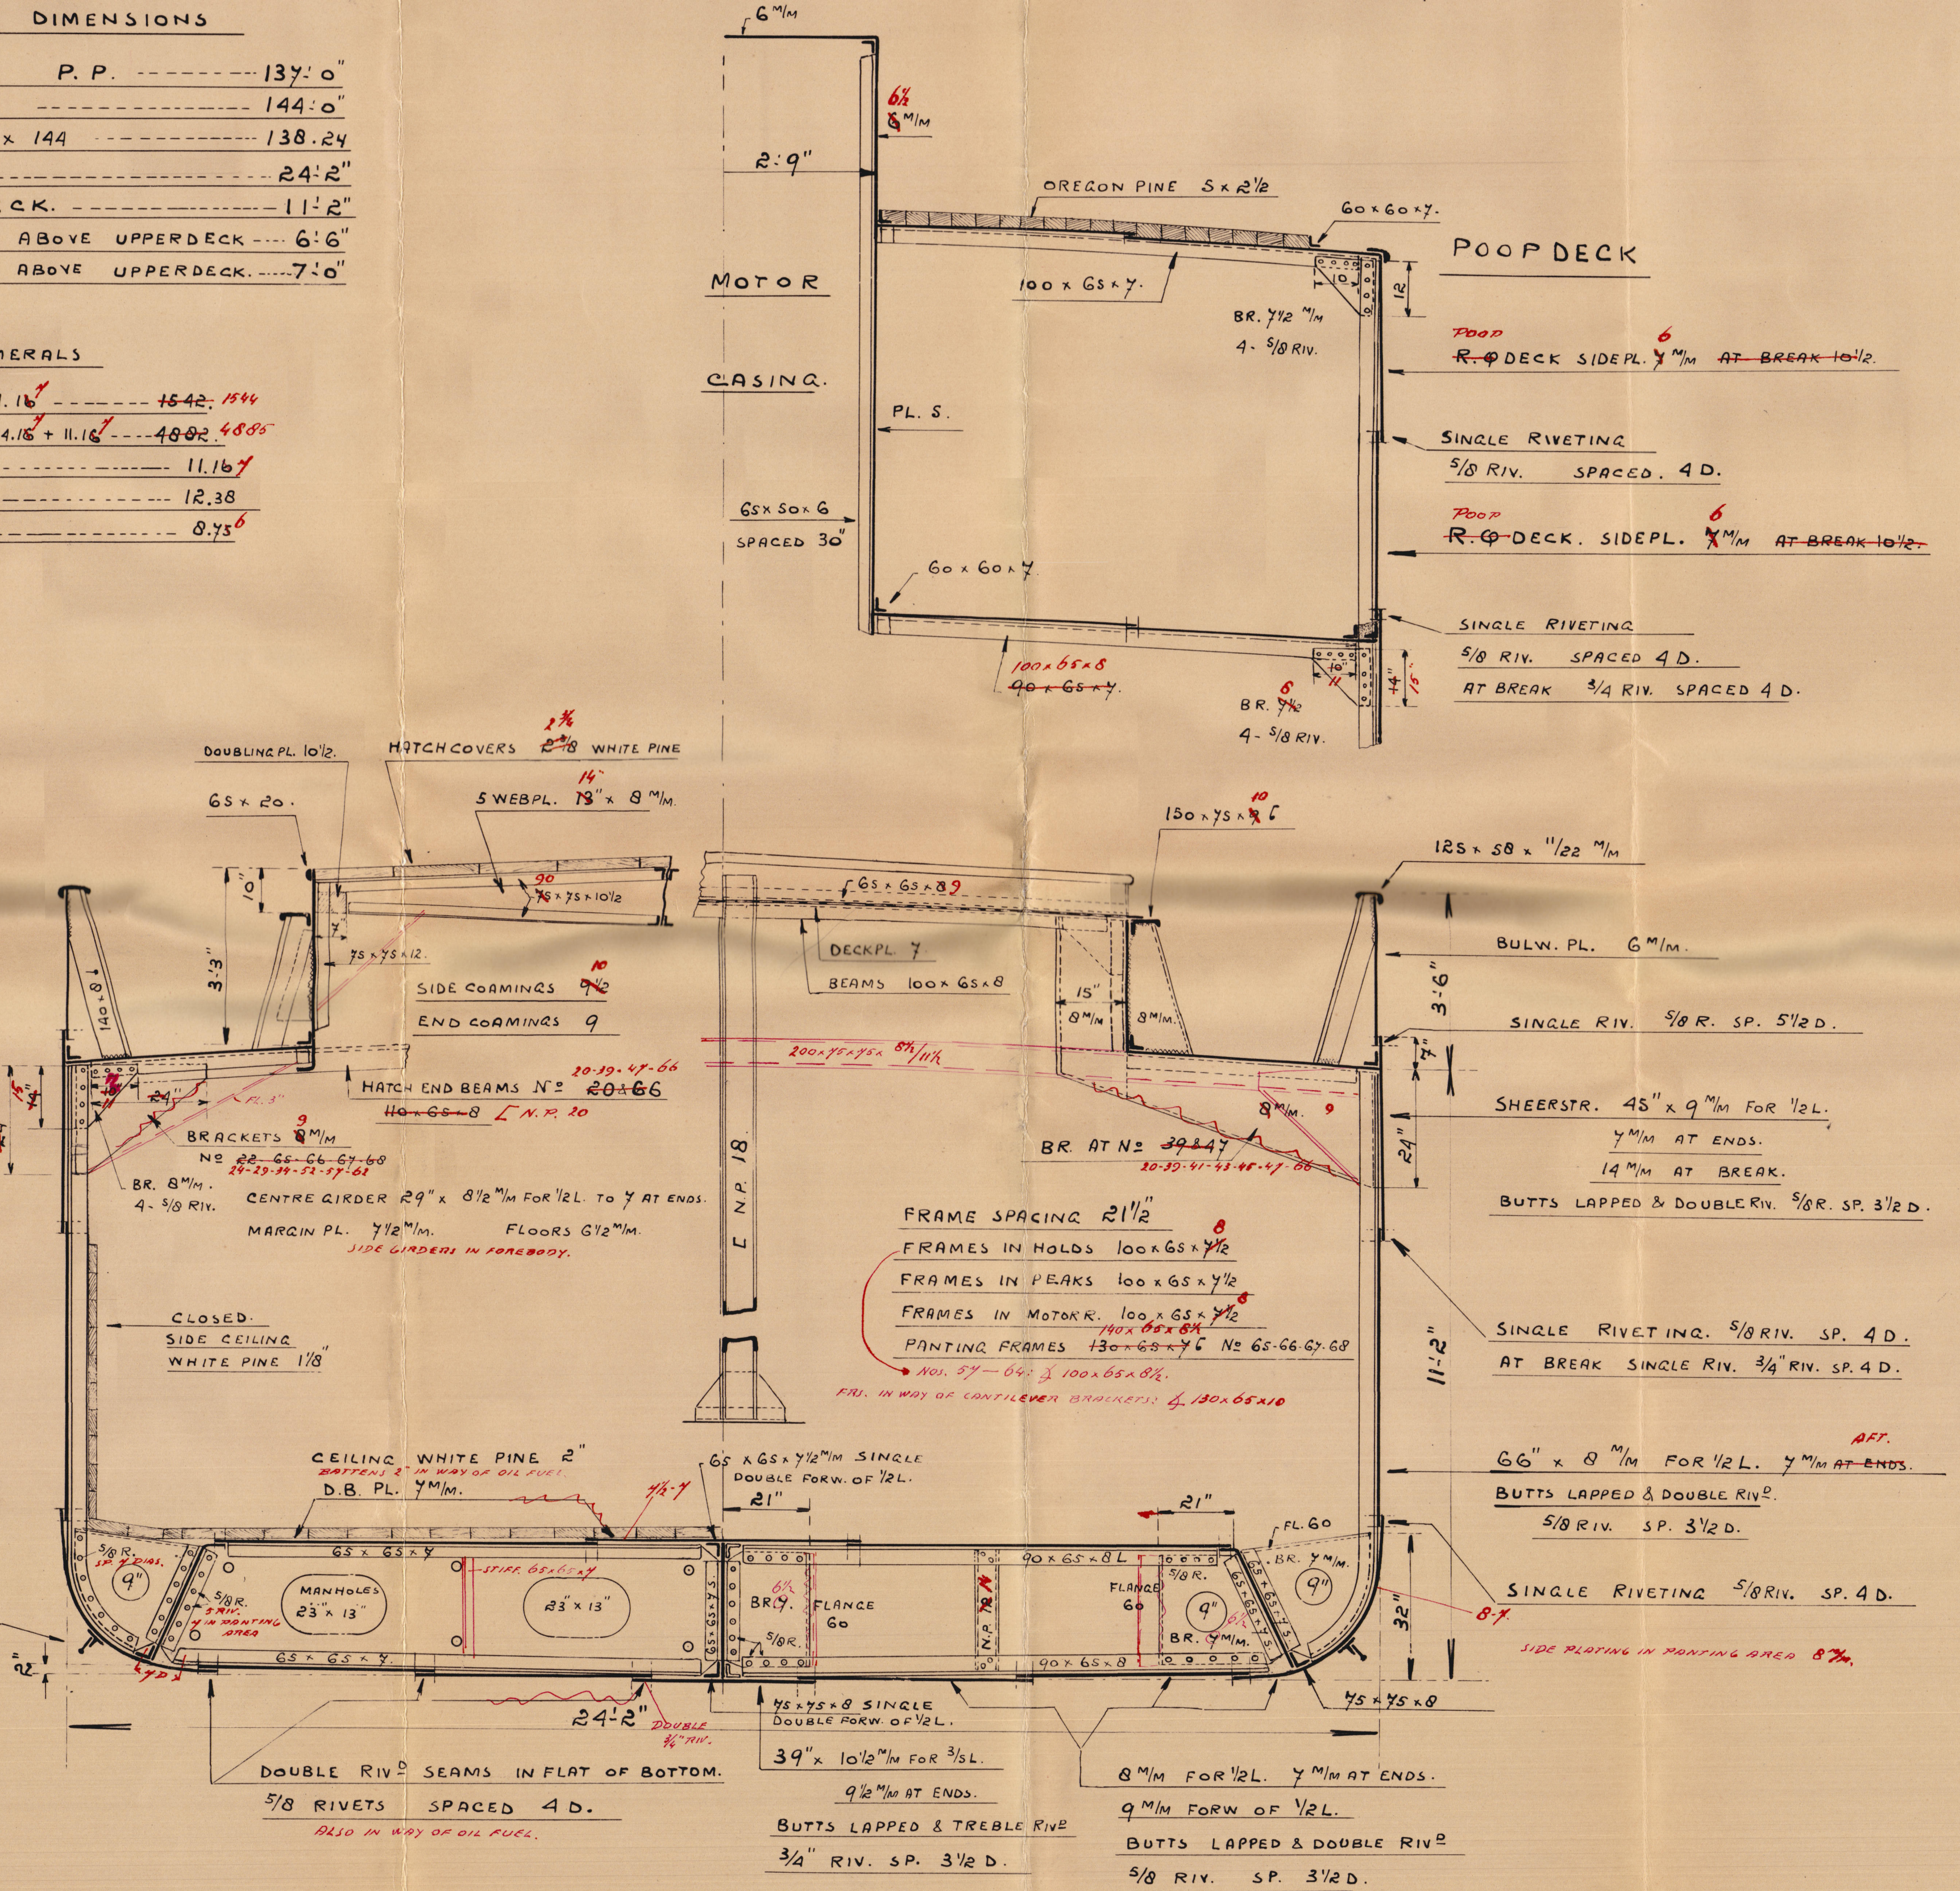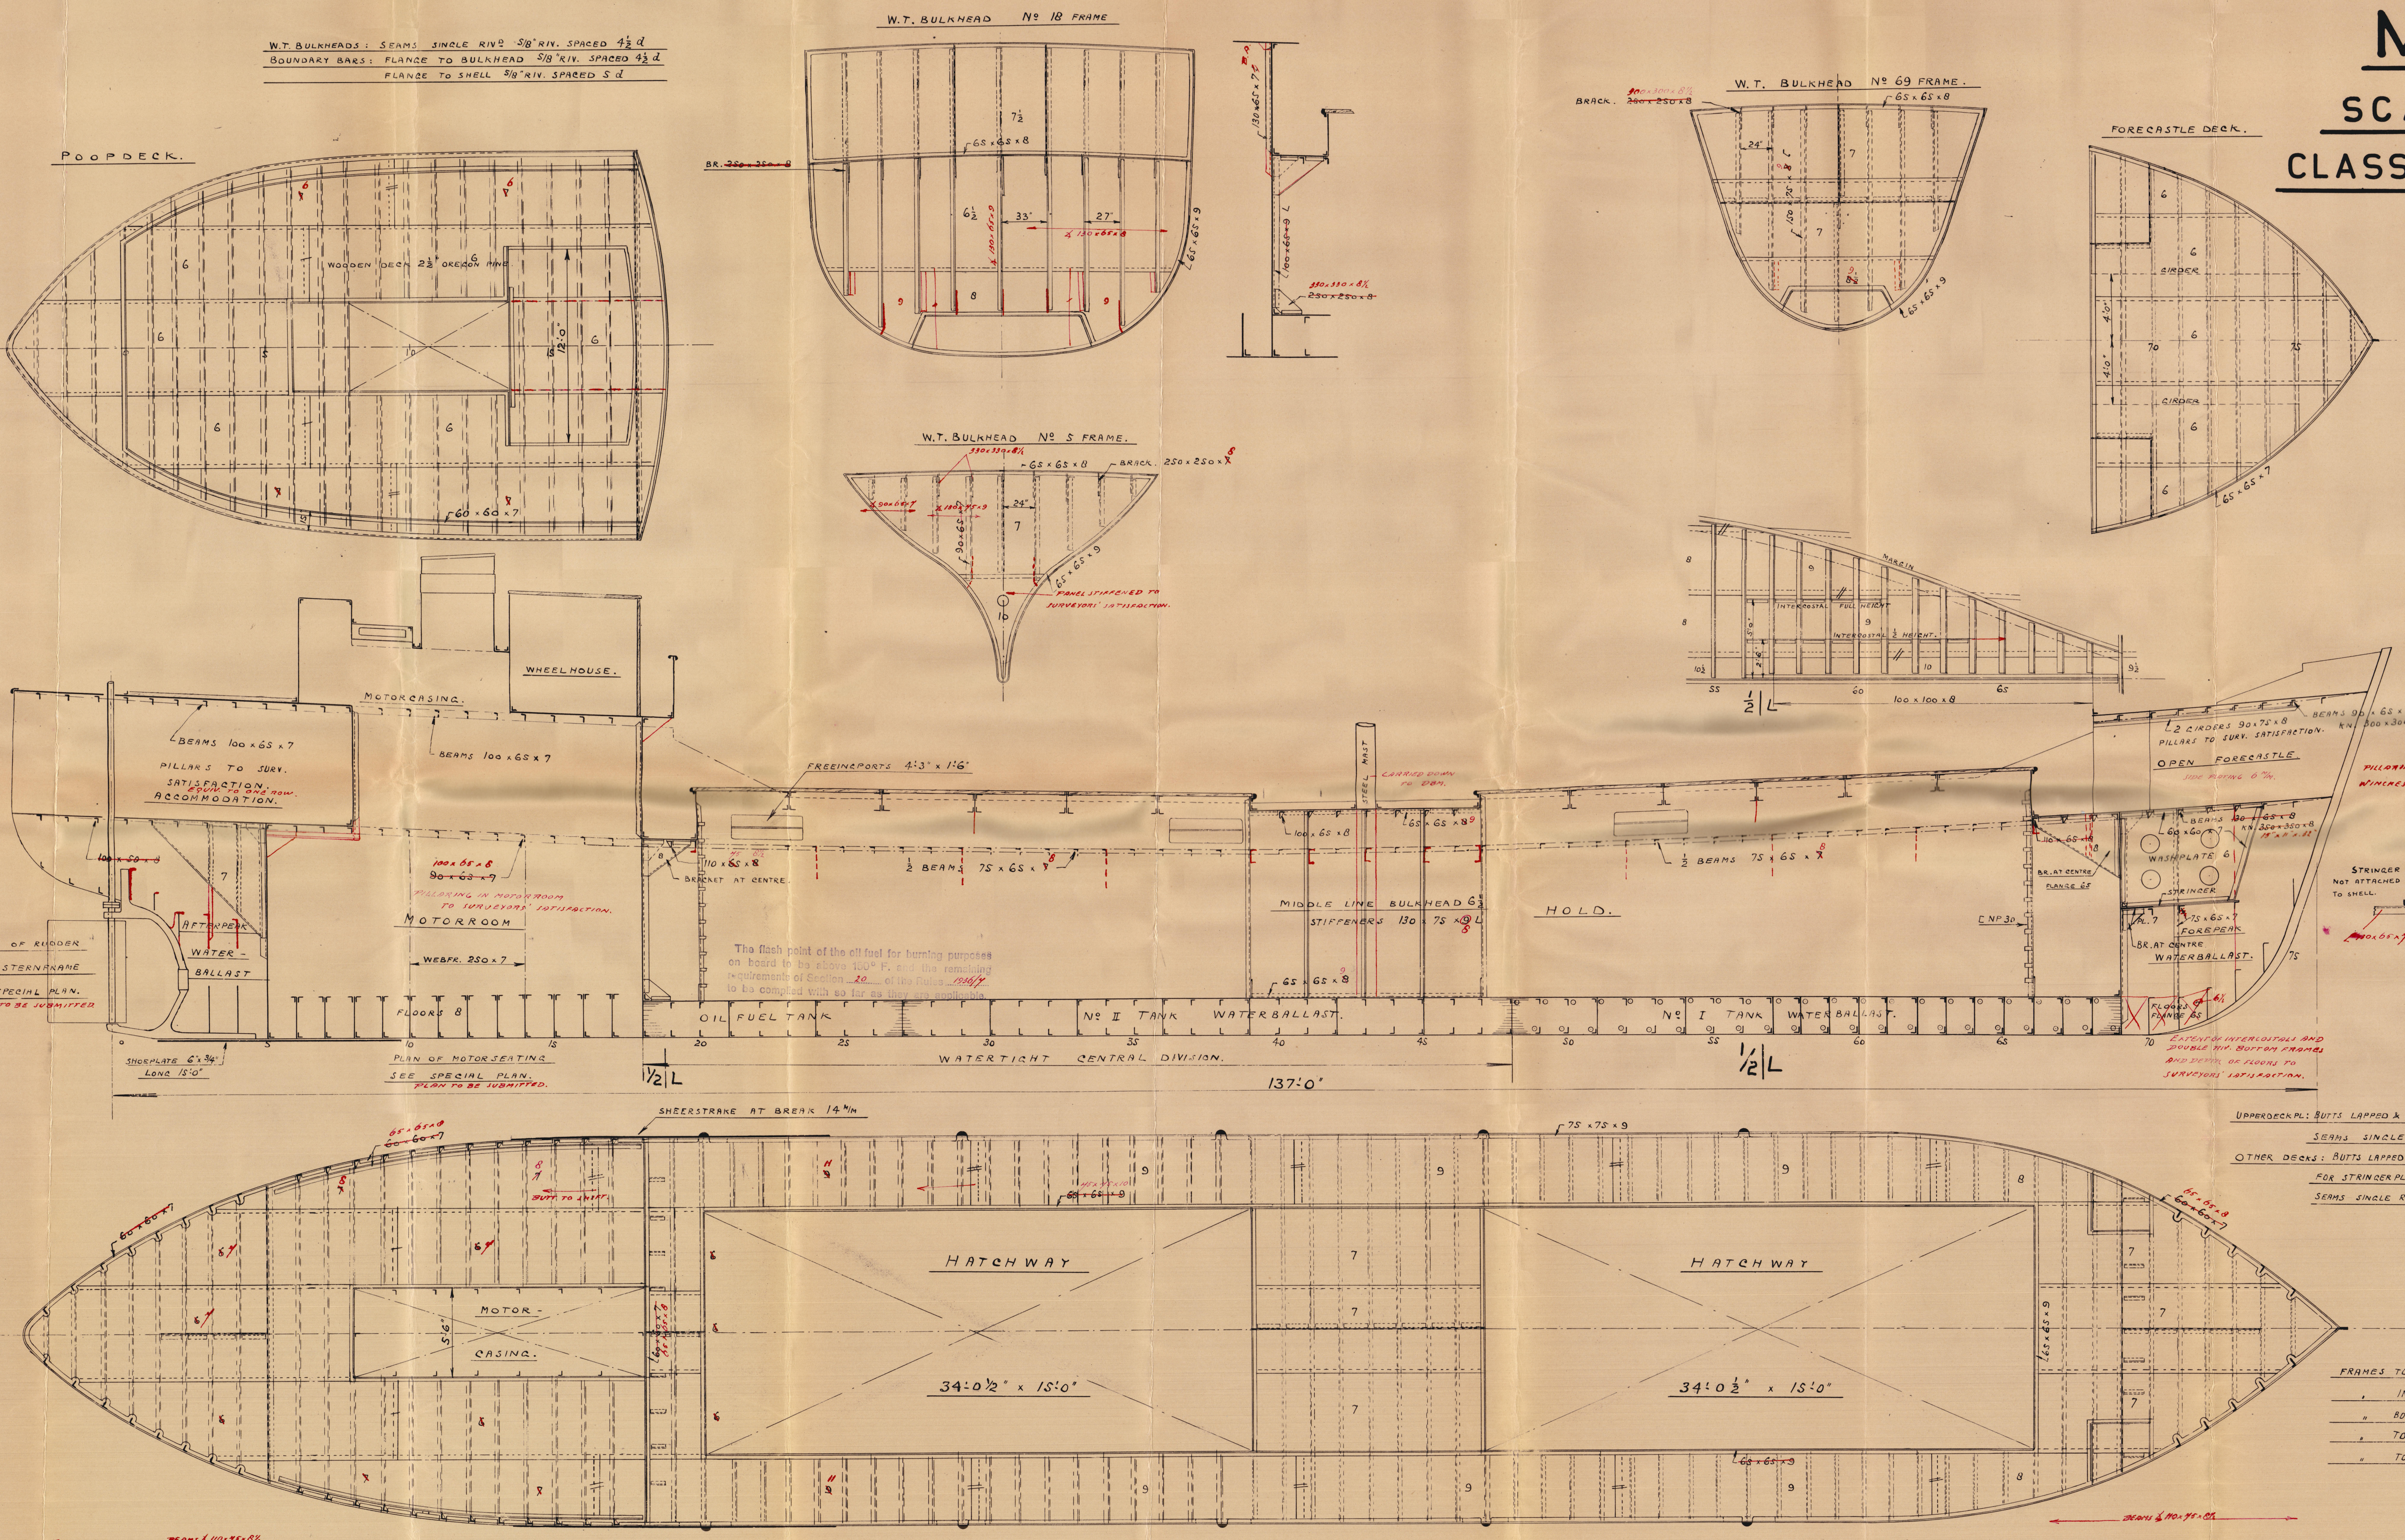

A VUYK & SONS
SHIPBUILDERS
CAPELLE A.D. YSSEL HOLLAND

1816

~~12a~~

①

A. VUYK & ZONEN.

642.


MIDSHIP SECTION,

PROFILE & DECKS,

BULKHEADS,

BOTTOM FORM^D.

"KERLOGUE"

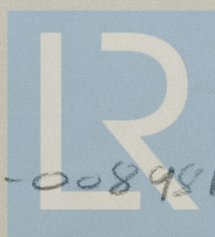

© 2021

Lloyd's Register
Foundation

008973-008981-0001