

M. 5. N° 642

WROUGHT STEEL RUDDER AND STERNFRAME

SCALE 1" = 1'-0" & 1 1/2" = 1'-0"

CLASS LLOYDS REGISTER

+ 100 A. 1




SPEED 10 KNOTS

A.D. 38.36

STEERING CAPINS 5/8" DIA.
RODS 1 1/2"

SURITY BAND WITH BRASS BUSH
IN TWO PIECES

SECOND MEANS OF STEERING AND BRAKE
TO SURVEYORS SATISFACTION
STEERING CHAIN & RODS TO RULE

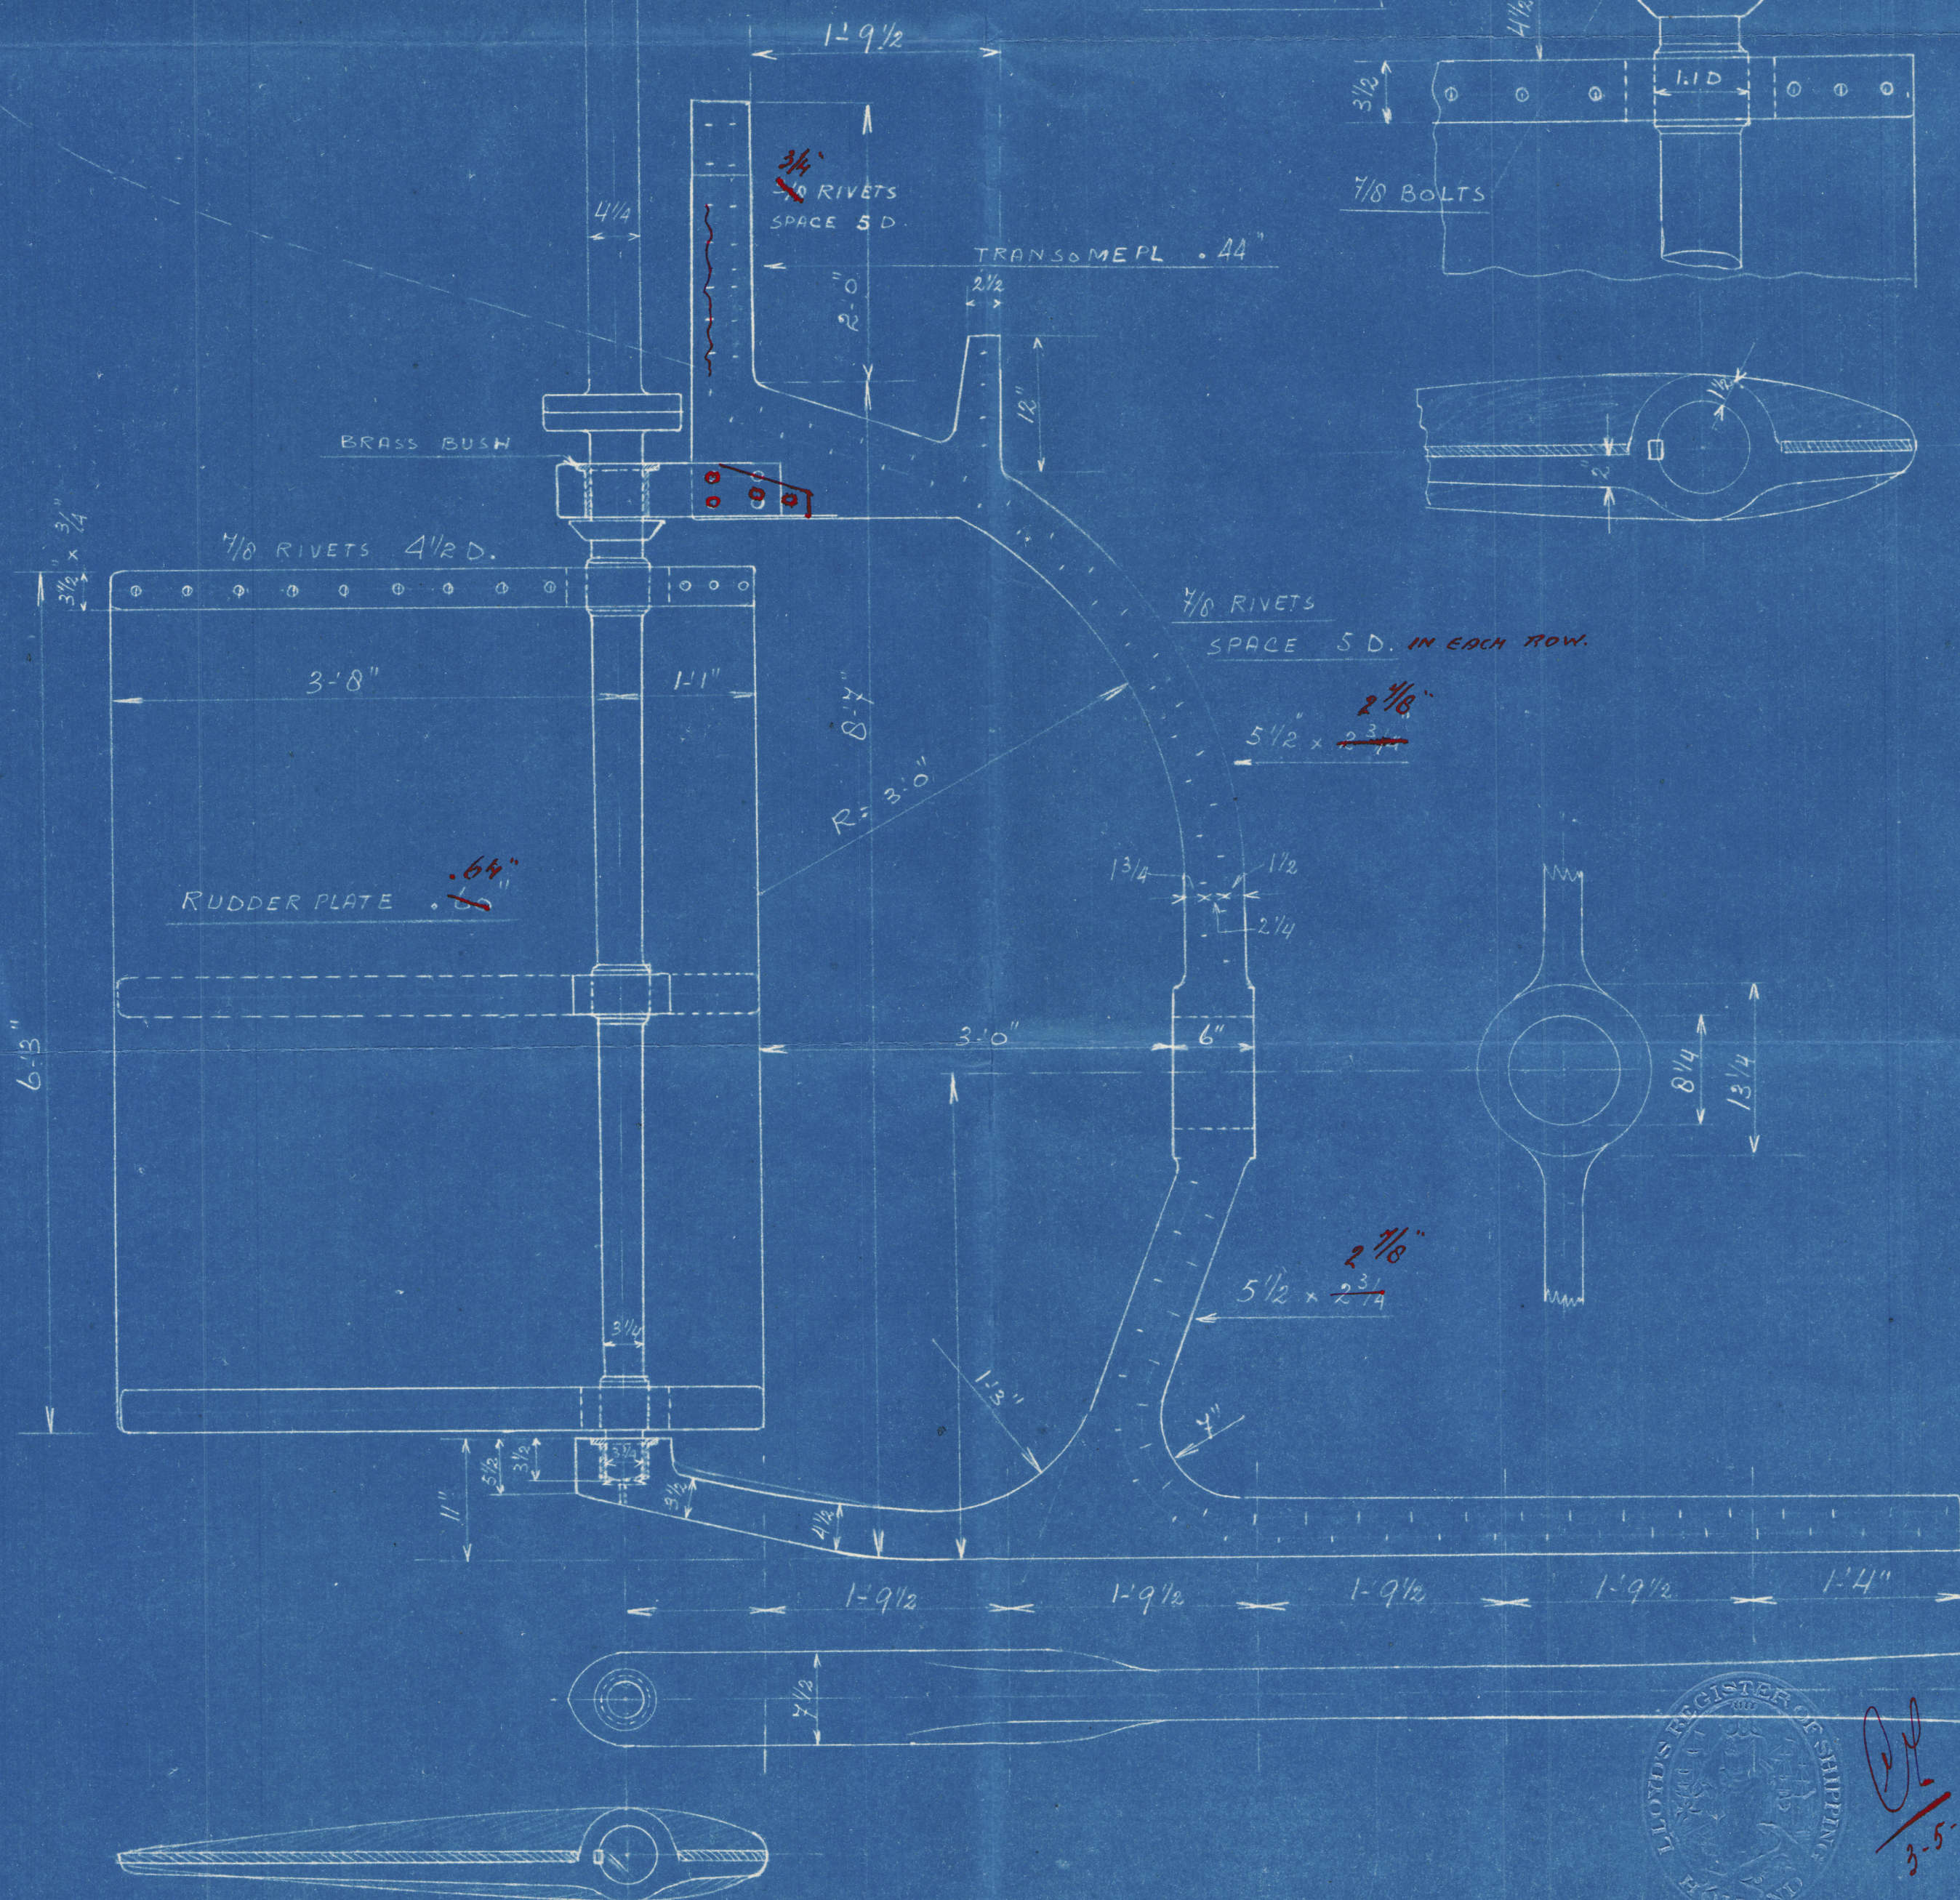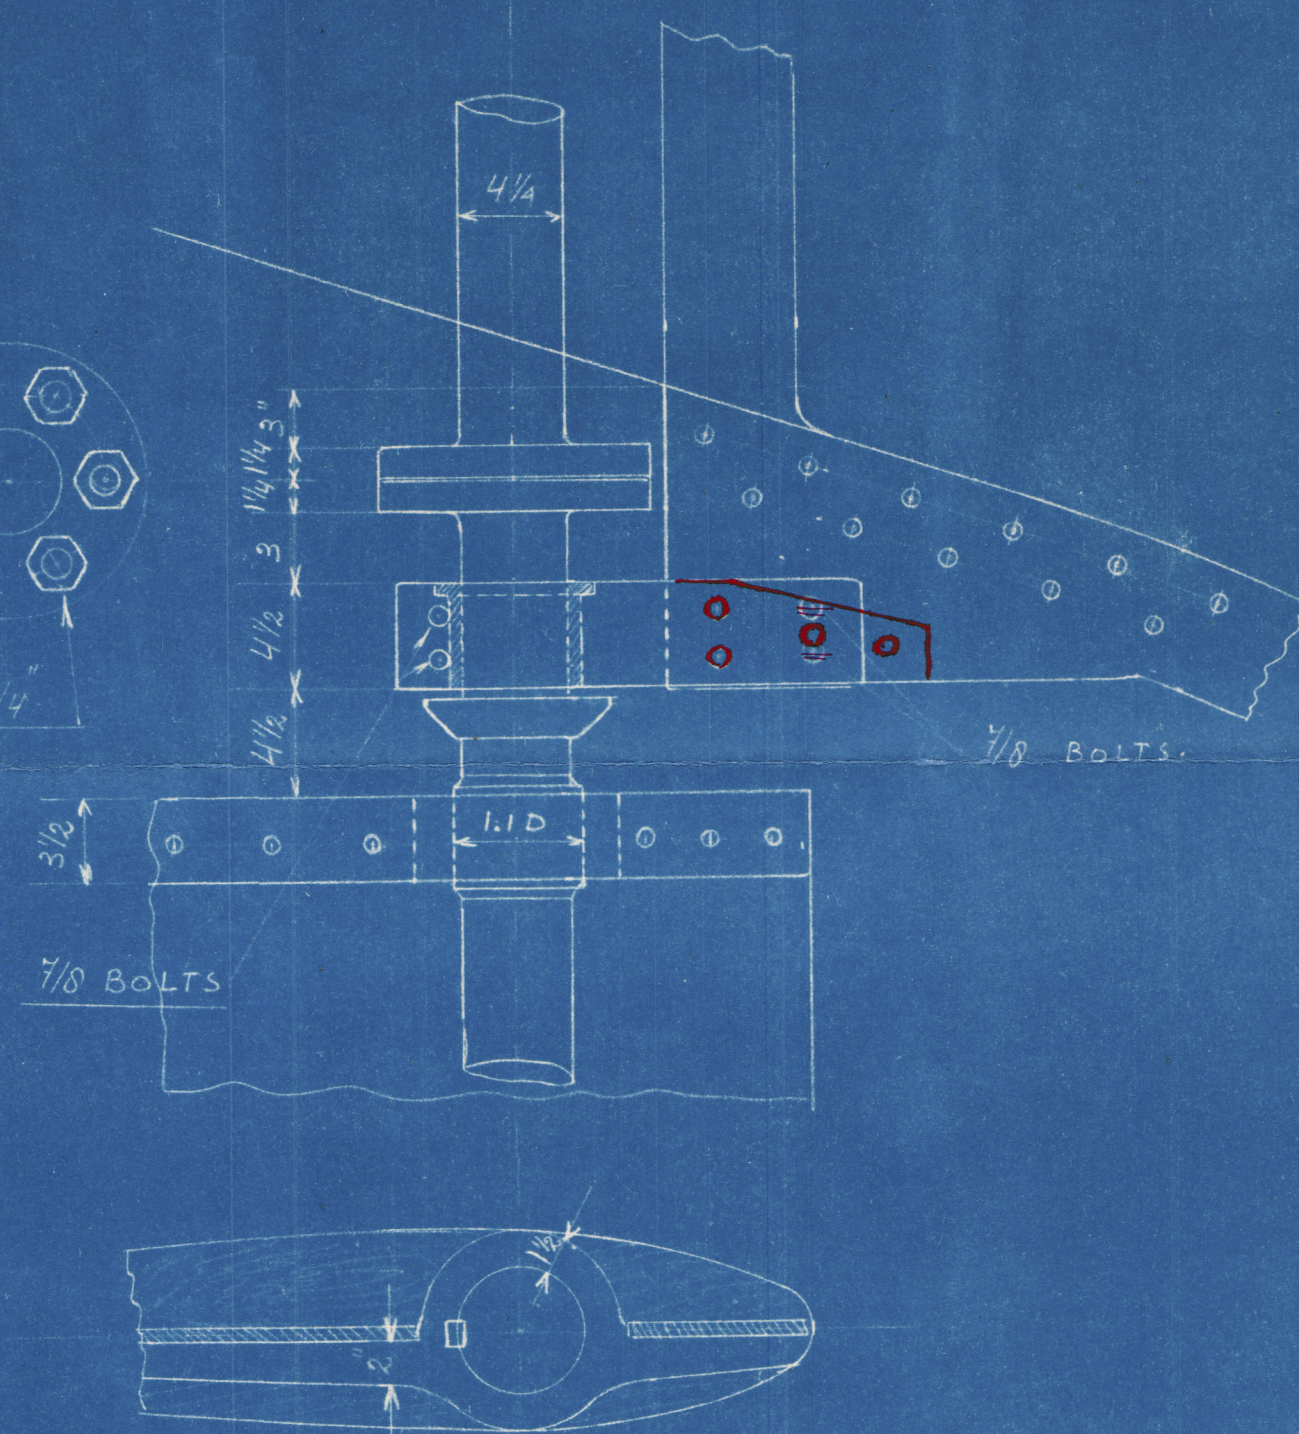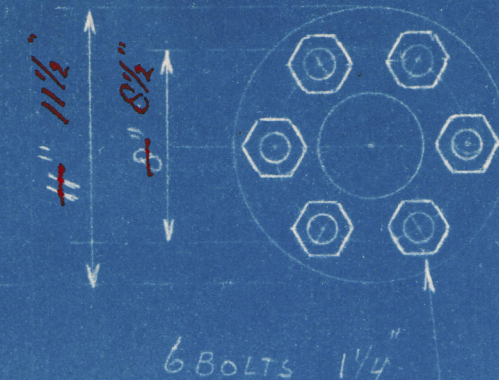

A. VUYK & SONS
SHIP BUILDERS
CAPELLE A/DYSSSEL
HOLLAND



3-5-34

1819

Lloyd's Register

008973-008981-008992

~~120~~

M/V KERLOGUE

A. VUYK & ZONEN

642

STERN FRAME & RUDDER.

2

008973-008981-0002

A. VUYK & ZONEN

YARD No 642

PLAN OF STERN FRAME & RUDDER

FOR

M/V. "KERLOGUE"



© 2021

Lloyd's Register
Foundation