


NO 173-5  
MAIN ENGINE GIRDER

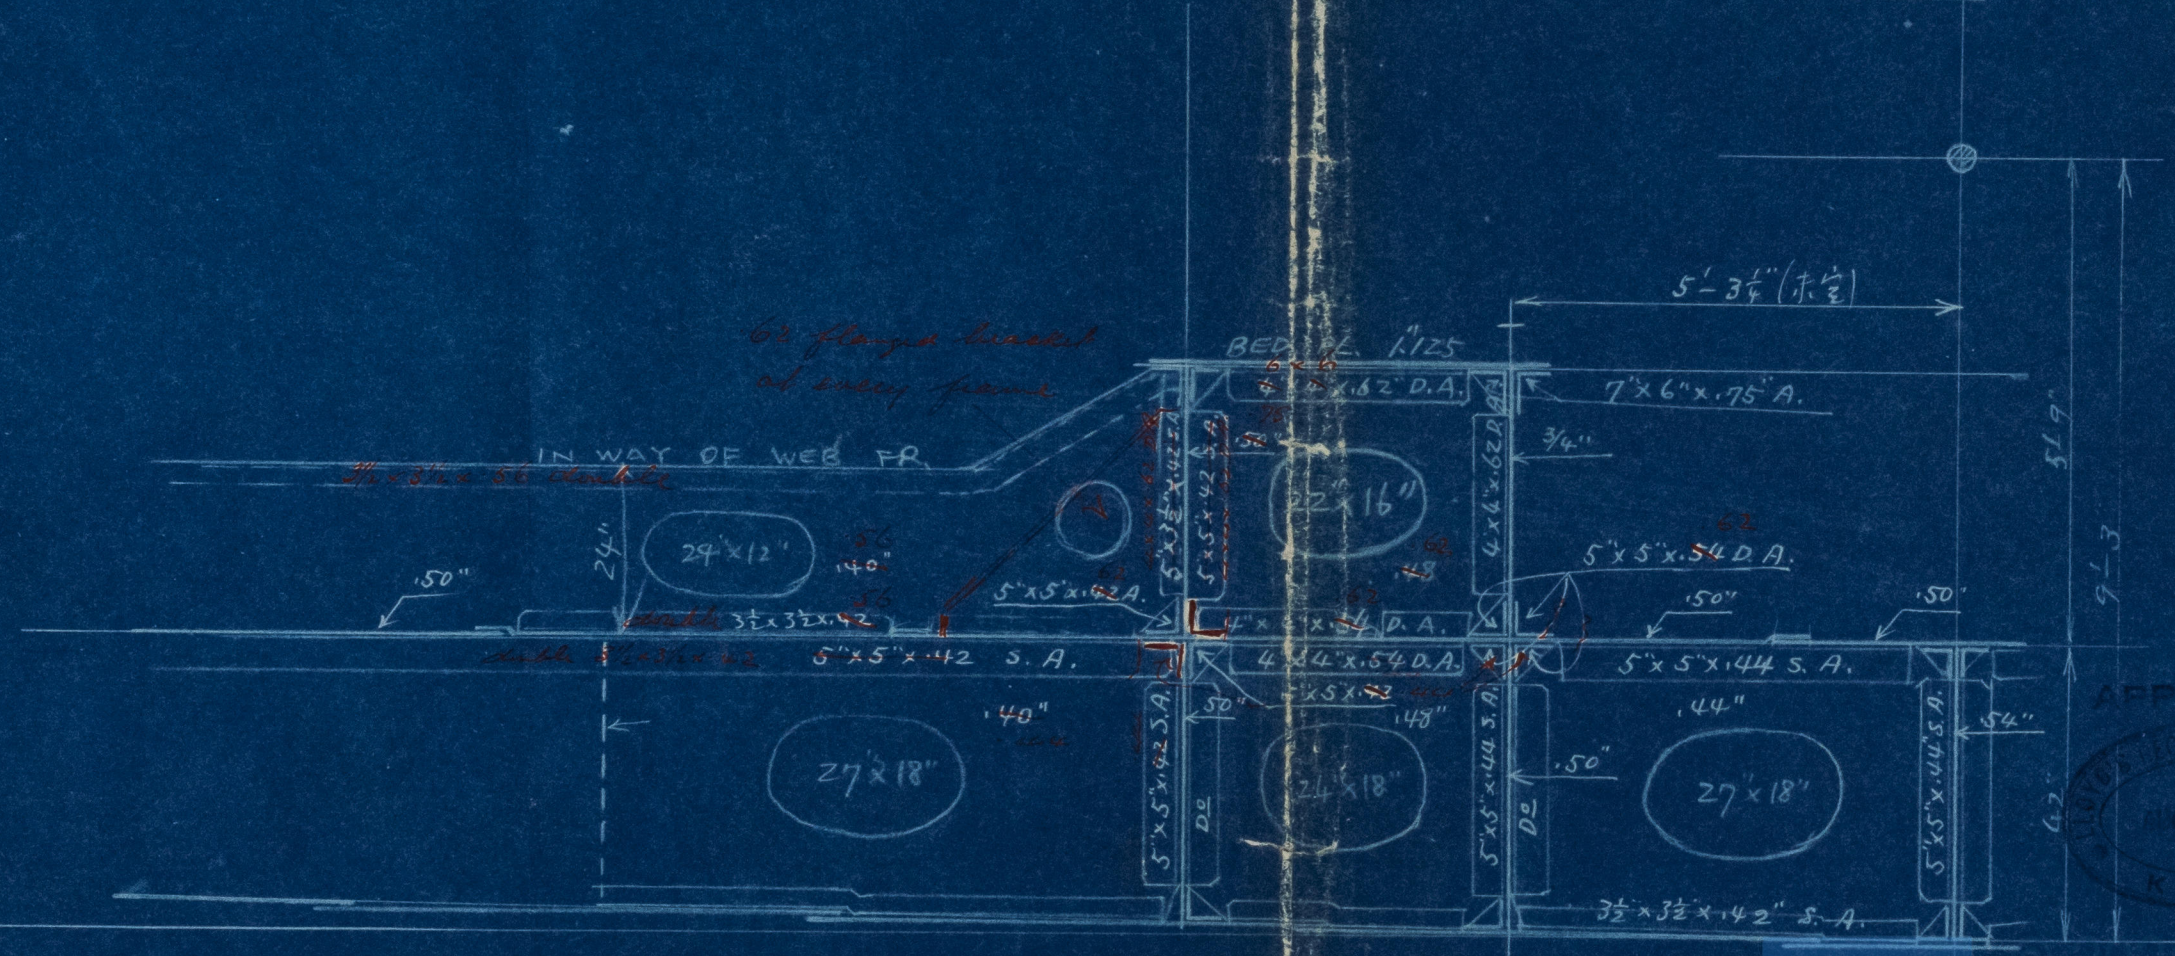

APPROVED  
MIG 221228  
KOBEL



008973-0024181-002

Lloyd's Register  
Foundation