

# NOTE

PROPOSED: TO RESET AND USE EXISTING FRAMES,  
TO RESET AND USE EXISTING SHELL PLATES  
IF POSSIBLE, TO CUT AND RESET EXISTING  
STEM BAR AS SHOWN, TO RENEW FLOORS  
IN WAY OF ALTERATION.

*The existing holes in frames & skin  
to be electrically welded and all work  
to be carried out to the satisfaction  
of the Society Surveyors.*

APPROVED  
H. Bennett Esq.  
May 16 1946.  
Manager, Lloyd's Register of Shipping  
London.

GEO. T. DAVIES & SONS LTD.  
MARINE ENGINEERS

ALTERATION TO STEM BAR  
"CITÉ DE QUEBEC"  
"CITÉ DE LEVIS"




1/4" = 1 Foot

13-5-46

"Cité de Québec"

Intl. Rpt. 6905-

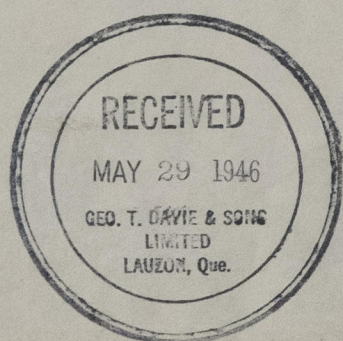

© 2020

Lloyd's Register  
Foundation