

22-11-23


# N<sup>o</sup> 670. STERNFRAME & RUDDER

SCALE 1"=1 FOOT.

STERNFRAME & RUDDER OF FORGED IRON OR STEEL  
TO PASS LLOYDS TESTS.

AREA = 34.9647 SQ. FT. C.G. AFT 4 OF PINTLES = 2.066 FT.

A x D = 72.23 SPEED - 9 1/2 KNOTS AT SEA.

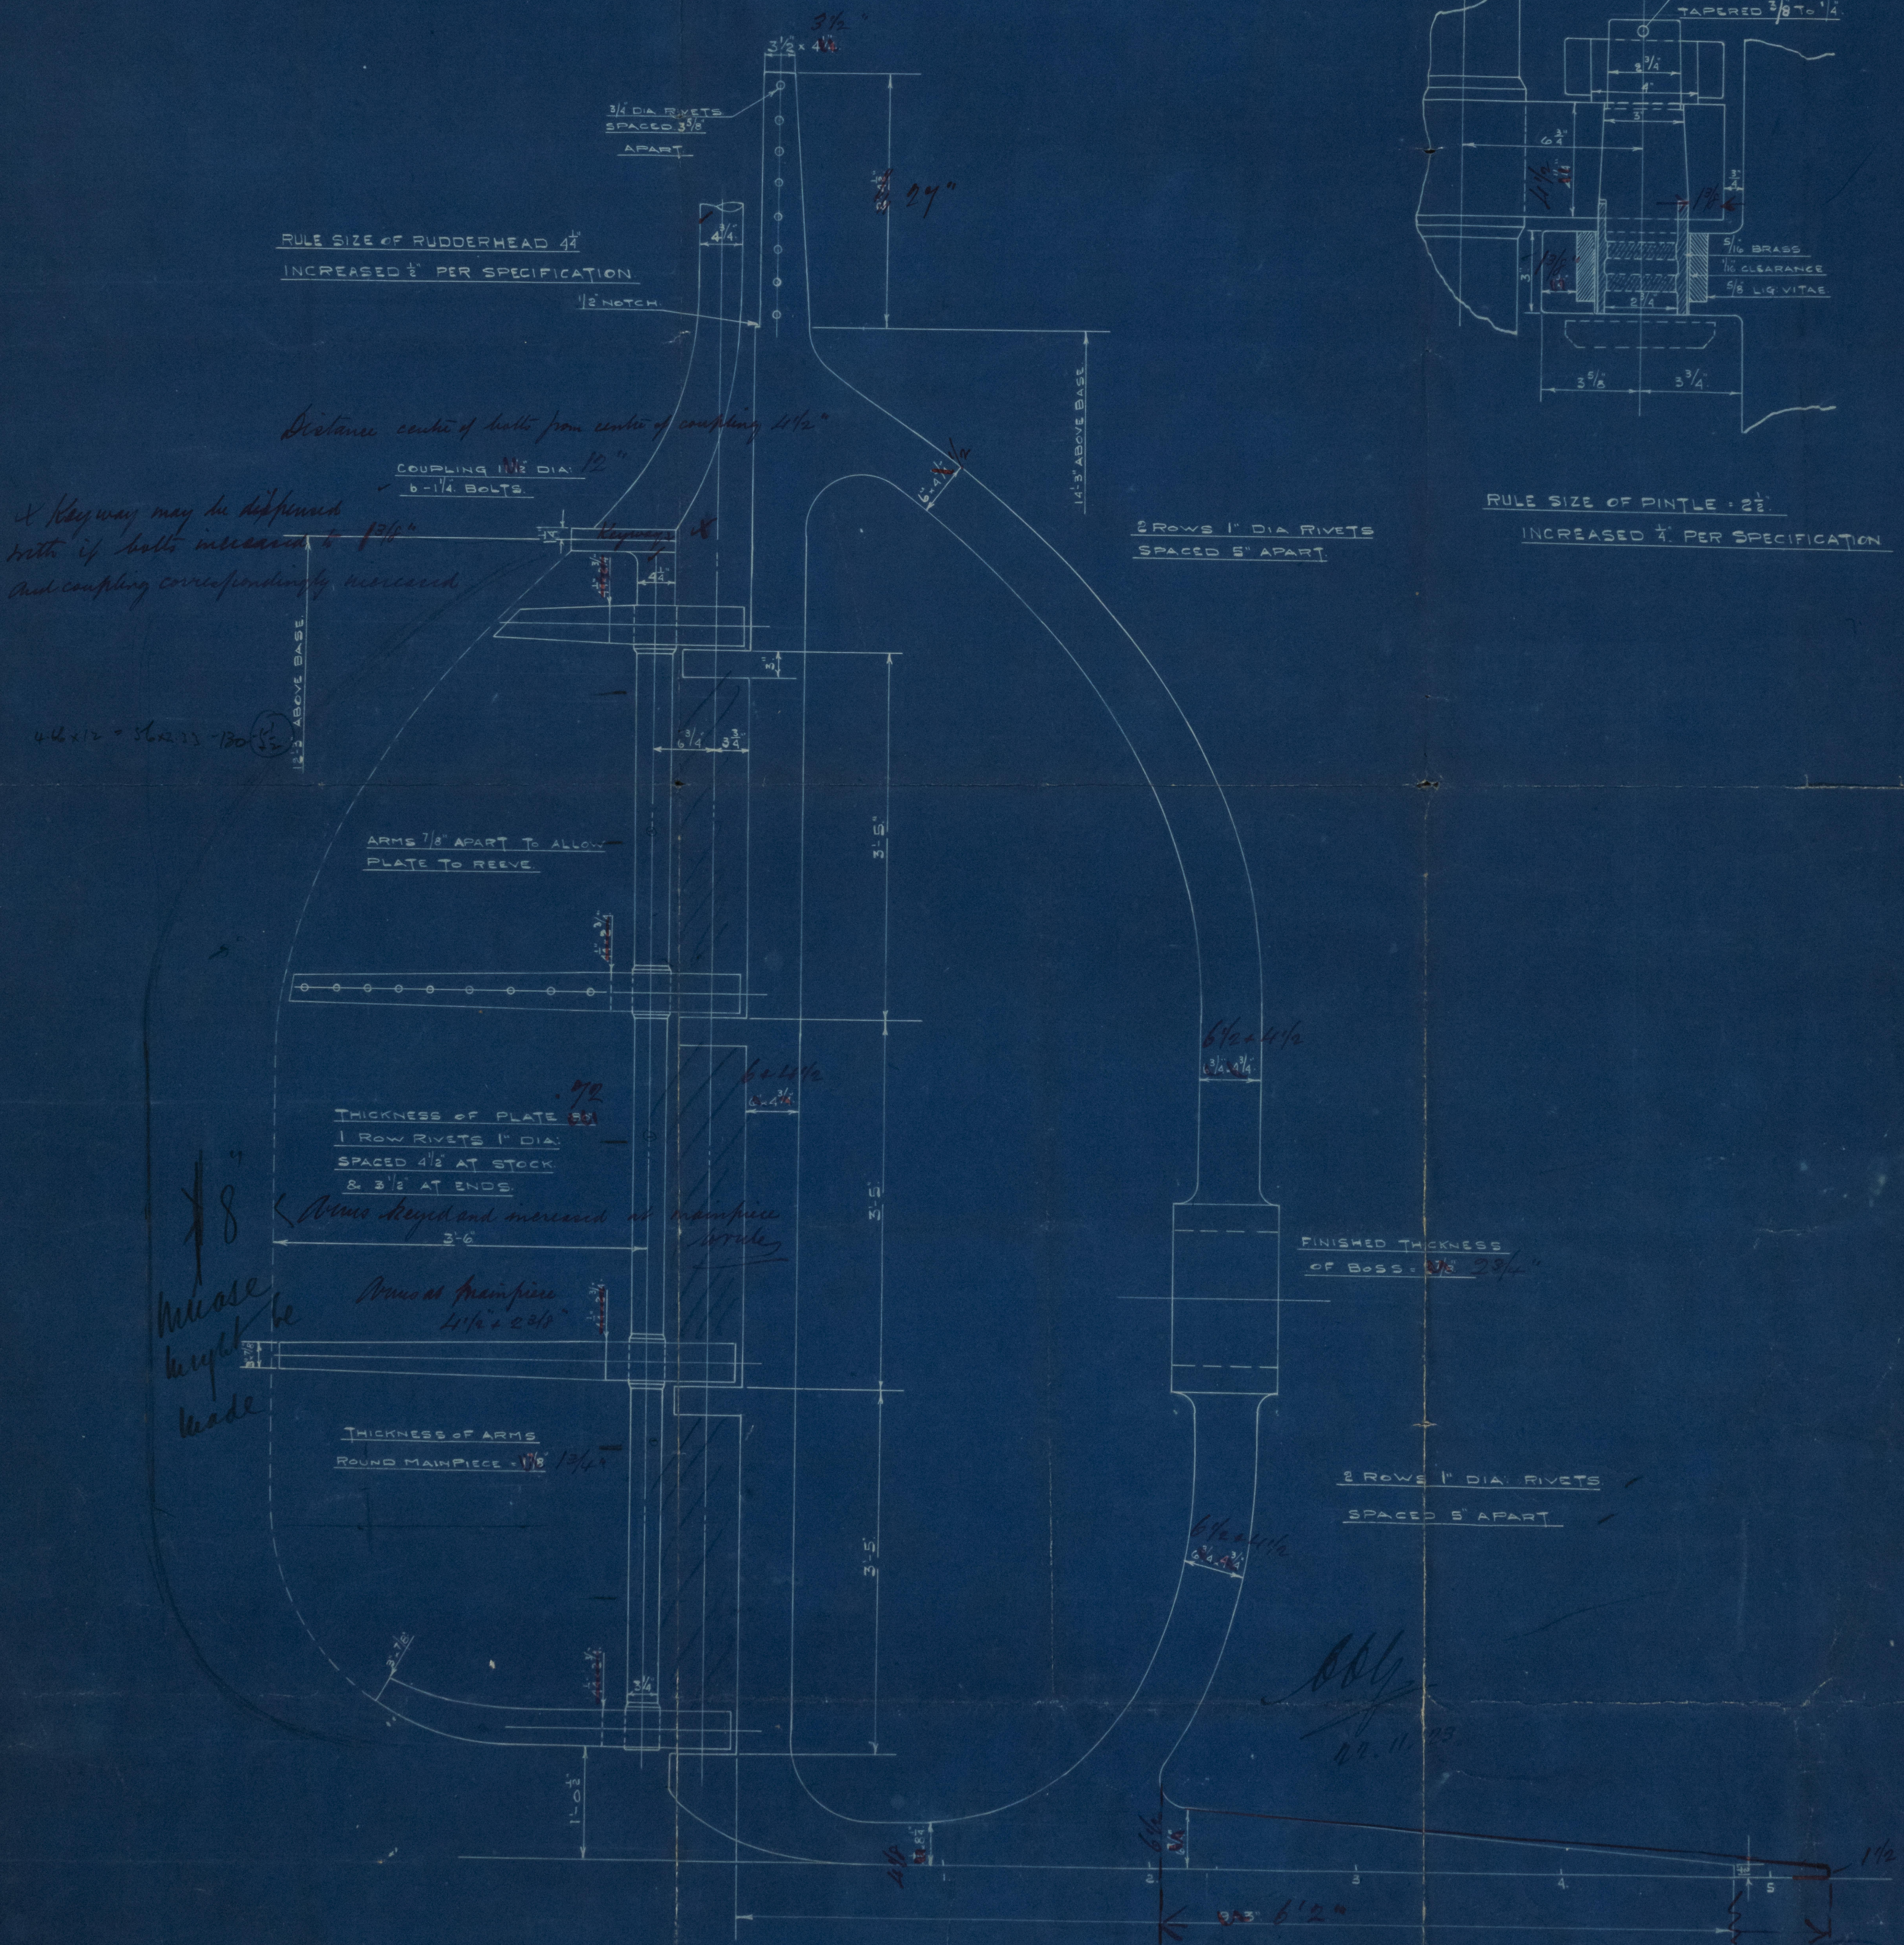




6-1

3-5-8

u  
Sunflower.

PLYMOUTH

Messrs. Philip & Son, Ltd.,

Dartmouth

S.S. No 670

Stern Frame & Rudder.



© 2020

Lloyd's Register  
Foundation

008193-009003-0295



008993 - 009003 - 0295



© 2020

Lloyd's Register  
Foundation