


S.S. "ATHELTARN" MAIN DECK (FORE)

SCALE 1/4" = 1'-0"

ALTERATIONS SHEWN IN RED.

NOTE:- NO COMPENSATIONS FOR NEW CUTTING HOLES.

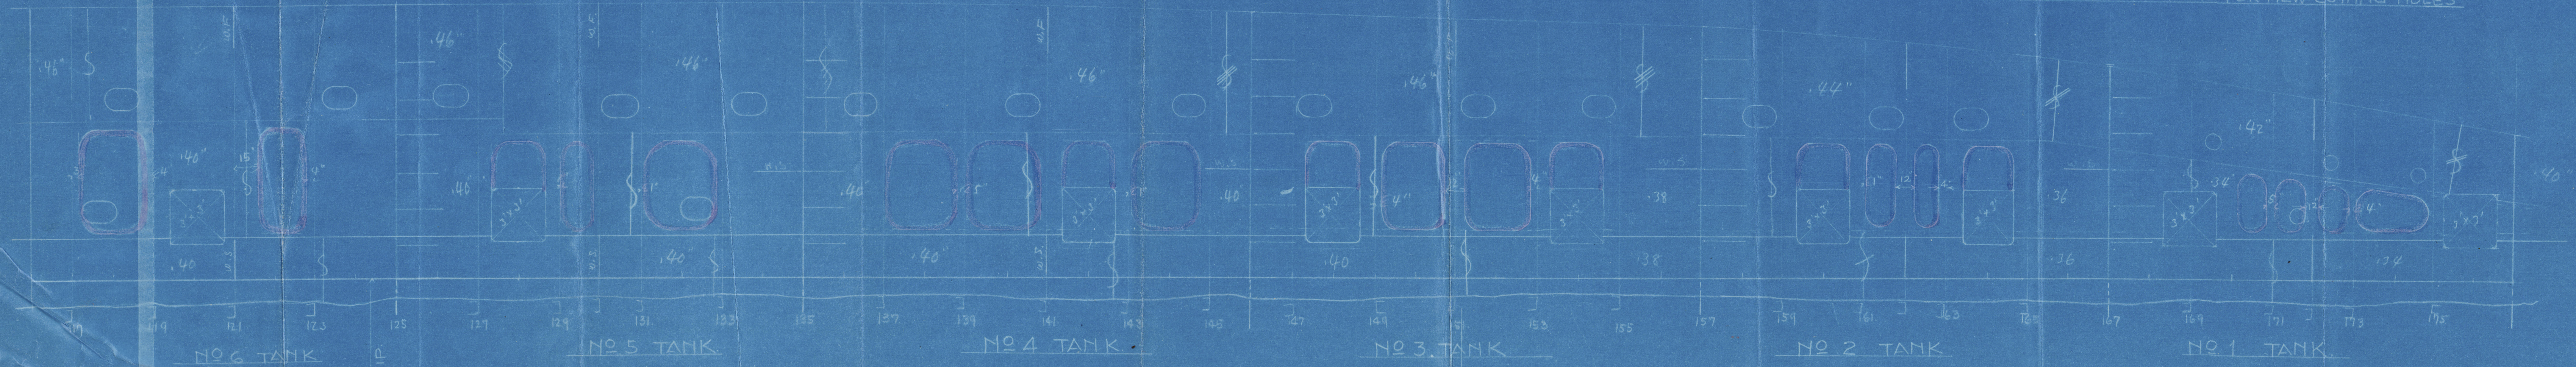


004604-004007-0070



© 2021

Lloyd's Register
Foundation