


# 55"ATHELTARN" TANK TOP PLATING (FORD)

SCALE 1/4" = 1'-0"

ALTERATIONS SHEWN IN RED

NOTE:—


PARTS MARKED THUS TO BE PATCHED WITH  
PLATE & COMPENSATED FOR LONG STRENGTH.

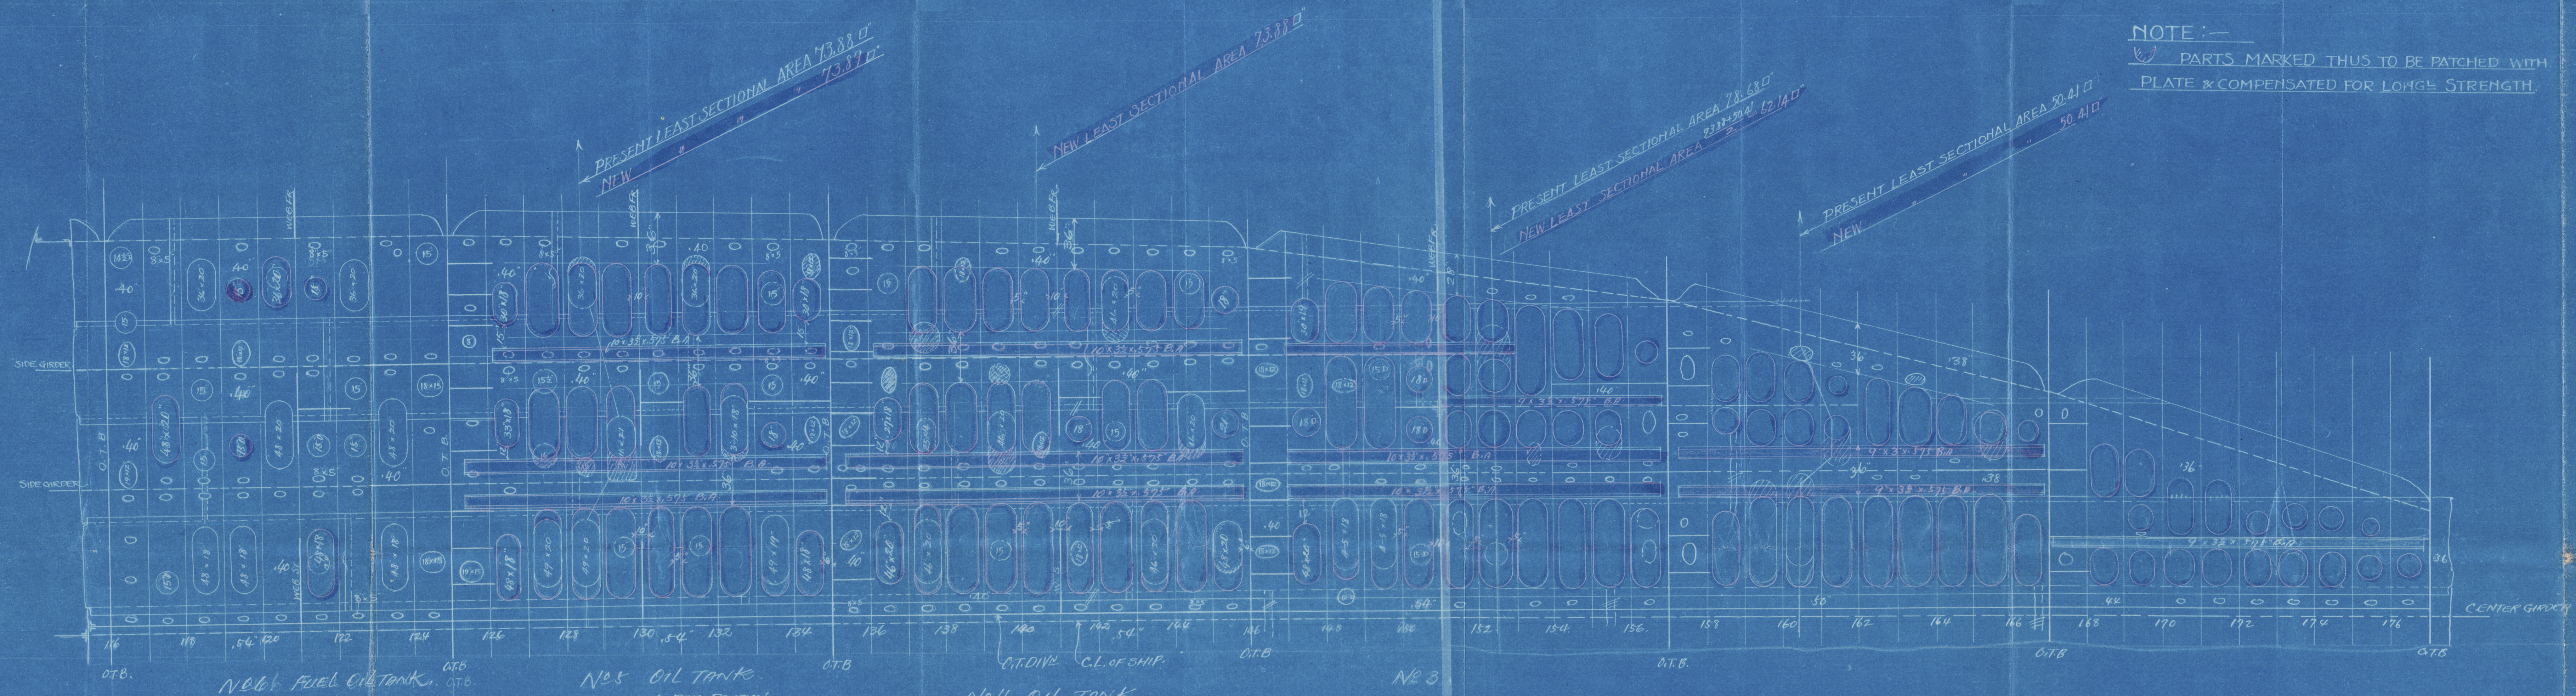

No. 1 FUEL OIL TANK

No. 2 OIL TANK  
TRANSVERSE SECTION,  
10 x 32 x 57.5 B.A.

No. 4 OIL TANK

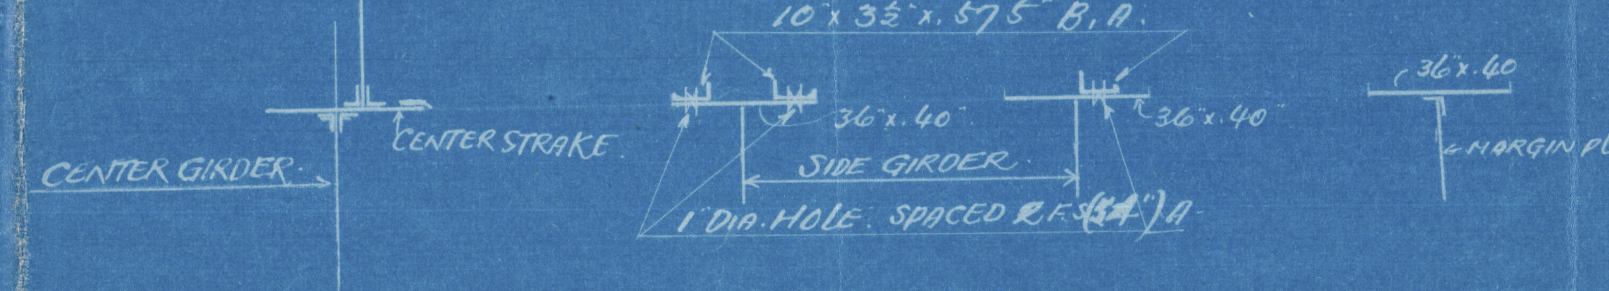

タンクトップ改造図  
(前部)

アセルトン 縮尺 1/4" = 1'-0"

DND R 201





009604-009007-0072

# タンクトップ改造圖

(前部)


アセルトーン  
縮尺四分の一

DND.R201.



御承認用

APPROVED

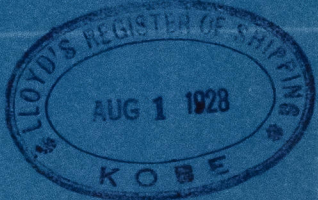

*Handwritten signature*

009004-009007-0072



© 2021

Lloyd's Register  
Foundation