



S.S. ATHELTARN.
NEW OT HATCHES ON NO 5
AND 7 OIL TANK.
SCALE 4" = 1'-0"
ALTERATIONS SHOWN IN RED

B-B
AIR TIGHT WALL


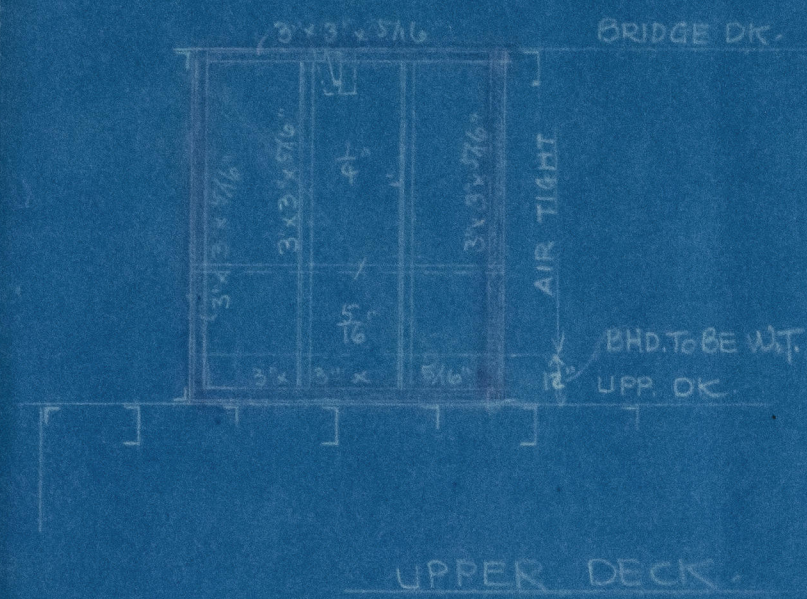


A-A
AIR TIGHT WALL

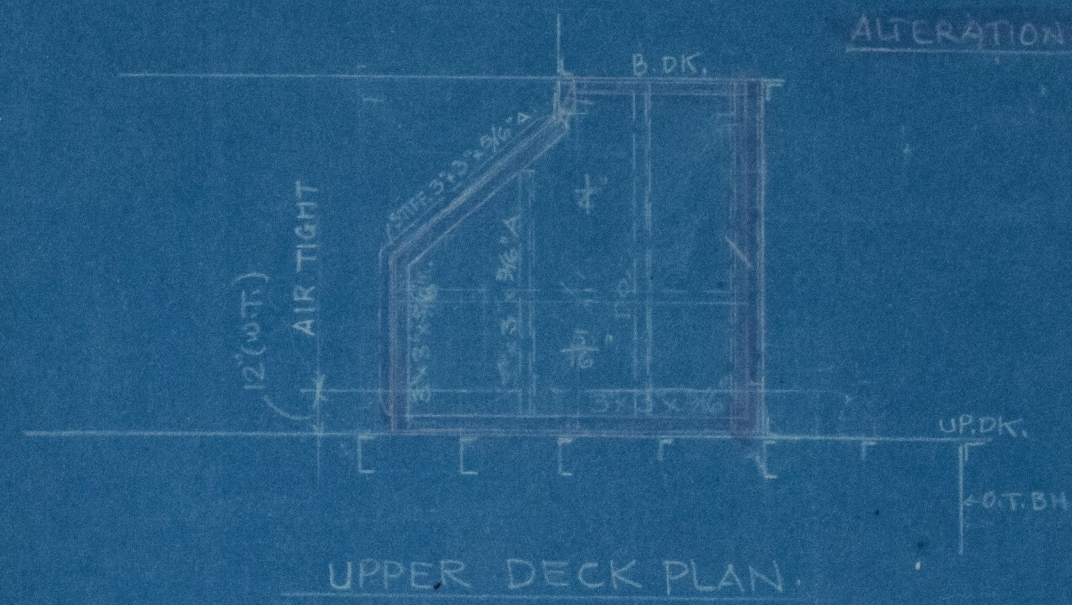


UPPER DECK


UPPER DECK PLAN

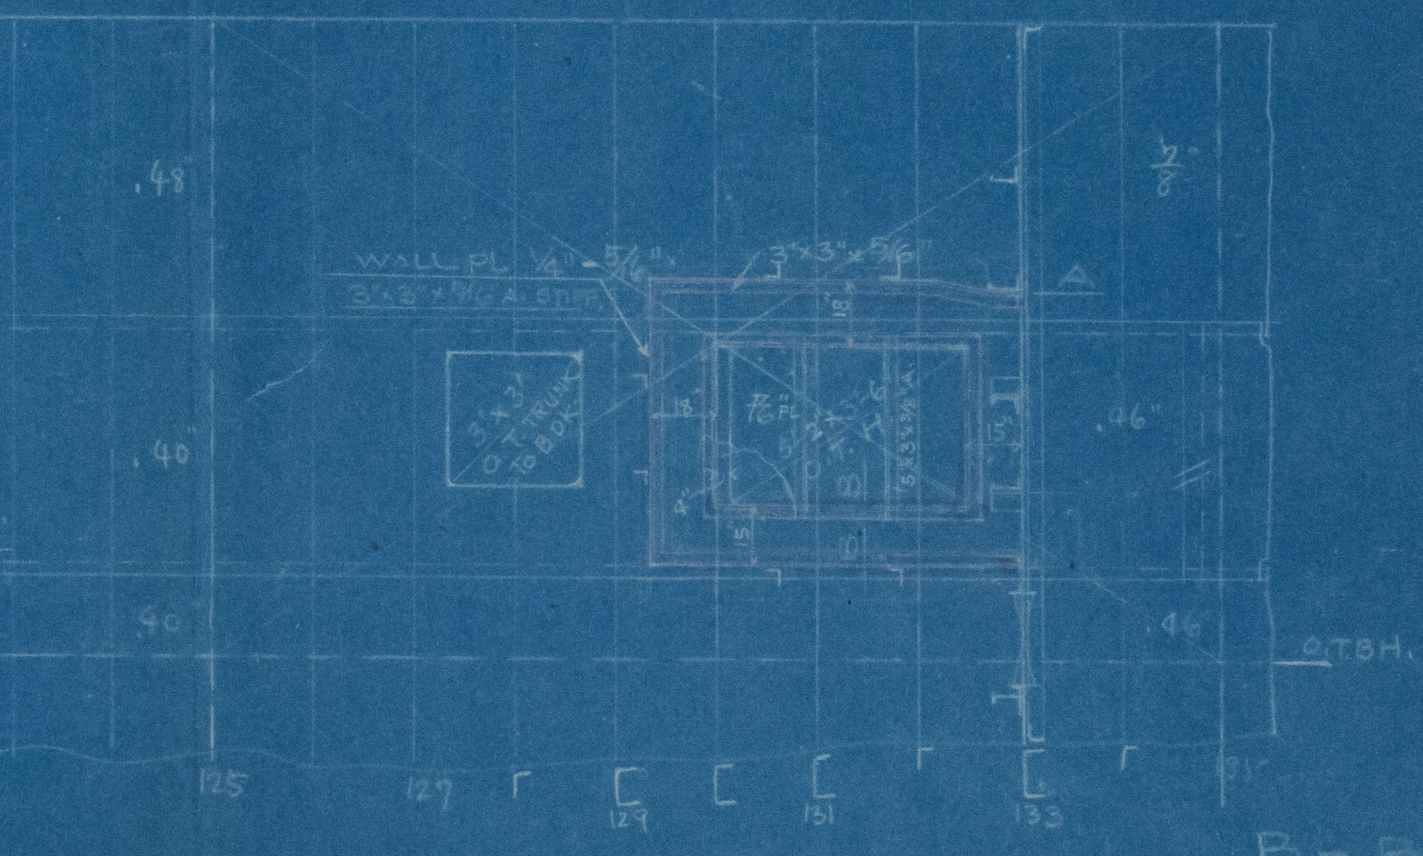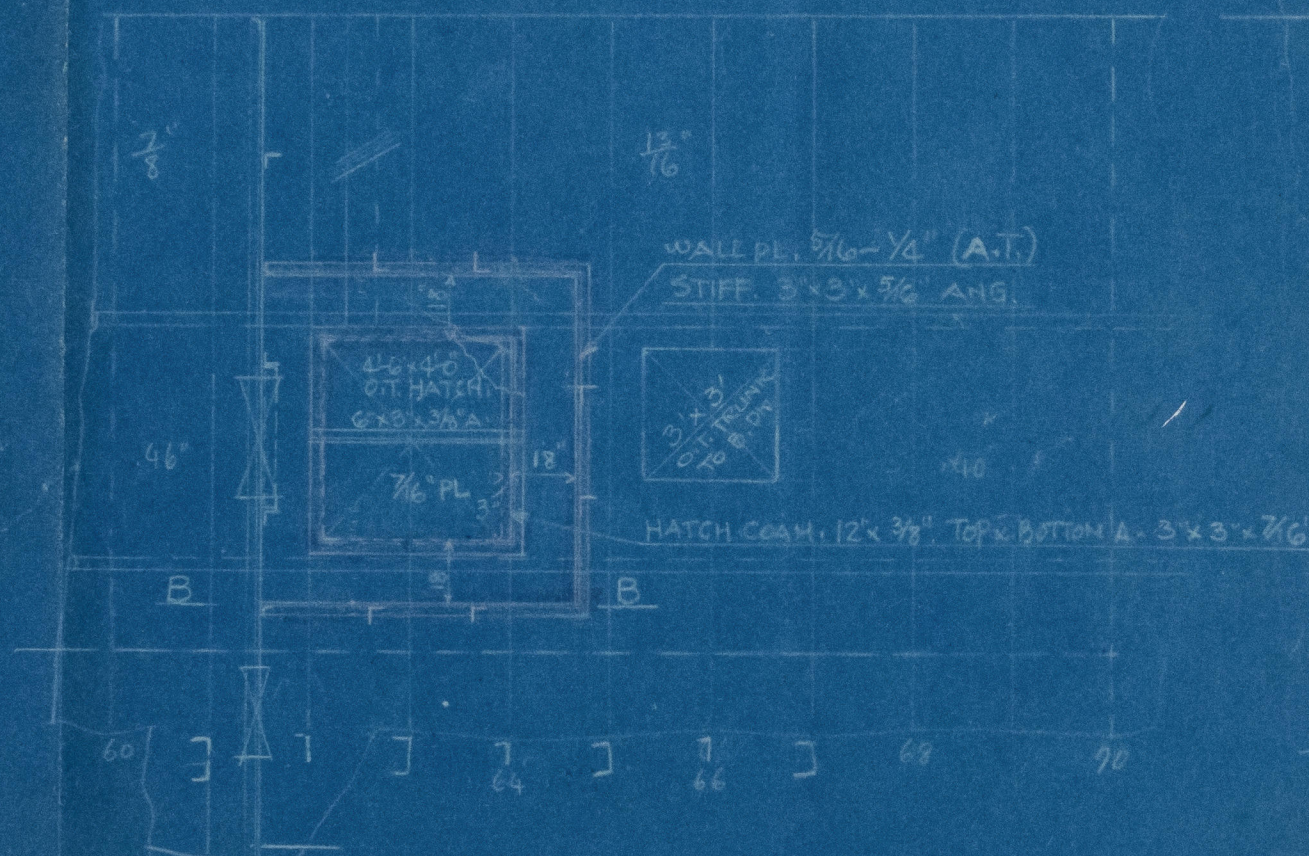


BRIDGE AFT END BHD
LOOKING AFT

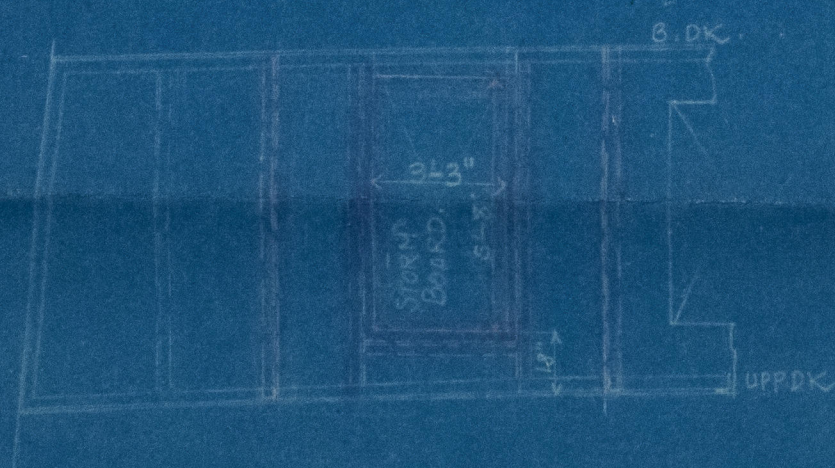

BRIDGE FRONT BHD
LOOKING AFT

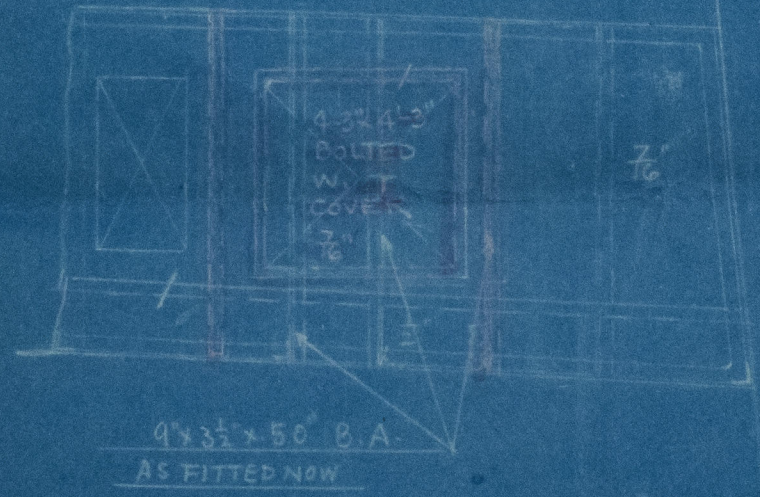

B-B

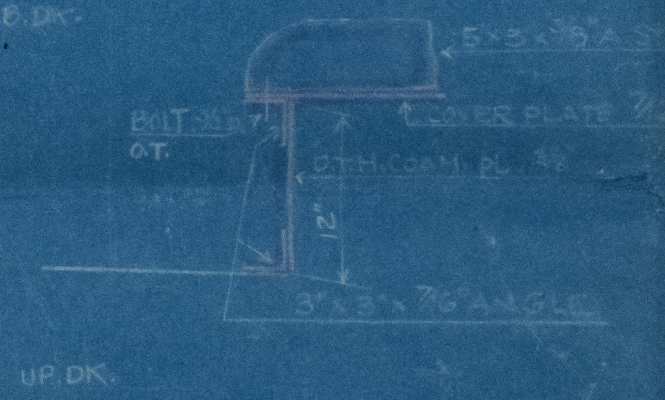

第五及七番油艙ハチ新設圖

アセルトーン 尺度四合ノ時ヲ以テス

Drawn R 203



御承認用


009004-009007-0073

第五及七番油艙ハ新設圖

アセルタイン 尺度四合ノ吋ヲ一呎トス

D No. R 203

御承認用

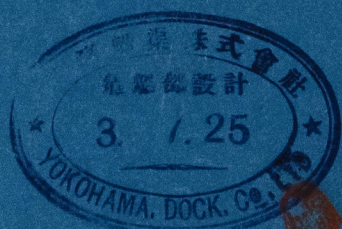

APPROVED



Handwritten signature



© 2021

Lloyd's Register
Foundation