



Shell plating.
船部外板

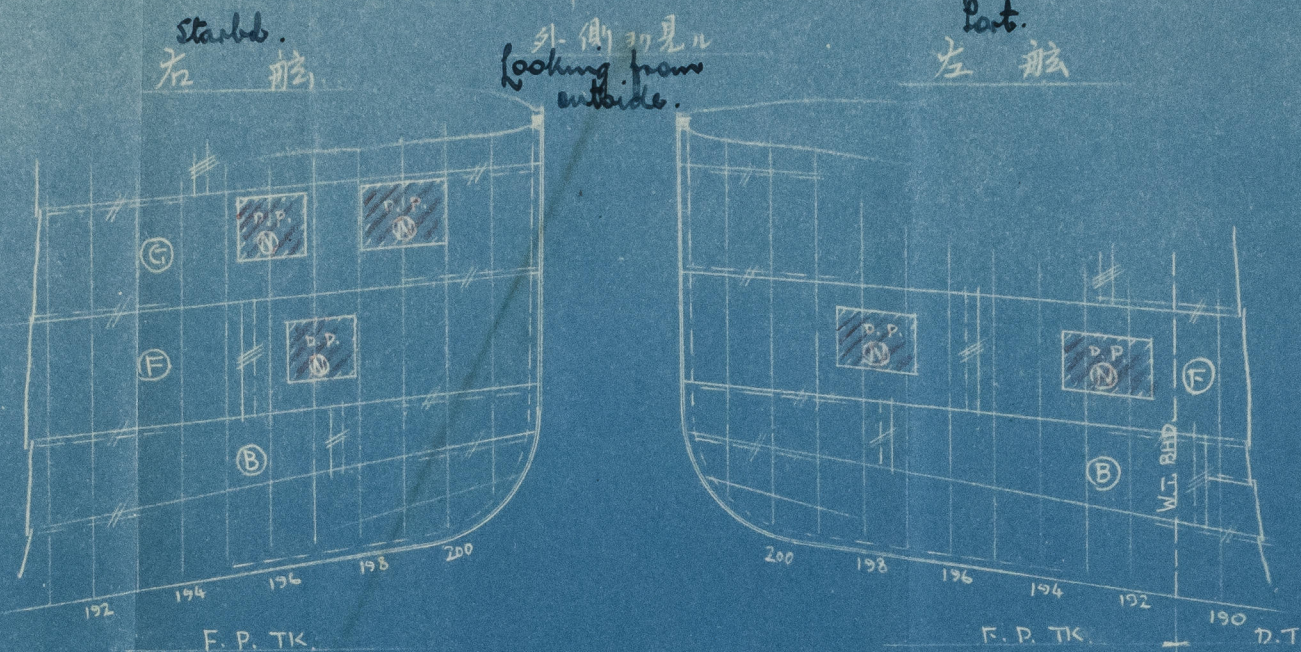

修理記号
印ハ新設ヲ示ス

Double in way of sea connection.
海水弁附近補強圖

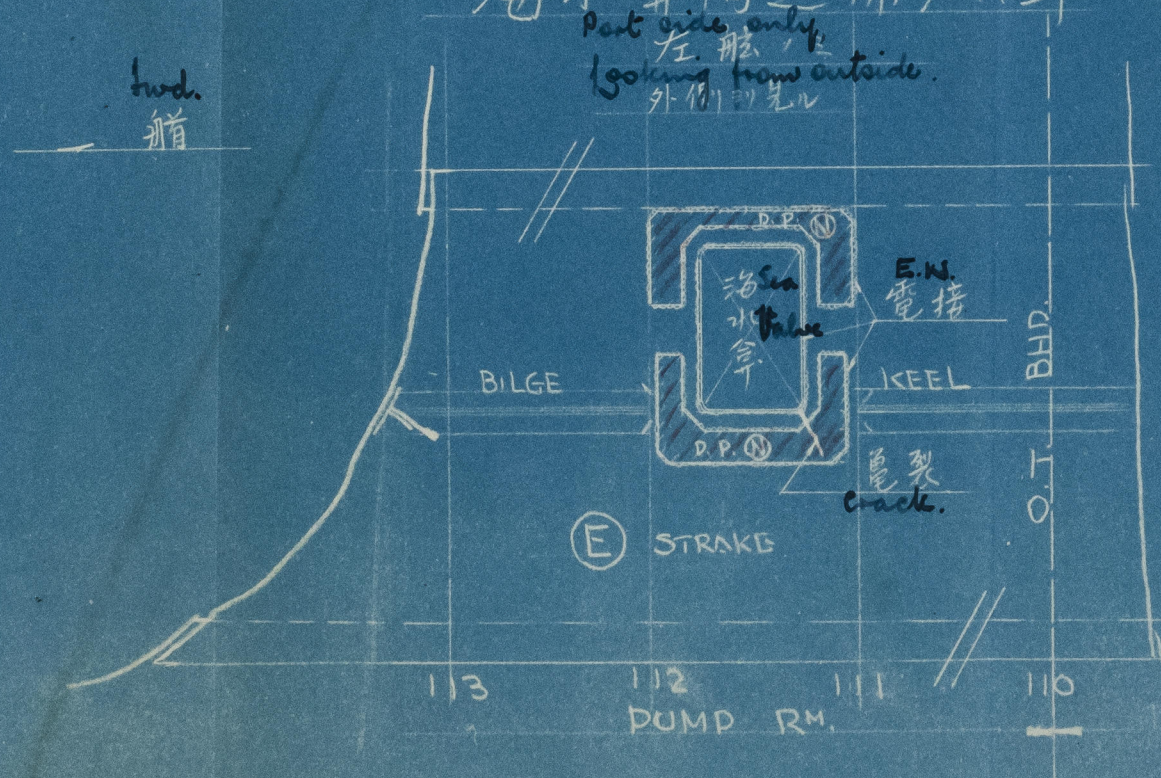

To accompany Yokohama
Report No. 6915.

"Zuiyo Maru"

R. No. 1448

外板修理圖
瑞洋丸
Zuiyo Maru

SCALE	DATE
$\frac{1}{2"}, \frac{1}{8}" = 1'-0"$	APR. 25 TH 1940
DRAWING NO.	



"Zuiyo Maru"

Vka. 6905

Repair Plan.

067604-009007-0068



© 2021

Lloyd's Register
Foundation