


25.8.11

17.1.12

GENERAL ARRANGEMENT OF A TOWING LIGHTER


DIMENSIONS

LENGTH	115' 0" BP
BREADTH	22' 0" MLD
DEPTH	10' 6" MLD
SHEER FORE & AFT	3' 0"
SCALE	$\frac{1}{4}$ " = 1 FOOT.

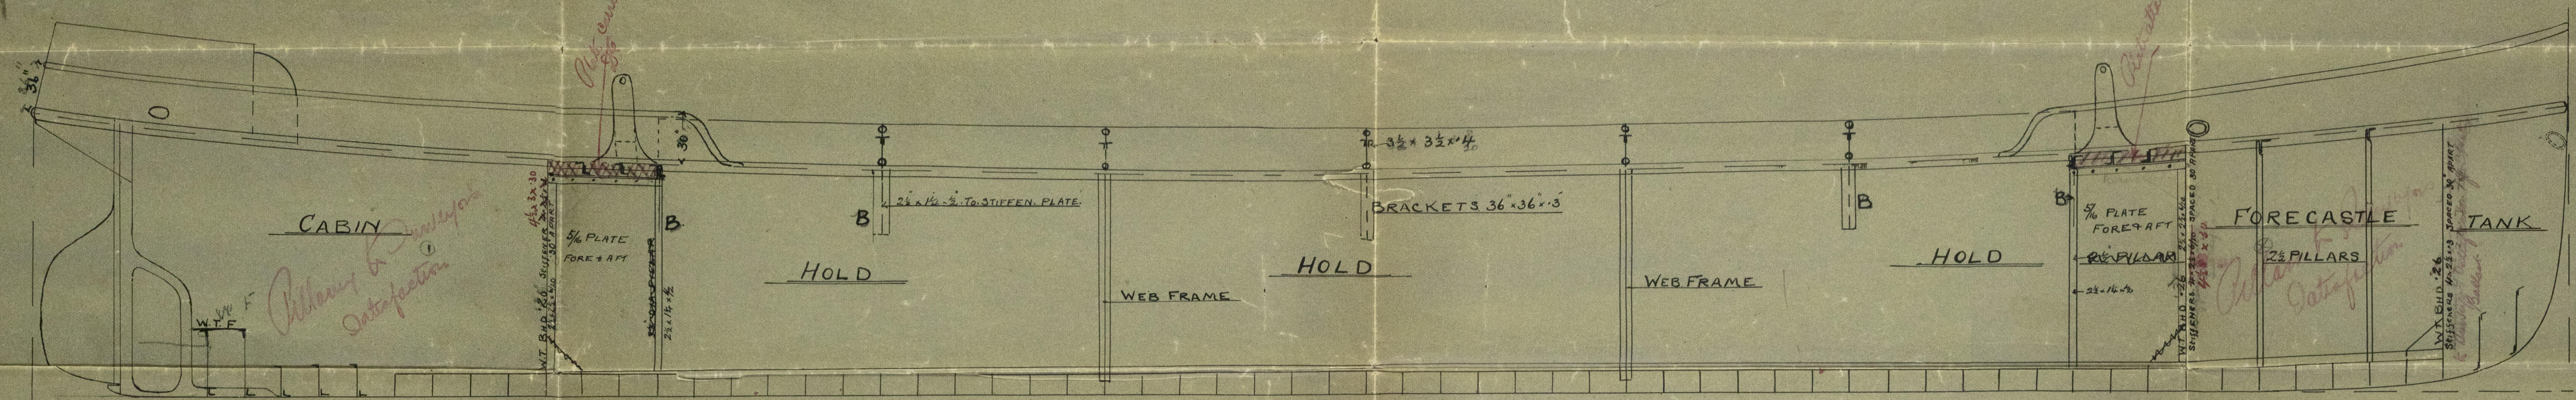

115' 0"


120' 0"

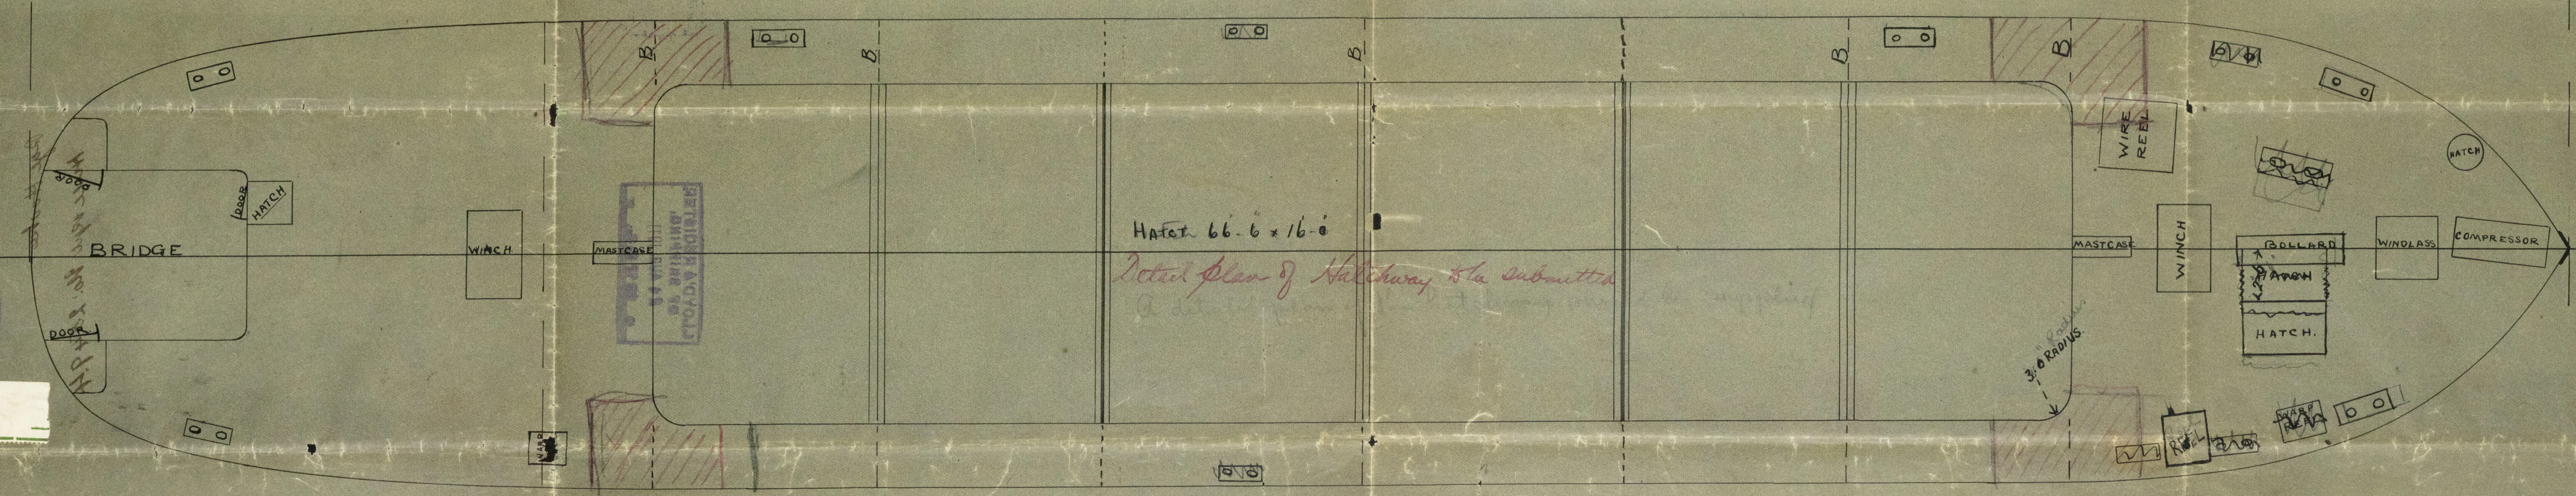

C7  
25.8.11



J. Scarff & Son  
Profile Deck Glass  
115 Ful - 13-11-12  
No. 268.

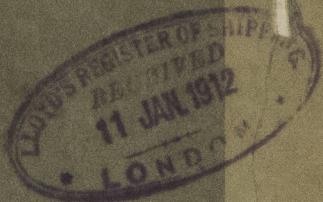


Page Hooke

Hull reg No: 2549.4

BRIDGE

HATCH

00

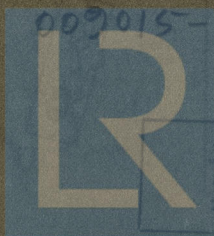

002015-002020-0073

Lloyd's Register  
Foundation