

25.8.11

12.1.12

MIDSHIP SECTION OF A STEEL TOWING LIGHTER No. 268.


DIMENSIONS

LENGTH	115' 0" BP
BREADTH	22' 0" MLD
DEPTH	10' 6"
SHEER FORE & AFT	3' 0"
SCALE	$\frac{1}{2}$ " = 1 FOOT

NUMERALS

BREADTH	22' 0"
DEPTH	10' 6"
1ST NO.	32' 5"
LENGTH	115' 0"
	3737' 5" 2ND NO.

Detail sketch of Hatch arrangements.

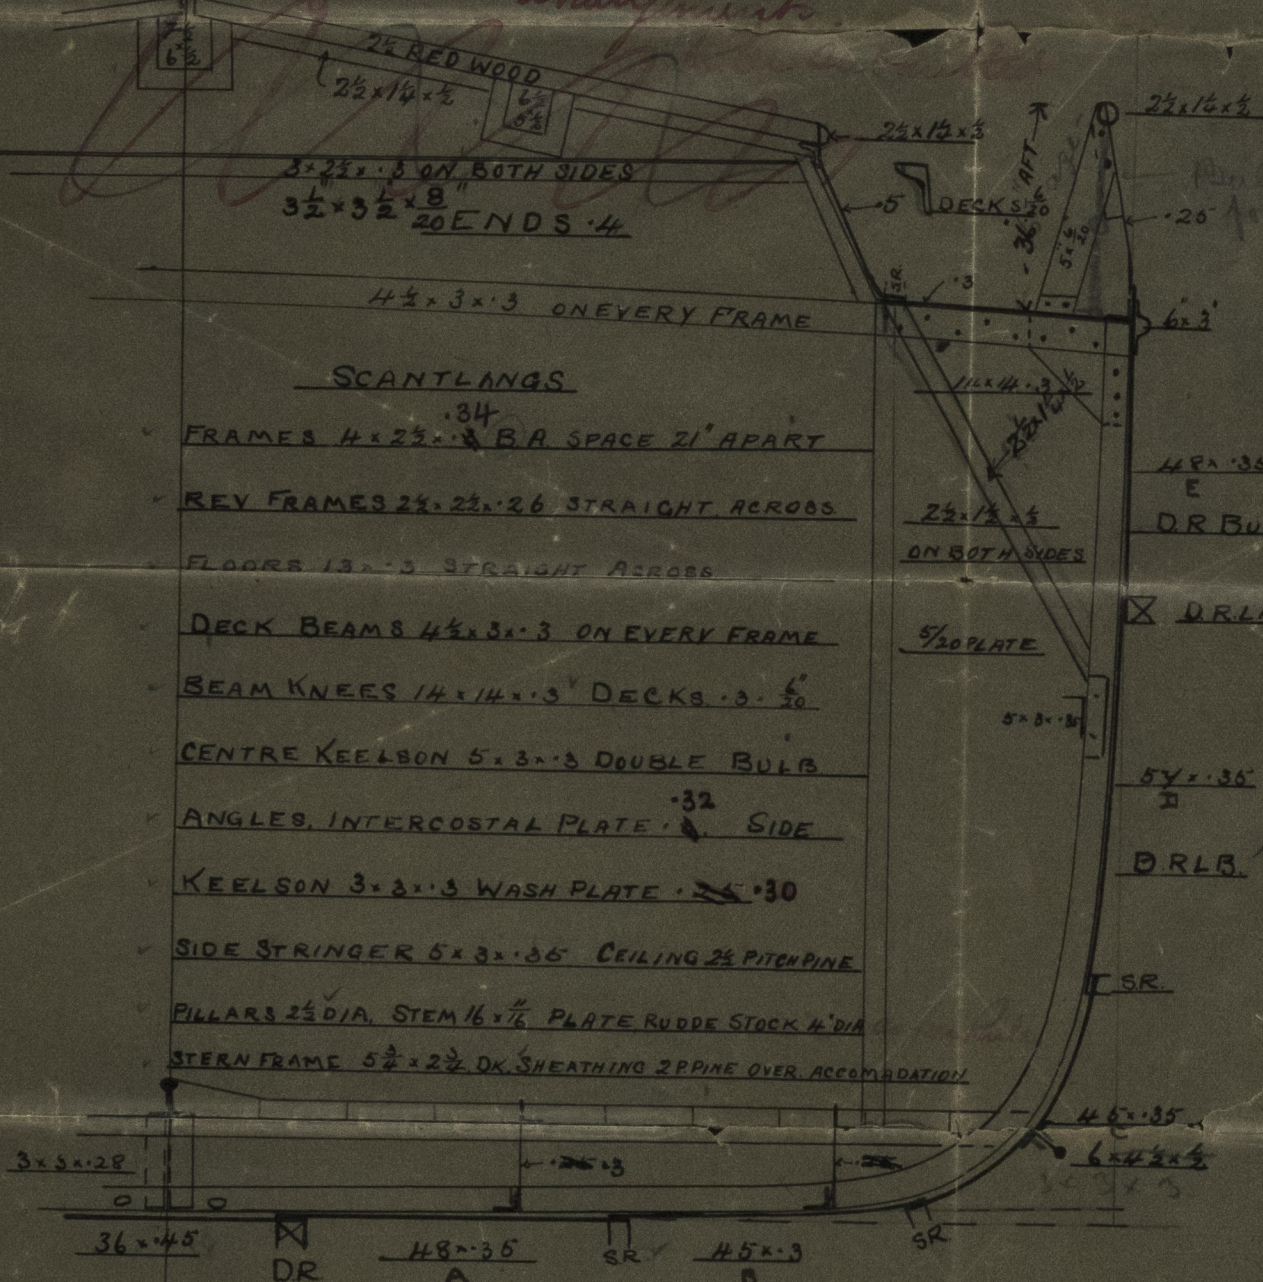

EQUIPMENT No. 3737


TWO 64 CWT STOCKLEES ANCHORS
ONE 1 1/4" KEDGE
ONE 3/4" STREAM
165 FATHOMS 1/2" STUD CHAIN CABLE
45 " 2" CIR WIRE
75 " 6 HEMP
90 " 4" HAWSERS

PROPORTIONS

LENGTH TO BREADTH	5.24
LENGTH TO DEPTH	10.84

C.F.

25.8.11

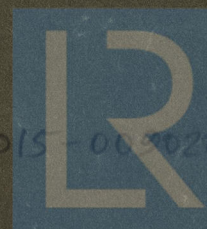

© 2020

009015-000020-0075 Lloyd's Register Foundation



Mull Rpt No: 25494

~~Lloyd's Register~~
Foundation