

Nº 214 S




Sunderland  
SBC.

No 214

“  
SS Monmouthshire”

Sunderland. No. 21105  
Midship Section  
as built.

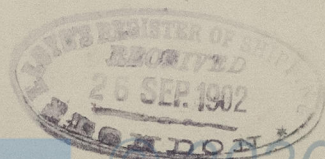

© 2020

Lloyd's Register  
Foundation

009030-009039-0319